

PERMIT NO.

CITY OF NEW BEDFORD

DATE 1/29/03

23325



SEWER AND/OR STORM DRAIN PERMIT

This certifies that permission is granted to

Property Owner: LORRAINE VAUGHAN Address: 298 CUSHMAN RD. ROCHESTER MA. 02770 Tel. (508) 763-5378

to connect a sewer and/or storm drain located at HAWES ST # 396
 Assessor's Plot 127A, Lot 175 & 176, to the sewer and/or storm drain in HAWES ST. Street
 to be laid in accordance with the conditions in this application and the City of New Bedford ordinances.

TYPE OF USE: ☒ RESIDENTIAL ☐ COMMERCIAL ☐ INDUSTRIAL ☐ OTHER

330 GPD

If applicant other than actual property owner, attach Letter of Authorization from Property Owner.

Name: _____ Tel. _____

Mailing Address: _____

The Bonded Contractor/Drain Layer authorized to perform this work is:

Name: TBCI CANESSA Address: _____ Tel. _____

Type of Pipe Required: LOW PRESSURE LINE & PUMP SYSTEM

PERMIT EXPIRES ONE YEAR AFTER DATE OF ISSUE

- * Requires separate connections for sewage and storm drain where applicable. Storm water cannot be discharged to a sanitary sewer.
- * All work must be inspected and approved by a D.P.W. inspector before backfilling.
- * If this connection is to be part of a private service shared jointly with other building owners, attach copy of Recorded Joint Maintenance Agreement.
- * Permits can be issued to Industrial and/or Commercial Applicants only upon receipt and approval by the Commissioner of Public Works of required plans and supplemental information.
- * In addition, a City-issued Industrial User Discharge Permit and/or a Sewer Extension/Connection Permit issued by the Commonwealth of Massachusetts D.E.P. shall be required by the City for Industrial Discharge into the sewer system.

Industrial User Discharge Permit No. _____ Date: _____

Comm. Mass. Sewer Conn./Ext. Permit No. _____ Date: _____

A Filing and Inspection Fee of \$150.00 plus an Entrance Fee of \$_____ where applicable, must accompany this application.

Bank # SOVEREIGN BANK Check # 284 Date: 1-29-03 Receipt # 4508

Other requirements: Inspection Only - To be done after approval plan. Owner/contractor must contact Health Dept. Re: Siphon system abandonment application.

☒ Sewer

* CURB STOP TO BE IN SIDEWALK

Connection made to Part of jointly-shared private line ☐ Yes ☒ No

☐ Storm Drain

Applicant agrees to abide by the above terms, as well as all pertinent ordinances of the City of New Bedford, and such other special rules as the Commissioner of Public Works may deem necessary

Commissioner of Public Works

Signature of Property Owner or Representative

INSPECTOR'S REPORT

INSPECTED BY: KEVIN CORNELL

DATE: 8/5/2003

COMMENTS: CANESSA WAS INFORMED THAT SAND SHOULD HAVE BEEN USED IN TRENCH.

IF TRENCH FAILS - CANESSA WILL BE LIABLE.


ALSO - WATER MARKER WAS USED ON

CURB STOP CLEANOUT.

☒ APPROVED ☐ DISAPPROVED

Signature: Kevin J. Cornell

SIGNATURE

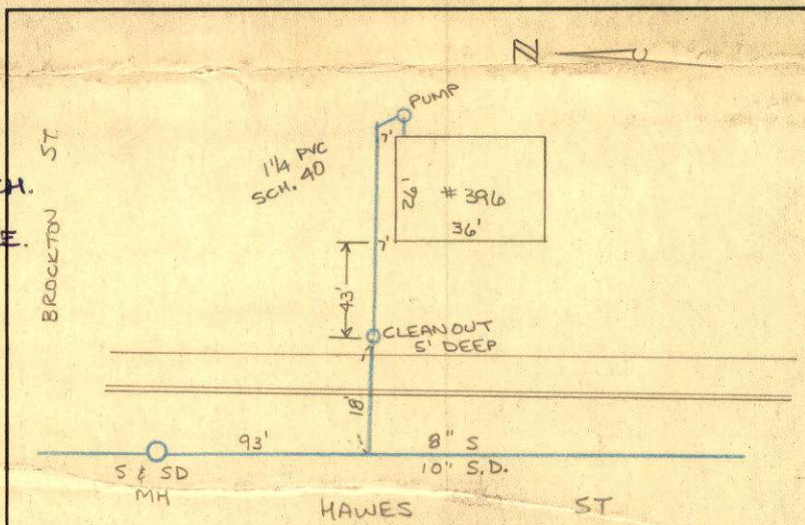

SKETCH PLAN

PERMIT NO.
23325



CITY OF NEW BEDFORD

DATE 1/29/03

SEWER AND/OR STORM DRAIN PERMIT

This certifies that permission is granted to
LORRAINE VAUGHAN 298 CUSHMAN RD. ROCHESTER MA. 02770
Property Owner Address Tel. (508) 763-5378

to connect a sewer and/or storm drain located at HAWES ST # 396
Assessor's Plot 127A, Lot 175 & 176 to the sewer and/or storm drain in HAWES ST. Street
190 & 191
to be laid in accordance with the conditions in this application and the City of New Bedford ordinances.

TYPE OF USE: ☒ RESIDENTIAL ☐ COMMERICAL ☐ INDUSTRIAL ☐ OTHER 330 GPD

If applicant other than actual property owner, attach Letter of Authorization from Property Owner.
Name _____ Tel. _____
Mailing Address _____

The Bonded Contractor/Drain Layer authorized to perform this work is:
TBCI CANESSA
Name Address Tel.

Type of Pipe Required: Low Pressure Line & Pump System
PERMIT EXPIRES ONE YEAR AFTER DATE OF ISSUE

- * Requires separate connections for sewage and storm drain where applicable. Storm water cannot be discharged to a sanitary sewer.
- * All work must be inspected and approved by a D.P.W. inspector before backfilling.
- * If this connection is to be part of a private service shared jointly with other building owners, attach copy of Recorded Joint Maintenance Agreement.
- * Permits can be issued to Industrial and/or Commercial Applicants only upon receipt and approval by the Commissioner of Public Works of required plans and supplemental information.
- * In addition, a City-issued Industrial User Discharge Permit and/or a Sewer Extension/Connection Permit issued by the Commonwealth of Massachusetts D.E.P. shall be required by the City for Industrial Discharge into the sewer system.

Industrial User Discharge Permit No. _____ Date _____
Comm. Mass. Sewer Conn./Ext. Permit No. _____ Date _____

A Filing and Inspection Fee of \$ 130.00 plus an Entrance Fee of \$ _____ where applicable, must accompany this application.
Bank # SOVEREIGN BANK Check # 284 Date: 1-29-03 Receipt # 4508

Other requirements: Inspection Only - To be done as per attached plan. Owner/Contractor must contact Health Dept. re: septic system abandonment application.
* CURB STOP TO BE IN SIDEWALK

Connection made to ☒ Sewer ☐ Storm Drain Part of jointly-shared private line ☐ Yes ☒ No

Applicant agrees to abide by the above terms, as well as all pertinent ordinances of the City of New Bedford, and such other special rules as the Commissioner of Public Works may deem necessary
Lorraine D. Waters/psr Commissioner of Public Works
Lorraine E. Vaughan Signature of Property Owner or Representative

INSPECTOR'S REPORT

INSPECTED BY: _____
DATE: _____
COMMENTS: _____

☐ APPROVED ☐ DISAPPROVED

