

PERMIT NO.



CITY OF NEW BEDFORD

DATE 4/5/03  
EXP. 4/5/04

23336

SEWER AND/OR STORM DRAIN PERMIT

This certifies that permission is granted to

Phillips Rd. Inc. / Mark W. White, Pres. 867 Middle Rd. Acushnet Ma. 02743  
Property Owner Address Stephanie Place South end of Cul-de-Sac Tel. (508) 763-8868

to connect a sewer and/or storm drain located at Stephanie Place to the sewer and/or storm drain in Stephanie Pl. Street-  
Assessor's Plot 132J, Lot 118

to be laid in accordance with the conditions in this application and the City of New Bedford ordinances.

TYPE OF USE: ☒ RESIDENTIAL ☐ COMMERICAL ☐ INDUSTRIAL ☐ OTHER

330 GPD

If applicant other than actual property owner, attach Letter of Authorization from Property Owner.

Name Long Realty Inc. / Robert Long c/o Ralph K. "Chip" Mulford Tel. (508) 965-8355 x-12

Mailing Address 158 Charles McCombs Blvd. New Bedford, Ma. 02745

The Bonded Contractor/Drain Layer authorized to perform this work is:

D.W. White 867 Middle Rd. Acushnet Ma. 02743 (508) 763-8868  
Name Address Tel.

Type of Pipe Required: PVC SDR 35

PERMIT EXPIRES ONE YEAR AFTER DATE OF ISSUE

\* Requires separate connections for sewage and storm drain where applicable. Storm water cannot be discharged to a sanitary sewer.

\* All work must be inspected and approved by a D.P.W. inspector before backfilling.

\* If this connection is to be part of a private service shared jointly with other building owners, attach copy of Recorded Joint Maintenance Agreement.

\* Permits can be issued to Industrial and/or Commercial Applicants only upon receipt and approval by the Commissioner of Public Works of required plans and supplemental information.

\* In addition, a City-issued Industrial User Discharge Permit and/or a Sewer Extension/Connection Permit issued by the Commonwealth of Massachusetts D.E.P. shall be required by the City for Industrial Discharge into the sewer system.

Industrial User Discharge Permit No. N/A Date

Comm. Mass. Sewer Conn./Ext. Permit No. N/A Date

A Filing and Inspection Fee of \$ 150.00, plus an Entrance Fee of \$ — where applicable, must accompany this application.

Bank # COMPASS BANK Check # 28591 Date: 4-5-03 Receipt # 4523

Other requirements: Inspection Only - Dawson Valley Subdivision - Connecting to 8" sewer and 12" storm drain in Stephanie Place

Connection made to ☒ Sewer ☒ Storm Drain Part of jointly-shared private line ☐ Yes ☒ No

Applicant agrees to abide by the above terms, as well as all pertinent ordinances of the City of New Bedford, and such other special rules as the Commissioner of Public Works may deem necessary

Lawrence D. Warden MHS  
Commissioner of Public Works

Chip Mulford for Long Realty  
Signature of Property Owner or Representative

INSPECTED BY:


DATE:

COMMENTS:

☐ APPROVED

☐ DISAPPROVED

SIGNATURE

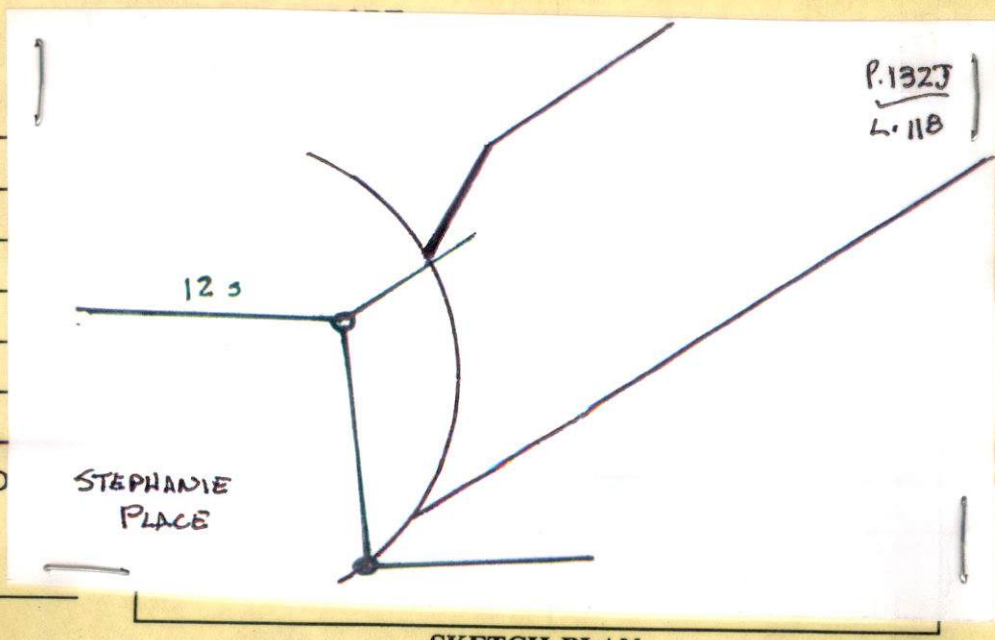

SKETCH PLAN



PERMIT NO.

23336



CITY OF NEW BEDFORD

SEWER AND/OR STORM DRAIN PERMIT

DATE 4/5/03  
EXP. 4/5/04

This certifies that permission is granted to

Phillips Rd. Inc. / Mark W. White, Pres. 861 Middle Rd. Acushnet MA. 02743  
Property Owner Address #16 Tel. (508) 763-8868

to connect a sewer and/or storm drain located at Stephanie Place South end of Cul-de-Sac  
Assessor's Plot 132J, Lot 118, to the sewer and/or storm drain in Stephanie Pl. Street

to be laid in accordance with the conditions in this application and the City of New Bedford ordinances.

TYPE OF USE: ☒ RESIDENTIAL ☐ COMMERICAL ☐ INDUSTRIAL ☐ OTHER 330 GPD

If applicant other than actual property owner, attach Letter of Authorization from Property Owner.

Name Long Realty Inc. / Robert Long c/o Ralph K. "Chip" Mulford Tel. (508) 965-8355 x-12  
Mailing Address 158 Charles McCombs Blvd. New Bedford, MA. 02745

The Bonded Contractor/Drain Layer authorized to perform this work is:

D.W. White 861 Middle Rd. Acushnet MA. 02743 (508) 763-8868  
Name Address Tel.

Type of Pipe Required: PVC SDR 35

PERMIT EXPIRES ONE YEAR AFTER DATE OF ISSUE

\* Requires separate connections for sewage and storm drain where applicable. Storm water cannot be discharged to a sanitary sewer.

\* All work must be inspected and approved by a D.P.W. inspector before backfilling.

\* If this connection is to be part of a private service shared jointly with other building owners, attach copy of Recorded Joint Maintenance Agreement.

\* Permits can be issued to Industrial and/or Commercial Applicants only upon receipt and approval by the Commissioner of Public Works of required plans and supplemental information.

\* In addition, a City-issued Industrial User Discharge Permit and/or a Sewer Extension/Connection Permit issued by the Commonwealth of Massachusetts D.E.P. shall be required by the City for Industrial Discharge into the sewer system.

Industrial User Discharge Permit No. N/A Date

Comm. Mass. Sewer Conn./Ext. Permit No. N/A Date

A Filing and Inspection Fee of \$150.00, plus an Entrance Fee of \$ where applicable, must accompany this application.

Bank # COMPASS BANK Check # 28591 Date: 4-5-03 Receipt # 4523

Other requirements: Inspection Only - Dawson Valley Subdivision - Connecting to 8" Sewer and 12" Storm Drain in Stephanie Place

Connection made to ☒ Sewer ☒ Storm Drain Part of jointly-shared private line ☐ Yes ☒ No

Applicant agrees to abide by the above terms, as well as all pertinent ordinances of the City of New Bedford, and such other special rules as the Commissioner of Public Works may deem necessary

Lawrence D. Warden MHS  
Commissioner of Public Works

Signature of Property Owner or Representative

# INSPECTOR'S REPORT

INSPECTED BY:

DATE:

COMMENTS:

☐ APPROVED ☐ DISAPPROVED

SIGNATURE

SKETCH PLAN

**Phillips Road Inc.**

**867 Middle Road  
Acushnet, MA 02743**


(508) 763-4468

City of New Bedford  
Various Departments  
William Street  
New Bedford, MA 02740

To Whom It May Concern:

This letter will certify that Long Realty Inc. has permission from Phillips Road Inc. to draw down the necessary permits and construct new homes on the lots comprising our Dawson Valley subdivision, which is off Phillips Road in New Bedford.

Sincerely,

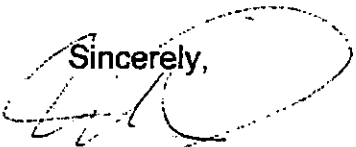

Mark W. White  
President  
Phillips Road Inc.



CITY OF NEW BEDFORD  
MASSACHUSETTS

DEPT. OF PUBLIC WORKS

133 WILLIAM STREET

LAWRENCE D. WORDEN  
COMMISSIONER

To Whom It May Concern:

I, Long Built Homes, 158 Charles McCombs Blvd, being  
Name Mailing Address

owner of property located at VARIOUS LOCATIONS IN NEW BEDFORD

Plot 132 I, Lot 118, hereby agree to allow CHIP K MULFORD,  
Name

My Attorney, PO Box 517, FAIRHAVEN 02749 to act on my behalf,  
Mailing Address

including affixing my signature, in securing permits for:

☒ Sewer/Drain Service Permits  
☒ Water Service Permits  
☒ Driveway Installation Permits  
☒ Sidewalk Installation Permits

I further agree to confirm to, and abide by, all City rules and regulations applicable to the permits(s) being applied for.

**LONG BUILT  
HOMES**

"Long" on Quality

**CHIP MULFORD**  
CORPORATE COUNSEL &  
LAND ACQUISITION

Cell: 508-965-8355  
Fax: 508-995-3275

Website: [www.longbuilthomes.com](http://www.longbuilthomes.com)  
158 Charles McCombs Blvd., New Bedford, MA 02745

Robert Long  
Print  
Long Realty, Inc  
158 Charles McCombs Blvd  
Address  
New Bedford, MA 02745  
March 7, 2002  
Date

To Whom It May Concern:

Chip Mulford is Long Realty Inc's Corporate Attorney, and is authorized to act on the Corporation's behalf in securing permits and any and all other matters involving the DPW.

Robert F. Long  
PRESIDENT & TREASURER