

PERMIT NO.

23337



CITY OF NEW BEDFORD

DATE...3-5-03

SEWER AND/OR STORM DRAIN PERMIT

This certifies that permission is granted to (CHIP MULFORD)
PHILLIPS RD. INC. / LONG REALTY INC. 158 CHARLES MCCOMB BLVD.
 Property Owner Address 867 MIDDLE RD. ACUSHNET MA. Tel. (508) 763-8868
 to connect a sewer and/or storm drain located at STEPHANIE PL (ES) 180' ± S/ MONICAS WAY
 Assessor's Plot 132 J, Lot 120, to the sewer and/or storm drain in STEPHANIE RACE Street
 to be laid in accordance with the conditions in this application and the City of New Bedford ordinances.

TYPE OF USE: ☒ RESIDENTIAL ☐ COMMERICAL ☐ INDUSTRIAL ☐ OTHER

If applicant other than actual property owner, attach Letter of Authorization from Property Owner.

Name CHIP MULFORD FOR LONG BUILT REALTY Tel. (508) 965-8355 x12

Mailing Address 158 CHARLES MCCOMB BLVD. N.B. MA. 02745

The Bonded Contractor/Drain Layer authorized to perform this work is:

D.W. WHITE 867 MIDDLE RD. ACUSHNET MA. 508 763-8868
 Name Address Tel.

Type of Pipe Required: PVC SDR 35

PERMIT EXPIRES ONE YEAR AFTER DATE OF ISSUE

- * Requires separate connections for sewage and storm drain where applicable. Storm water cannot be discharged to a sanitary sewer.
- * All work must be inspected and approved by a D.P.W. inspector before backfilling.
- * If this connection is to be part of a private service shared jointly with other building owners, attach copy of Recorded Joint Maintenance Agreement.
- * Permits can be issued to Industrial and/or Commercial Applicants only upon receipt and approval by the Commissioner of Public Works of required plans and supplemental information.
- * In addition, a City-issued Industrial User Discharge Permit and/or a Sewer Extension/Connection Permit issued by the Commonwealth of Massachusetts D.E.P. shall be required by the City for Industrial Discharge into the sewer system.

Industrial User Discharge Permit No. N/A Date.....

Comm. Mass. Sewer Conn./Ext. Permit No. N/A Date.....

A Filing and Inspection Fee of \$ 150.00, plus an Entrance Fee of \$ where applicable, must accompany this application.

Bank # Check # Date: 4-5-03 Receipt # 4523

Other requirements: INSPECTION ONLY TO 8" SEWER 12" STORM DRAIN

☒ Sewer
 Connection made to Part of jointly-shared private line ☐ Yes ☒ No
☒ Storm Drain


Applicant agrees to abide by the above terms, as well as all pertinent ordinances of the City of New Bedford, and such other special rules as the Commissioner of Public Works may deem necessary

Lawrence A. Wolden
 Commissioner of Public Works

Chip Mulford for Long Realty
 Signature of Property Owner or Representative

INSPECTOR'S REPORT

INSPECTED BY: _____
 DATE: _____
 COMMENTS: _____

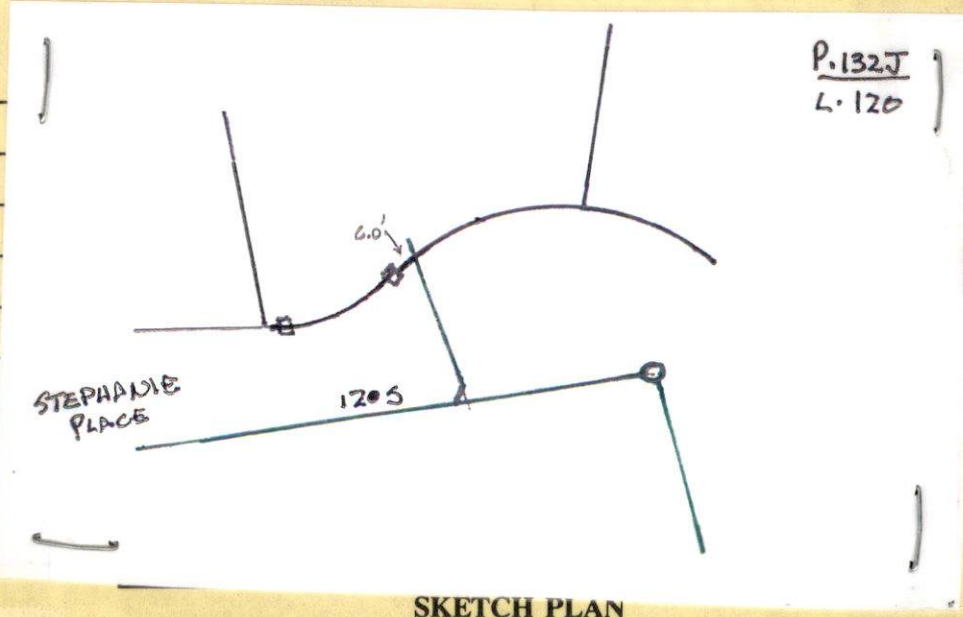

☐ APPROVED ☐ DISAPPROVED

SIGNATURE

SKETCH PLAN

PERMIT NO.

23337



CITY OF NEW BEDFORD

DATE 3-5-03

SEWER AND/OR STORM DRAIN PERMIT

This certifies that permission is granted to (CHIP MULFORD)
PHILLIPS RD. INC. / LONG REALTY INC. 158 CHARLES MC COMBS BLVD.
Property Owner Address 867 MIDDLE RD. ACUSHNET MA. Tel. (508) 763-8868
to connect a sewer and/or storm drain located at STEPHANIE PL (ES) 180' ± S/ MONICAS WAY
Assessor's Plot 132 J, Lot 120, to the sewer and/or storm drain in STEPHANIE PLACE Street
to be laid in accordance with the conditions in this application and the City of New Bedford ordinances.

TYPE OF USE: ☒ RESIDENTIAL ☐ COMMERICAL ☐ INDUSTRIAL ☐ OTHER

If applicant other than actual property owner, attach Letter of Authorization from Property Owner.

Name CHIP MULFORD FOR LONG BUILT REALTY Tel. (508) 965-8355 xt 12
Mailing Address 158 CHARLES MC COMBS BLVD. N.B. MA. 02745

The Bonded Contractor/Drain Layer authorized to perform this work is:

D.W. WHITE 867 MIDDLE RD. ACUSHNET MA. 508 763-8868
Name Address Tel.

Type of Pipe Required: PVC SDR 35

PERMIT EXPIRES ONE YEAR AFTER DATE OF ISSUE

- * Requires separate connections for sewage and storm drain where applicable. Storm water cannot be discharged to a sanitary sewer.
- * All work must be inspected and approved by a D.P.W. inspector before backfilling.
- * If this connection is to be part of a private service shared jointly with other building owners, attach copy of Recorded Joint Maintenance Agreement.
- * Permits can be issued to Industrial and/or Commercial Applicants only upon receipt and approval by the Commissioner of Public Works of required plans and supplemental information.
- * In addition, a City-issued Industrial User Discharge Permit and/or a Sewer Extension/Connection Permit issued by the Commonwealth of Massachusetts D.E.P. shall be required by the City for Industrial Discharge into the sewer system.

Industrial User Discharge Permit No. N/A Date
Comm. Mass. Sewer Conn./Ext. Permit No. N/A Date

A Filing and Inspection Fee of \$150.00, plus an Entrance Fee of \$ where applicable, must accompany this application.

Bank # Check # Date: 4-5-03 Receipt # 4523

Other requirements: INSPECTION ONLY TO 8" SEWER 12" STORM DRAIN

☒ Sewer

Connection made to

Part of jointly-shared private line ☐ Yes ☒ No

☒ Storm Drain

Applicant agrees to abide by the above terms, as well as all pertinent ordinances of the City of New Bedford, and such other special rules as the Commissioner of Public Works may deem necessary

Lawrence A. Wolden
Commissioner of Public Works

Signature of Property Owner or Representative

INSPECTOR'S REPORT

INSPECTED BY:

DATE:

COMMENTS:

☐ APPROVED

☐ DISAPPROVED

SIGNATURE

SKETCH PLAN

Phillips Road Inc.

**867 Middle Road
Acushnet, MA 02743**


(508) 763-8468

City of New Bedford
Various Departments
William Street
New Bedford, MA 02740

To Whom It May Concern:

This letter will certify that Long Realty Inc. has permission from Phillips Road Inc. to draw down the necessary permits and construct new homes on the lots comprising our Dawson Valley subdivision, which is off Phillips Road in New Bedford.

Sincerely,

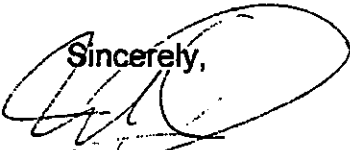

Mark W. White
President
Phillips Road Inc.



CITY OF NEW BEDFORD
MASSACHUSETTS

DEPT. OF PUBLIC WORKS

133 WILLIAM STREET

LAWRENCE D. WORDEN
COMMISSIONER

To Whom It May Concern:

I, Long Built Homes, 158 Charles McCombs Blvd, being
Name Mailing Address

owner of property located at: VARIOUS LOCATIONS IN NEW BEDFORD

Plot 132 J, Lot 120, hereby agree to allow ROBERT K "CHIP" MULFORD,
Name

My Attorney, PO Box 517, FAIRHAVEN 02749 to act on my behalf,
Mailing Address

including affixing my signature, in securing permits for:

- ☒ Sewer/Drain Service Permits
- ☒ Water Service Permits
- ☒ Driveway Installation Permits
- ☒ Sidewalk Installation Permits

I further agree to confirm to, and abide by, all City rules and regulations applicable to the permits(s) being applied for.

LONG BUILT
HOMES

"Long" on Quality

CHIP MULFORD
CORPORATE COUNSEL &
LAND ACQUISITION

Cell: 508-965-8355
Fax: 508-995-3275

Website: www.longbuilthomes.com
158 Charles McCombs Blvd., New Bedford, MA 02745

Robert Long
Print
Long Built Homes, Inc
158 Charles McCombs Blvd
Address
New Bedford, MA 02745
October 2, 2002
Date

To Whom It May Concern:

Chip Mulford is Long Realty Inc's Corporate Attorney, and is authorized to act on the Corporation's behalf in securing permits and any and all other matters involving the DPW.

Robert F. Long
PRESIDENT & TREASURER