

PERMIT NO.

23341



CITY OF NEW BEDFORD

SEWER AND/OR STORM DRAIN PERMIT

DATE 3/13/03

EXP. 3/13/04

This certifies that permission is granted to

LONG REALTY, INC. / ROBERT LONG C/O RALPH MULFORD, ATTY. 158 CHARLES MCOMBS BLVD

Property Owner

Address N. B. , MA. 02745

Tel. (508) 965-8355 X-12

to connect a sewer and/or storm drain located at JENNIFER LANE @ CENTER OF CUL-DE-SAC.

Assessor's Plot 132J, Lot 67, to the sewer and/or storm drain in JENNIFER LANE Street

to be laid in accordance with the conditions in this application and the City of New Bedford ordinances.

TYPE OF USE: ☒ RESIDENTIAL ☐ COMMERICAL ☐ INDUSTRIAL ☐ OTHER

3306PD

If applicant other than actual property owner, attach Letter of Authorization from Property Owner.

Name RALPH K. MULFORD, ATTY. / LONG BUILT HOMES Tel. (508) 965-8355 X-12

Mailing Address P.O. BOX 817 FAIRHAVEN, MA. 02719

The Bonded Contractor/Drain Layer authorized to perform this work is:

D.W. WHITE 867 MIDDLE RD. ACUSHNET, MA. 02743 (508) 763-8868

Name

Address

Tel.

Type of Pipe Required: PVC SDR 35

PERMIT EXPIRES ONE YEAR AFTER DATE OF ISSUE

* Requires separate connections for sewage and storm drain where applicable. Storm water cannot be discharged to a sanitary sewer.

* All work must be inspected and approved by a D.P.W. inspector before backfilling.

* If this connection is to be part of a private service shared jointly with other building owners, attach copy of Recorded Joint Maintenance Agreement.

* Permits can be issued to Industrial and/or Commercial Applicants only upon receipt and approval by the Commissioner of Public Works of required plans and supplemental information.

* In addition, a City-issued Industrial User Discharge Permit and/or a Sewer Extension/Connection Permit issued by the Commonwealth of Massachusetts D.E.P. shall be required by the City for Industrial Discharge into the sewer system.

Industrial User Discharge Permit No. N/A Date

Comm. Mass. Sewer Conn./Ext. Permit No. N/A Date

A Filing and Inspection Fee of \$....., plus an Entrance Fee of \$..... where applicable, must accompany this application.

Bank # COMPASS BANK Check # 28731 Date: 3-14-03 Receipt # 4527

Other requirements: Inspection Only - Woodford Estates Subdivision - Connecting to 8" Sewer and "N/A" storm drain in Jennifer Lane

☒ Sewer

Connection made to

Part of jointly-shared private line ☐ Yes ☒ No

☐ Storm Drain

None Available

Applicant agrees to abide by the above terms, as well as all pertinent ordinances of the City of New Bedford, and such other special rules as the Commissioner of Public Works may deem necessary

Lawrence D. Norden MHS

Commissioner of Public Works

Long Realty Co. / Ralph Mulford

Signature of Property Owner or Representative

INSPECTED BY:

DATE:


COMMENTS:

☐ APPROVED

☐ DISAPPROVED

SIGNATURE

INSPECTOR'S REPORT

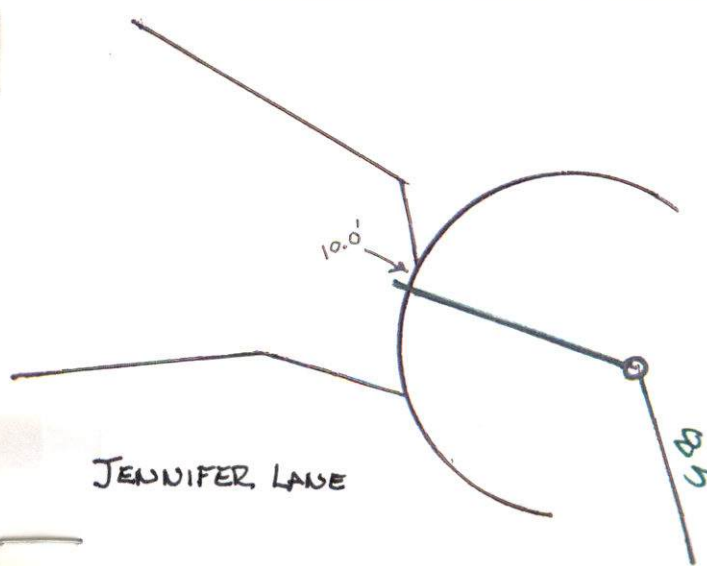

P.132J
L.67

SKETCH PLAN

PERMIT NO.

23341



CITY OF NEW BEDFORD

SEWER AND/OR STORM DRAIN PERMIT

DATE 3/13/03
EXP. 3/13/04

This certifies that permission is granted to
LONG REALTY, INC. / ROBERT LONG, C/O RALPH MULFORD, ATTY. 158 CHARLES McCOMBS BLVD
Property Owner Address N. B., MA. 02745 Tel. (508) 965-8355 X-12

to connect a sewer and/or storm drain located at JENNIFER LANE @ CENTER OF CUL-DE-SAC.
Assessor's Plot 132 J, Lot 67, to the sewer and/or storm drain in JENNIFER LANE Street

to be laid in accordance with the conditions in this application and the City of New Bedford ordinances.

TYPE OF USE: ☒ RESIDENTIAL ☐ COMMERCIAL ☐ INDUSTRIAL ☐ OTHER

3306PD

If applicant other than actual property owner, attach Letter of Authorization from Property Owner.

Name RALPH K. MULFORD, ATTY. / LONG BUILT HOMES Tel. (508) 965-8355 X-12

Mailing Address P.O. Box 817 FAIRHAVEN, MA. 02719

The Bonded Contractor/Drain Layer authorized to perform this work is:

D.W. WHITE 867 MIDDLE RD. ACUSHNET, MA. 02743 (508) 763-8868
Name Address Tel.

Type of Pipe Required: PVC SDR 35

PERMIT EXPIRES ONE YEAR AFTER DATE OF ISSUE

- * Requires separate connections for sewage and storm drain where applicable. Storm water cannot be discharged to a sanitary sewer.
- * All work must be inspected and approved by a D.P.W. inspector before backfilling.
- * If this connection is to be part of a private service shared jointly with other building owners, attach copy of Recorded Joint Maintenance Agreement.
- * Permits can be issued to Industrial and/or Commercial Applicants only upon receipt and approval by the Commissioner of Public Works of required plans and supplemental information.
- * In addition, a City-issued Industrial User Discharge Permit and/or a Sewer Extension/Connection Permit issued by the Commonwealth of Massachusetts D.E.P. shall be required by the City for Industrial Discharge into the sewer system.

Industrial User Discharge Permit No. N/A Date

Comm. Mass. Sewer Conn./Ext. Permit No. N/A Date

A Filing and Inspection Fee of \$....., plus an Entrance Fee of \$..... where applicable, must accompany this application.

Bank # COMBASS BANK Check # 28731 Date: 3-14-03 Receipt # 4527

Other requirements: Inspection Only - Woodford Estates Subdivision - Connecting...
to 8" Sewer and "N/A" Storm Drain in Jennifer Lane

Connection made to ☒ Sewer Part of jointly-shared private line ☐ Yes ☒ No
☐ Storm Drain None Available

Applicant agrees to abide by the above terms, as well as all pertinent ordinances of the City of New Bedford, and such other special rules as the Commissioner of Public Works may deem necessary

Lawrence D. Norden MHS
Commissioner of Public Works

Long Realty, Inc. / Ralph Mulford
Signature of Property Owner or Representative

INSPECTOR'S REPORT

INSPECTED BY: _____

DATE: _____

COMMENTS: _____

☐ APPROVED ☐ DISAPPROVED

SIGNATURE

SKETCH PLAN



CITY OF NEW BEDFORD
MASSACHUSETTS

DEPT. OF PUBLIC WORKS

133 WILLIAM STREET

LAWRENCE D. WORDEN
COMMISSIONER

To Whom It May Concern:

I, Long Built Homes, 158 Charles McCombs Blvd, being
Name Mailing Address

owner of property located at VARIOUS LOCATIONS IN NEW BEDFORD

Plot _____, Lot _____, hereby agree to allow Robert K. "CHIP" Mulford,
Name

My Attorney, PO Box 517, FAIRHAVEN 02749 to act on my behalf,
Mailing Address

including affixing my signature, in securing permits for:

☒ Sewer/Drain Service Permits
☒ Water Service Permits
☒ Driveway Installation Permits
☒ Sidewalk Installation Permits

I further agree to confirm to, and abide by, all City rules and regulations applicable to the permits(s) being applied for.

**LONG BUILT
HOMES**

"Long" on Quality

CHIP MULFORD
CORPORATE COUNSEL &
LAND ACQUISITION

Cell: 508-965-8355
Fax: 508-995-3275

Robert K. Mulford
Print
Long Built Homes, Inc.
158 Charles McCombs Blvd
Address
New Bedford, MA 02745
March 7, 2002
Date

Website: www.longbuilthomes.com

158 Charles McCombs Blvd., New Bedford, MA 02745

508-9958240

To Whom It May Concern:

Chip Mulford is Long Realty Inc.'s Corporate Attorney, and is authorized to act on the Corporation's behalf in securing permits and any and all other matters involving the DPW.

Robert F. Long
Robert F. Long
President - The Mulford