

PERMIT NO.

CITY OF NEW BEDFORD

DATE.....5-14-03

23378



SEWER AND/OR STORM DRAIN PERMIT

This certifies that permission is granted to

LONG BUILT HOMES/LONG REALTY INC 158 CHARLES MACOMBS BLVD

Property Owner

Address #91

Tel.

508 995 8240

to connect a sewer and/or storm drain located at STEPHANIE PL. (WS) 260' ± S/KATELYN WAY

Assessor's Plot 132J, Lot 71, to the sewer and/or storm drain in STEPHANIE PL. Street

to be laid in accordance with the conditions in this application and the City of New Bedford ordinances.

TYPE OF USE: ☒ RESIDENTIAL ☐ COMMERICAL ☐ INDUSTRIAL ☐ OTHER

330 GPD

If applicant other than actual property owner, attach Letter of Authorization from Property Owner.

Name CHIP MULFORD

Tel.

508 995-8245

Mailing Address P.O. BOX 87 FAIRHAVEN 02719

The Bonded Contractor/Drain Layer authorized to perform this work is:

D.W. WHITE

Name

Address

Tel.

Type of Pipe Required: PVC SDR 35

PERMIT EXPIRES ONE YEAR AFTER DATE OF ISSUE

* Requires separate connections for sewage and storm drain where applicable. Storm water cannot be discharged to a sanitary sewer.

* All work must be inspected and approved by a D.P.W. inspector before backfilling.

* If this connection is to be part of a private service shared jointly with other building owners, attach copy of Recorded Joint Maintenance Agreement.

* Permits can be issued to Industrial and/or Commercial Applicants only upon receipt and approval by the Commissioner of Public Works of required plans and supplemental information.

* In addition, a City-issued Industrial User Discharge Permit and/or a Sewer Extension/Connection Permit issued by the Commonwealth of Massachusetts D.E.P. shall be required by the City for Industrial Discharge into the sewer system.

Industrial User Discharge Permit No. N/A Date

Comm. Mass. Sewer Conn./Ext. Permit No. N/A Date

A Filing and Inspection Fee of \$150.00, plus an Entrance Fee of \$ where applicable, must accompany this application.

Bank # COMPASS BANK Check # 29436 Date: 5-15-03 Receipt # 4587

Other requirements: INSPECTION ONLY

☒ Sewer

Connection made to

Part of jointly-shared private line ☐ Yes ☒ No

☒ Storm Drain

Applicant agrees to abide by the above terms, as well as all pertinent ordinances of the City of New Bedford, and such other special rules as the Commissioner of Public Works may deem necessary

Lawrence D. Worden

Commissioner of Public Works

Chip Mulford for Long Built Homes

Signature of Property Owner or Representative

INSPECTED BY:

DATE:


COMMENTS:

☐ APPROVED

☐ DISAPPROVED

SIGNATURE

SKETCH PLAN

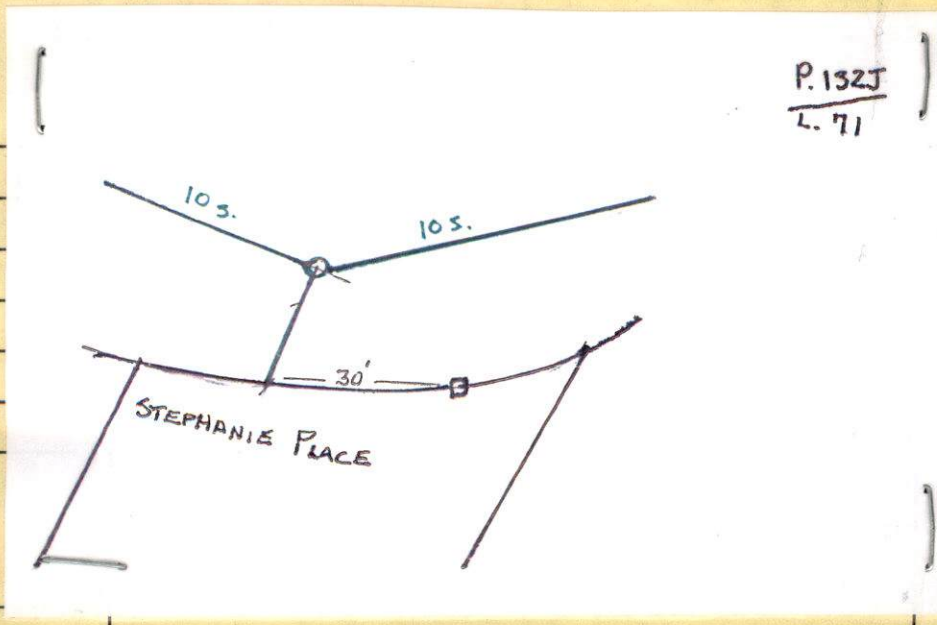

PERMIT NO.

23378



CITY OF NEW BEDFORD

DATE 5-14-03

SEWER AND/OR STORM DRAIN PERMIT

This certifies that permission is granted to

LONG BUILT HOMES/LONG REALTY INC 158 CHARLES MACOMBS BLVD
Property Owner Address #91 Tel. 508 995 8240
to connect a sewer and/or storm drain located at STEPHANIE PL. (WS) 260' ± S/KATELYN WAY
Assessor's Plot. 132J, Lot 71, to the sewer and/or storm drain in STEPHANIE PL. Street
to be laid in accordance with the conditions in this application and the City of New Bedford ordinances.

TYPE OF USE: ☒ RESIDENTIAL ☐ COMMERICAL ☐ INDUSTRIAL ☐ OTHER

330 GPD

If applicant other than actual property owner, attach Letter of Authorization from Property Owner.

Name CHIP MULFORD Tel. 508 995-8245

Mailing Address P.O. Box 87 FAIRHAVEN 02719

The Bonded Contractor/Drain Layer authorized to perform this work is:

D.W. WHITE
Name Address Tel.

Type of Pipe Required: PVC SDR 35

PERMIT EXPIRES ONE YEAR AFTER DATE OF ISSUE

- * Requires separate connections for sewage and storm drain where applicable. Storm water cannot be discharged to a sanitary sewer.
- * All work must be inspected and approved by a D.P.W. inspector before backfilling.
- * If this connection is to be part of a private service shared jointly with other building owners, attach copy of Recorded Joint Maintenance Agreement.
- * Permits can be issued to Industrial and/or Commercial Applicants only upon receipt and approval by the Commissioner of Public Works of required plans and supplemental information.
- * In addition, a City-issued Industrial User Discharge Permit and/or a Sewer Extension/Connection Permit issued by the Commonwealth of Massachusetts D.E.P. shall be required by the City for Industrial Discharge into the sewer system.

Industrial User Discharge Permit No. N/A Date

Comm. Mass. Sewer Conn./Ext. Permit No. N/A Date

A Filing and Inspection Fee of \$150.00, plus an Entrance Fee of \$ where applicable, must accompany this application.

Bank # COMPASS BANK Check # 29436 Date: 5-15-03 Receipt # 4587

Other requirements: INSPECTION ONLY

Connection made to ☒ Sewer ☒ Storm Drain Part of jointly-shared private line ☐ Yes ☒ No

Applicant agrees to abide by the above terms, as well as all pertinent ordinances of the City of New Bedford, and such other special rules as the Commissioner of Public Works may deem necessary

Lawrence D. Worden MHS
Commissioner of Public Works

Chip Mulford for Long Built Homes
Signature of Property Owner or Representative

INSPECTOR'S REPORT

INSPECTED BY:

DATE:

COMMENTS:

☐ APPROVED ☐ DISAPPROVED

SIGNATURE

SKETCH PLAN



CITY OF NEW BEDFORD
MASSACHUSETTS

DEPT. OF PUBLIC WORKS

133 WILLIAM STREET

LAWRENCE D. WORDEN
COMMISSIONER

To Whom It May Concern:

I, Long Built Homes, 158 Charles McCombs Blvd, being
Name Mailing Address
owner of property located at Woodford Estates (wire loop
Plot 132J, Lot 71, hereby agree to allow Ralph K "CHIP" Mulford
Name
My Attorney, P.O. Box 817, Fairhaven 02749 to act on my behalf,
Mailing Address

including affixing my signature, in securing permits for:

☒ Sewer/Drain Service Permits
☒ Water Service Permits
☒ Driveway Installation Permits
None yet ☐ Sidewalk Installation Permits

I further agree to confirm to, and abide by, all City rules and regulations applicable to the permits(s) being applied for.

Name

Chip Mulford
Print
Long Built Homes, Inc.
158 Charles McCombs Blvd
Address
New Bedford, MA 02745
August 2, 2002
Date

LONG BUILT
HOMES

"Long" on Quality

CHIP MULFORD
CORPORATE COUNSEL &
LAND ACQUISITION

Cell: 508-965-8355
Fax: 508-995-3275

Website: www.longbuilthomes.com

158 Charles McCombs Blvd., New Bedford, MA 02745

