

PERMIT NO.

23379



CITY OF NEW BEDFORD

DATE 5/15/03  
EXP 5/15/04

SEWER AND/OR STORM DRAIN PERMIT

This certifies that permission is granted to

Long Built Homes / Robert Long do Ralph H. Mulford Atty.  
Property Owner Address Tel.

to connect a sewer and/or storm drain located at Stephanie Pl. (W.S.) 330' + 12.5' / Kathryn Way  
Assessor's Plot 132J, Lot 89, to the sewer and/or storm drain in Stephanie Pl. Street

to be laid in accordance with the conditions in this application and the City of New Bedford ordinances.

TYPE OF USE: ☒ RESIDENTIAL ☐ COMMERCIAL ☐ INDUSTRIAL ☐ OTHER

If applicant other than actual property owner, attach Letter of Authorization from Property Owner.

Name Ralph H. Mulford Atty / Long Built Homes Tel. (508) 965-8355 X-12

Mailing Address P.O. Box 817 Fairhaven, MA 02719

The Bonded Contractor/Drain Layer authorized to perform this work is:

D.W. White 857 Middle Rd. Acushnet MA 02743 (508) 763-8868  
Name Address Tel.

Type of Pipe Required: PVC JDR 35

PERMIT EXPIRES ONE YEAR AFTER DATE OF ISSUE

- \* Requires separate connections for sewage and storm drain where applicable. Storm water cannot be discharged to a sanitary sewer.
- \* All work must be inspected and approved by a D.P.W. inspector before backfilling.
- \* If this connection is to be part of a private service shared jointly with other building owners, attach copy of Recorded Joint Maintenance Agreement.
- \* Permits can be issued to Industrial and/or Commercial Applicants only upon receipt and approval by the Commissioner of Public Works of required plans and supplemental information.
- \* In addition, a City-issued Industrial User Discharge Permit and/or a Sewer Extension/Connection Permit issued by the Commonwealth of Massachusetts D.E.P. shall be required by the City for Industrial Discharge into the sewer system.

Industrial User Discharge Permit No. N/A Date

Comm. Mass. Sewer Conn./Ext. Permit No. N/A Date

A Filing and Inspection Fee of \$150.00, plus an Entrance Fee of \$ where applicable, must accompany this application.

Bank # Compass Bank Check # 29508 Date: 5/15/03 Receipt # 4588

Other requirements: Inspection Only - Wooded Estate Subdivision - connecting to 10" sewer and 18" storm drain in Stephanie Place

Connection made to ☒ Sewer ☒ Storm Drain  
Part of jointly-shared private line ☐ Yes ☒ No

Applicant agrees to abide by the above terms, as well as all pertinent ordinances of the City of New Bedford, and such other special rules as the Commissioner of Public Works may deem necessary

Signature of Commissioner of Public Works  
Commissioner of Public Works

Signature of Property Owner or Representative  
Long Built Homes

INSPECTOR'S REPORT

INSPECTED BY:

DATE:


COMMENTS:

☐ APPROVED

☐ DISAPPROVED

SIGNATURE

31-746

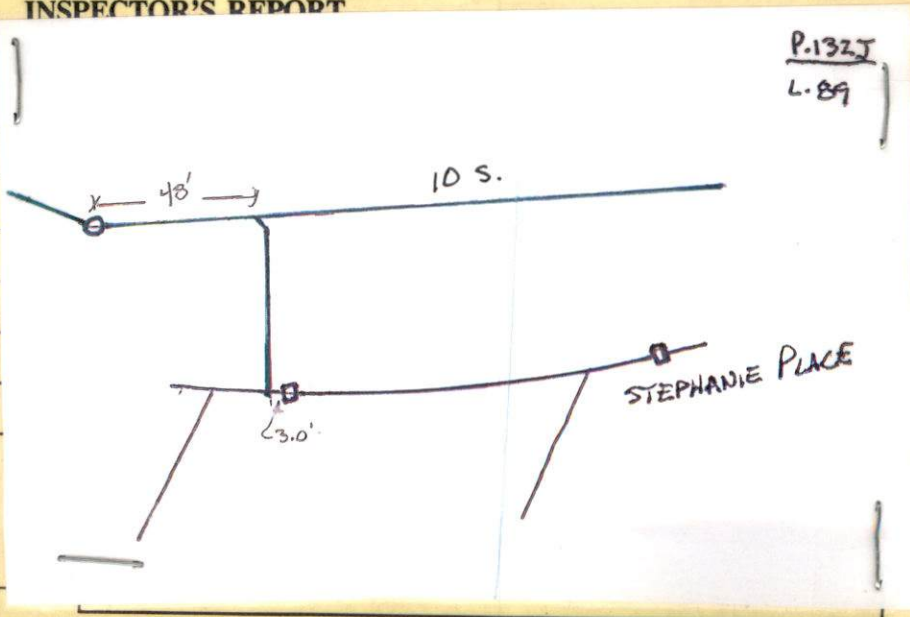

SKETCH PLAN



PERMIT NO.

23379



CITY OF NEW BEDFORD

DATE 5/15/03  
EXP 5/15/04

SEWER AND/OR STORM DRAIN PERMIT

This certifies that permission is granted to

Long Built Homes  
Long Realty Inc. / Robert Long c/o Ralph K. Mulford Atty.  
Property Owner Address #83 Tel.

to connect a sewer and/or storm drain located at Stephanie Pl. (Ans.) 330' +/- 5. / Kathryn Way  
Assessor's Plot 132J, Lot 89, to the sewer and/or storm drain in Stephanie Pl. Street

to be laid in accordance with the conditions in this application and the City of New Bedford ordinances.

TYPE OF USE: ☒ RESIDENTIAL ☐ COMMERCIAL ☐ INDUSTRIAL ☐ OTHER

If applicant other than actual property owner, attach Letter of Authorization from Property Owner.

Name Ralph K. Mulford Atty. / Long Built Homes Tel. (508) 963-8355 X-12

Mailing Address P.O. Box 817 Fairhaven, MA 02719

The Bonded Contractor/Drain Layer authorized to perform this work is:

D.W. White 861 Middle Rd. Acushnet MA 02743 (508) 763-8868  
Name Address Tel.

Type of Pipe Required: PVC SDR 35

PERMIT EXPIRES ONE YEAR AFTER DATE OF ISSUE

- \* Requires separate connections for sewage and storm drain where applicable. Storm water cannot be discharged to a sanitary sewer.
- \* All work must be inspected and approved by a D.P.W. inspector before backfilling.
- \* If this connection is to be part of a private service shared jointly with other building owners, attach copy of Recorded Joint Maintenance Agreement.
- \* Permits can be issued to Industrial and/or Commercial Applicants only upon receipt and approval by the Commissioner of Public Works of required plans and supplemental information.
- \* In addition, a City-issued Industrial User Discharge Permit and/or a Sewer Extension/Connection Permit issued by the Commonwealth of Massachusetts D.E.P. shall be required by the City for Industrial Discharge into the sewer system.

Industrial User Discharge Permit No. N/A Date

Comm. Mass. Sewer Conn./Ext. Permit No. N/A Date

A Filing and Inspection Fee of \$ 150.00 plus an Entrance Fee of \$ - where applicable, must accompany this application.

Bank # Compass Bank Check # 29508 Date: 5/15/03 Receipt # 4588

Other requirements: Inspection Only - Woodford Estates Subdivision - connecting to  
10" sewer and 18" storm drain in Stephanie Place

Connection made to ☒ Sewer Part of jointly-shared private line ☐ Yes ☒ No  
☒ Storm Drain

Applicant agrees to abide by the above terms, as well as all pertinent ordinances of the City of New Bedford, and such other special rules as the Commissioner of Public Works may deem necessary

Lawrence D. Wooden Jr.  
Commissioner of Public Works

Long Realty Inc.  
Signature of Property Owner or Representative

INSPECTOR'S REPORT

INSPECTED BY: \_\_\_\_\_

DATE: \_\_\_\_\_

COMMENTS: \_\_\_\_\_

\_\_\_\_\_

\_\_\_\_\_

\_\_\_\_\_

\_\_\_\_\_

☐ APPROVED ☐ DISAPPROVED

SIGNATURE

SKETCH PLAN



CITY OF NEW BEDFORD  
MASSACHUSETTS

DEPT. OF PUBLIC WORKS

133 WILLIAM STREET

LAWRENCE D. WORDEN  
COMMISSIONER

To Whom It May Concern:

I, Long Built Homes, 158 Charles McCombs Blvd, being  
Name Mailing Address

owner of property located at VARIOUS LOCATIONS IN NEW BEDFORD

Plot \_\_\_\_\_, Lot \_\_\_\_\_, hereby agree to allow Robert K. "CHIP" Mulford,  
Name

My Attorney, Robert F. Long, FAIRHAVEN 02745 to act on my behalf,  
Mailing Address

including affixing my signature, in securing permits for:

- ☒ Sewer/Drain Service Permits
- ☒ Water Service Permits
- ☒ Driveway Installation Permits
- ☒ Sidewalk Installation Permits

I further agree to confirm to, and abide by, all City rules and regulations applicable to the permits(s) being applied for.

**LONG BUILT  
HOMES**

"Long" on Quality

**CHIP MULFORD**  
CORPORATE COUNSEL &  
LAND ACQUISITION

Cell: 508-965-8355  
Fax: 508-995-3275

Robert F. Long  
Print  
Long Built Homes, Inc  
158 Charles McCombs Blvd  
Address  
New Bedford, MA 02745  
October 2, 2002  
Date

508-9958240

To Whom It May Concern:

Chip Mulford is Long Realty Inc.'s Corporate Attorney, and is authorized to act on the Corporation's behalf in securing permits and any and all other matters involving the DPW.

Robert F. Long  
Robert F. Long  
President - Long Built Homes

Website: [www.longbuilthomes.com](http://www.longbuilthomes.com)  
158 Charles McCombs Blvd., New Bedford, MA 02745