

PERMIT NO.

23419



CITY OF NEW BEDFORD

SEWER AND/OR STORM DRAIN PERMIT

DATE 7/11/03

EXP. 7/11/04

This certifies that permission is granted to

Joseph N. Medeiros, Jr., Trs. 22 Tarklin Hill Rd. NB MA 508-998-8118

Property Owner

Address #38

Tel.

to connect a sewer and/or storm drain located at Hamlin St (ss) 360'± W. River Rd.

Assessor's Plot 119, Lot 280, to the sewer and/or storm drain in Hamlin St. Street

to be laid in accordance with the conditions in this application and the City of New Bedford ordinances.

TYPE OF USE: ☒ RESIDENTIAL ☐ COMMERCIAL ☐ INDUSTRIAL ☐ OTHER

If applicant other than actual property owner, attach Letter of Authorization from Property Owner.

Name.....Tel.....

Mailing Address.....

The Bonded Contractor/Drain Layer authorized to perform this work is:

~~Cordoso Contracting, Inc. 12 White St. Acushnet MA 508-998-5115~~

Name Menard Bros

Address

Tel.

Type of Pipe Required: PVC SDR-35

PERMIT EXPIRES ONE YEAR AFTER DATE OF ISSUE

* Requires separate connections for sewage and storm drain where applicable. Storm water cannot be discharged to a sanitary sewer.

* All work must be inspected and approved by a D.P.W. inspector before backfilling.

* If this connection is to be part of a private service shared jointly with other building owners, attach copy of Recorded Joint Maintenance Agreement.

* Permits can be issued to Industrial and/or Commercial Applicants only upon receipt and approval by the Commissioner of Public Works of required plans and supplemental information.

* In addition, a City-issued Industrial User Discharge Permit and/or a Sewer Extension/Connection Permit issued by the Commonwealth of Massachusetts D.E.P. shall be required by the City for Industrial Discharge into the sewer system.

Industrial User Discharge Permit No.....Date.....

Comm. Mass. Sewer Conn./Ext. Permit No.....Date.....

A Filing and Inspection Fee of \$150.00, plus an Entrance Fee of \$..... where applicable, must accompany this application.

Bank # Slade's Ferry Check # 219 Date: 7/11/03 Receipt # 4657

Other requirements: Insp. Only, Sewer Main 8"

Foundation Permit # 814-03

☒ Sewer

Connection made to

Part of jointly-shared private line ☐ Yes ☒ No

☐ Storm Drain

Applicant agrees to abide by the above terms, as well as all pertinent ordinances of the City of New Bedford, and such other special rules as the Commissioner of Public Works may deem necessary

Duarte M. Andrade (ms)

Commissioner of Public Works

Acting City Engineer

Catherine M. Melvin

Signature of Property Owner or Representative

INSPECTOR'S REPORT

INSPECTED BY: KEVIN J CORNELL

DATE: 9-17-03

COMMENTS:


☒ APPROVED

☐ DISAPPROVED

Kevin J Cornell

SIGNATURE

31-746

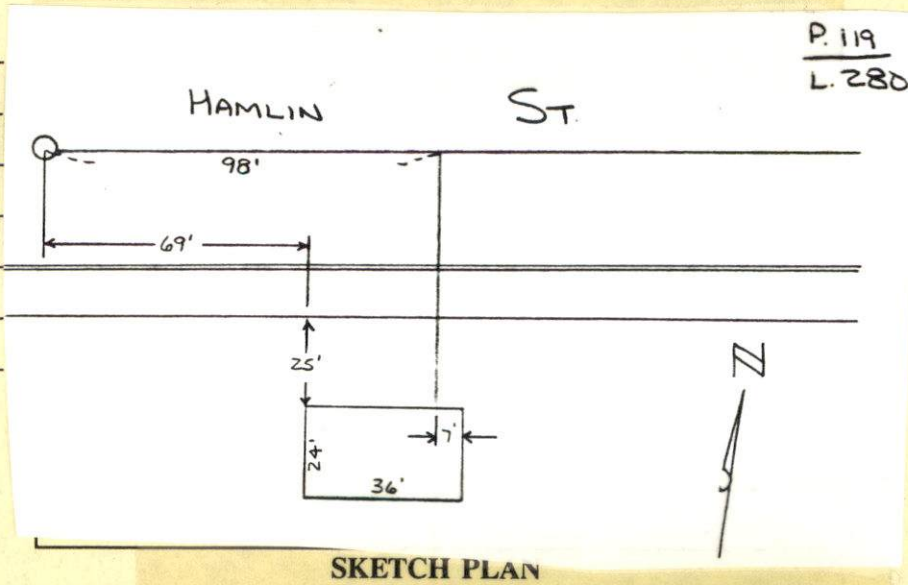

SKETCH PLAN

PERMIT NO.

23419



CITY OF NEW BEDFORD

SEWER AND/OR STORM DRAIN PERMIT

DATE 7/11/03

EXP. 7/11/04

This certifies that permission is granted to

Joseph N. Medeiros, Jr., Trs. 22 Tarklin Hill Rd. NB MA 508-998-8118

Property Owner

Address

Tel.

to connect a sewer and/or storm drain located at Hamlin St. (SS) 360'± W. River Rd.

Assessor's Plot 119, Lot 280, to the sewer and/or storm drain in Hamlin St. Street

to be laid in accordance with the conditions in this application and the City of New Bedford ordinances.

TYPE OF USE: ☒ RESIDENTIAL ☐ COMMERICAL ☐ INDUSTRIAL ☐ OTHER

If applicant other than actual property owner, attach Letter of Authorization from Property Owner.

Name.....Tel.....

Mailing Address.....

The Bonded Contractor/Drain Layer authorized to perform this work is: Menard Bros. 307 County Rd. W. Wareham

Cardoso Contracting, Inc. 12 White St. Acushnet MA 508-998-5115

Name

Address

508-995-4022

Tel.

Type of Pipe Required: PVC SDR-35

PERMIT EXPIRES ONE YEAR AFTER DATE OF ISSUE

* Requires separate connections for sewage and storm drain where applicable. Storm water cannot be discharged to a sanitary sewer.

* All work must be inspected and approved by a D.P.W. inspector before backfilling.

* If this connection is to be part of a private service shared jointly with other building owners, attach copy of Recorded Joint Maintenance Agreement.

* Permits can be issued to Industrial and/or Commercial Applicants only upon receipt and approval by the Commissioner of Public Works of required plans and supplemental information.

* In addition, a City-issued Industrial User Discharge Permit and/or a Sewer Extension/Connection Permit issued by the Commonwealth of Massachusetts D.E.P. shall be required by the City for Industrial Discharge into the sewer system.

Industrial User Discharge Permit No.....Date.....

Comm. Mass. Sewer Conn./Ext. Permit No.....Date.....

A Filing and Inspection Fee of \$150.00, plus an Entrance Fee of \$..... where applicable, must accompany this application.

Bank # Slade's Ferry Check # 219 Date: 7/11/03 Receipt # 4657

Other requirements: Insp. Only, Sewer Main 8"

Foundation Permit # 814-03

☒ Sewer

Connection made to

Part of jointly-shared private line ☐ Yes ☒ No

☐ Storm Drain

Applicant agrees to abide by the above terms, as well as all pertinent ordinances of the City of New Bedford, and such other special rules as the Commissioner of Public Works may deem necessary

Quante M. Andrade (ms)

Commissioner of Public Works

Acting City Engineer

Catherine Medeiros

Signature of Property Owner or Representative

INSPECTOR'S REPORT

INSPECTED BY: _____

DATE: _____

COMMENTS: _____

☐ APPROVED


☐ DISAPPROVED

SIGNATURE

SKETCH PLAN

82.57

92.44

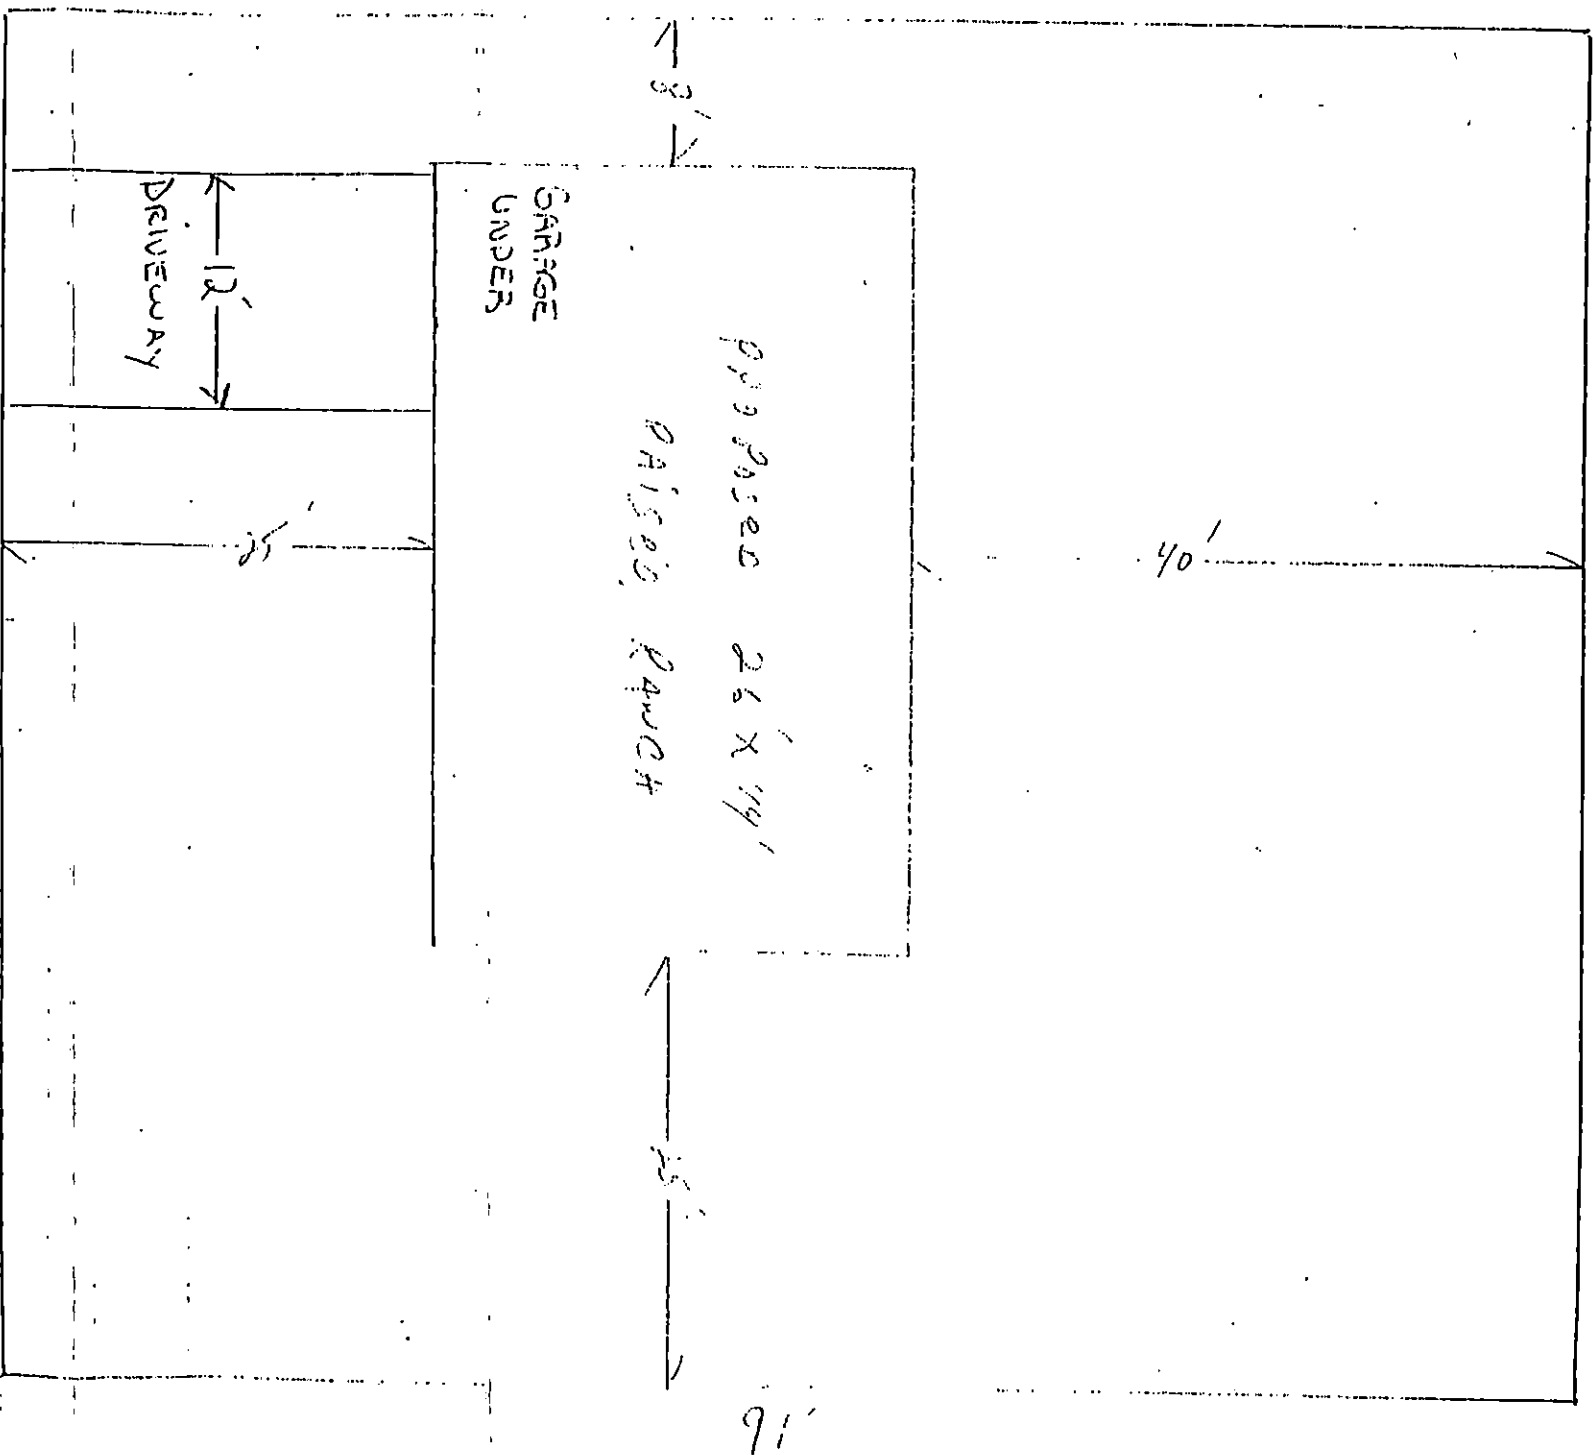

Plot Plan Lot 1

(59)

SUNDAY 40°

9-17-03



WEDNESDAY

HAMLIN ST-SEWER INSP

PERMIT #

Plot / Lot

MENARD BROS / CONTRACTOR
508-895-4022

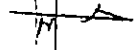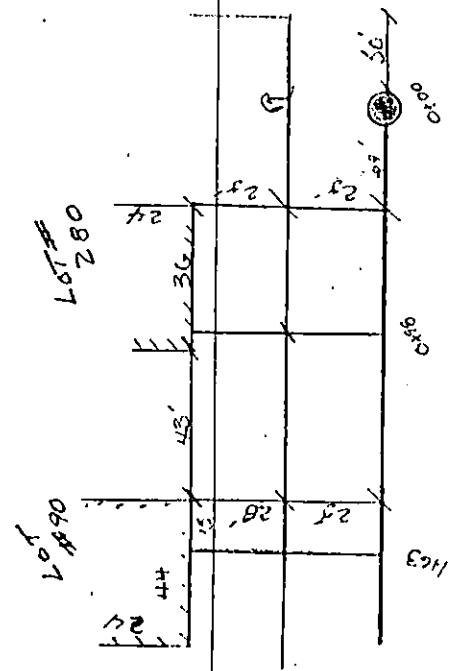

2.10
75
233
72
1+63

ST. HAMLIN

RIVER ROAD

SMH

4+60

3+82

3+10

2+35

1+63

0+98

0+00

SMH

PROPERTY LINE

JEFFERSON AVE

0+00
0+10
0+20
154+

To Whom
IT MY CONCERN

RE. TO SEWER PERMITS
WILL YOU PLEASE HAVE MY
WIFE SIGN MY NAME FOR THE
SEWER PERMITS.

Thank You

Joseph V. Medeiros, Esq.

Thomas ST REALTY LLC.

588.9988118 - fax 588-9988102

7/11/03