

PERMIT NO.
23421



CITY OF NEW BEDFORD
SEWER AND/OR STORM DRAIN PERMIT

DATE 7/11/03
EXP. 7/11/04

This certifies that permission is granted to
Joseph M. Medeiros, Jr. Trs. # 22 Tacklin Hill Rd NB, MA 508-998-8118
Property Owner Address # 22 Tel.
to connect a sewer and/or storm drain located at Hamlin St. (ss) 210' ± W x River Rd.
Assessor's Plot 119, Lot 281, to the sewer and/or storm drain in Hamlin St. Street
to be laid in accordance with the conditions in this application and the City of New Bedford ordinances.

TYPE OF USE: ☒ RESIDENTIAL ☐ COMMERICAL ☐ INDUSTRIAL ☐ OTHER

If applicant other than actual property owner, attach Letter of Authorization from Property Owner.

330 GPD

Name..... Tel.....

Mailing Address.....

The Bonded Contractor/Drain Layer authorized to perform this work is:

Cardoso Contracting, Inc. 12 White St. Acushnet MA 508-998-5115
Name Address Tel.

Type of Pipe Required: PVC SDR-35

PERMIT EXPIRES ONE YEAR AFTER DATE OF ISSUE

- * Requires separate connections for sewage and storm drain where applicable. Storm water cannot be discharged to a sanitary sewer.
- * All work must be inspected and approved by a D.P.W. inspector before backfilling.
- * If this connection is to be part of a private service shared jointly with other building owners, attach copy of Recorded Joint Maintenance Agreement.
- * Permits can be issued to Industrial and/or Commercial Applicants only upon receipt and approval by the Commissioner of Public Works of required plans and supplemental information.
- * In addition, a City-issued Industrial User Discharge Permit and/or a Sewer Extension/Connection Permit issued by the Commonwealth of Massachusetts D.E.P. shall be required by the City for Industrial Discharge into the sewer system.

Industrial User Discharge Permit No..... Date.....

Comm. Mass. Sewer Conn./Ext. Permit No..... Date.....

A Filing and Inspection Fee of \$ 150.00 plus an Entrance Fee of \$..... where applicable, must accompany this application.

Bank # State's Ferry Check # 219 Date: 7/11/03 Receipt # 4657

Other requirements: Insp. Only to Connect to 8"
Sewer Main / Foundation # 813-03

☒ Sewer

Connection made to Part of jointly-shared private line ☐ Yes ☒ No
☐ Storm Drain

Applicant agrees to abide by the above terms, as well as all pertinent ordinances of the City of New Bedford, and such other special rules as the Commissioner of Public Works may deem necessary

Duarte M. Andrade
Commissioner of Public Works
Acting City Engineer

Catherine Medeiros
Signature of Property Owner or Representative

INSPECTOR'S REPORT

INSPECTED BY: 10-26-KEVIN COOPER


DATE: 10-26-04

COMMENTS:

☒ APPROVED ☐ DISAPPROVED

SIGNATURE

21-746

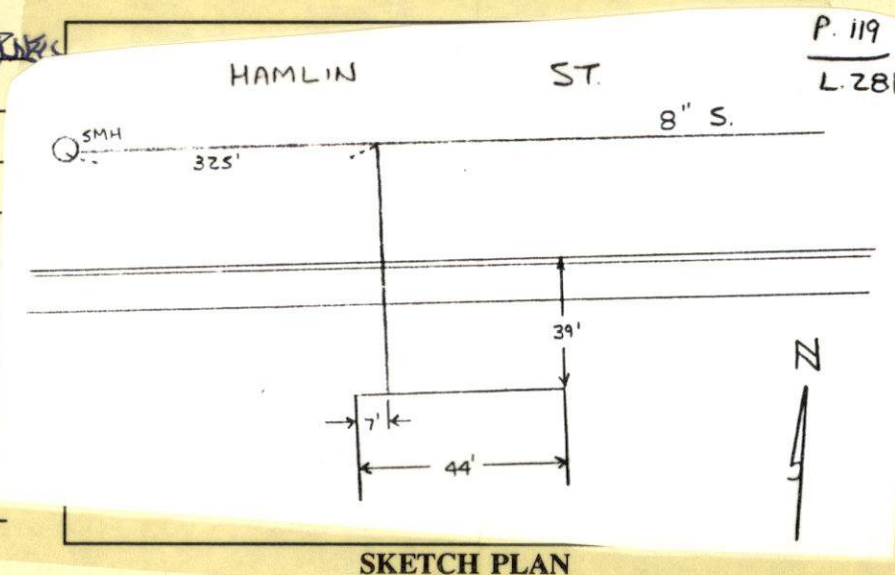

SKETCH PLAN

PERMIT NO.
23421



CITY OF NEW BEDFORD
SEWER AND/OR STORM DRAIN PERMIT

DATE 7/11/03
EXP. 7/11/04

This certifies that permission is granted to

Joseph M. Medeiros, Jr., Trs. 22 Tarklin Hill Rd NB, MA 508-998-8118
Property Owner Address Tel.

to connect a sewer and/or storm drain located at Hamlin St. (55) 210 ± W. River Rd.
Assessor's Plot 119, Lot 281, to the sewer and/or storm drain in Hamlin St. Street

to be laid in accordance with the conditions in this application and the City of New Bedford ordinances.

TYPE OF USE: ☒ RESIDENTIAL ☐ COMMERICAL ☐ INDUSTRIAL ☐ OTHER

330 GPD

If applicant other than actual property owner, attach Letter of Authorization from Property Owner.

Name.....Tel.....

Mailing Address.....

The Bonded Contractor/Drain Layer authorized to perform this work is:

Menard Bros. 307 County Rd
W. Wareham

~~Carcasso Contracting, Inc. 12 White St. Acushnet MA 508-998-5115~~
Name Address 508-995-4022 Tel.

Type of Pipe Required: PVC SDR-35

PERMIT EXPIRES ONE YEAR AFTER DATE OF ISSUE

- * Requires separate connections for sewage and storm drain where applicable. Storm water cannot be discharged to a sanitary sewer.
- * All work must be inspected and approved by a D.P.W. inspector before backfilling.
- * If this connection is to be part of a private service shared jointly with other building owners, attach copy of Recorded Joint Maintenance Agreement.
- * Permits can be issued to Industrial and/or Commercial Applicants only upon receipt and approval by the Commissioner of Public Works of required plans and supplemental information.
- * In addition, a City-issued Industrial User Discharge Permit and/or a Sewer Extension/Connection Permit issued by the Commonwealth of Massachusetts D.E.P. shall be required by the City for Industrial Discharge into the sewer system.

Industrial User Discharge Permit No.....Date.....

Comm. Mass. Sewer Conn./Ext. Permit No.....Date.....

A Filing and Inspection Fee of \$ 150.00 plus an Entrance Fee of \$..... where applicable, must accompany this application.

Bank # Slade's Ferry Check # 219 Date: 7/11/03 Receipt # 4657

Other requirements: Insp. Only to Connect to 8"

Sewer Main/Foundation # 813-03

☒ Sewer

Connection made to

Part of jointly-shared private line ☐ Yes ☒ No

☐ Storm Drain

Applicant agrees to abide by the above terms, as well as all pertinent ordinances of the City of New Bedford, and such other special rules as the Commissioner of Public Works may deem necessary

Duane M. Andrade
Commissioner of Public Works
Acting City Engineer

Catherine Medeiros
Signature of Property Owner or Representative

INSPECTOR'S REPORT

INSPECTED BY: _____

DATE: _____

COMMENTS: _____

☐ APPROVED


☐ DISAPPROVED

SIGNATURE

SKETCH PLAN

HAMLIN

(PUBLIC 45 FEET WIDE 1938 LAYOUT)

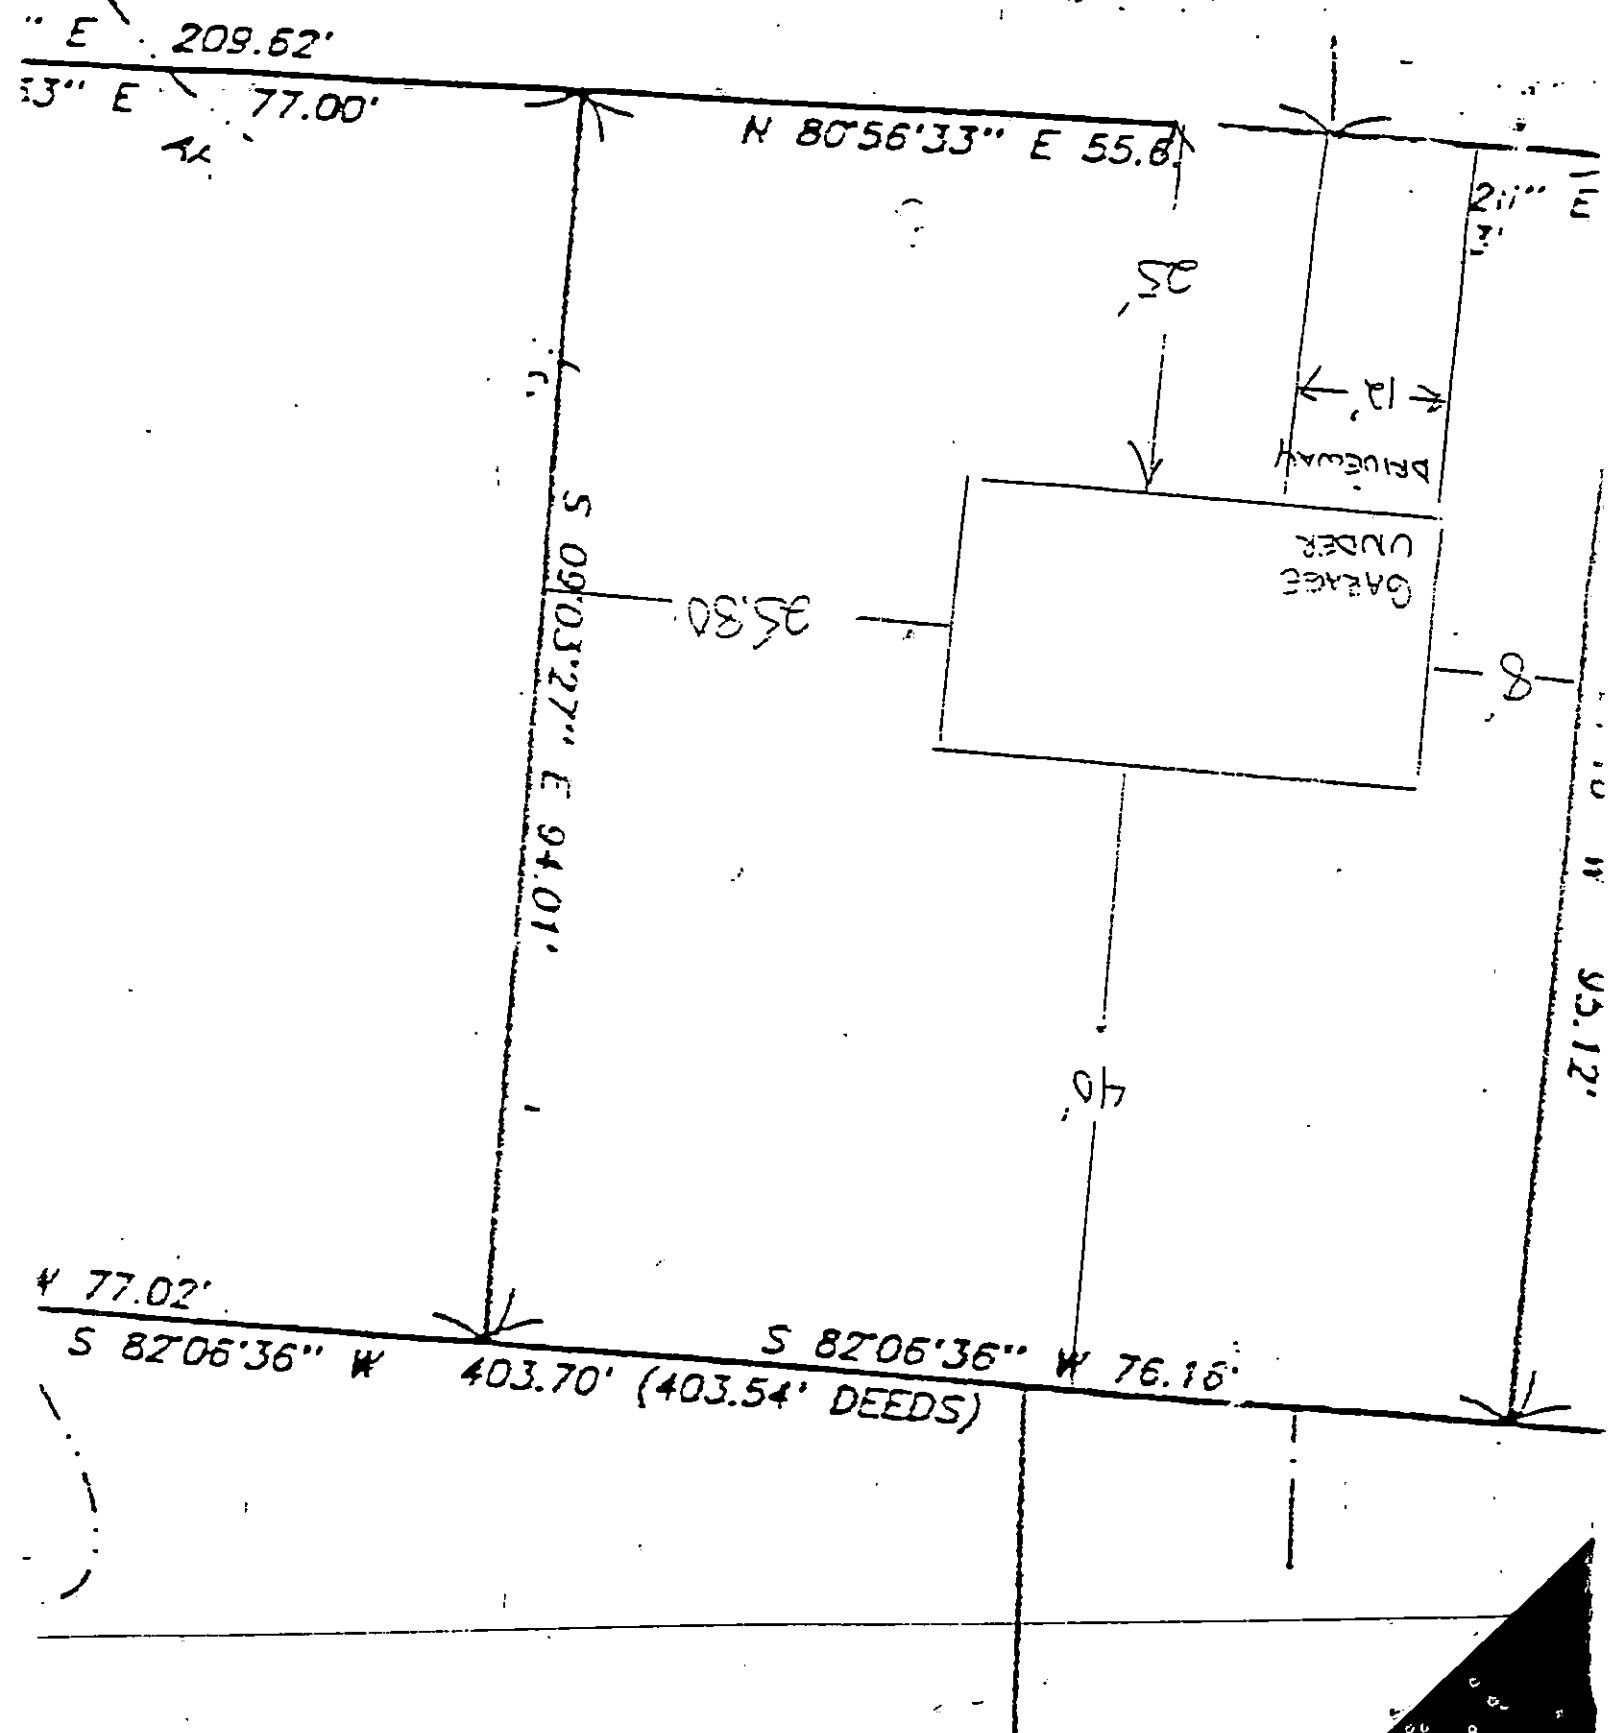

To whom
IT MY CONCERN

RE. TO SEVERAL PERMITS
WILL YOU PLEASE HAVE MY
WIFE SIGN MY NAME FOR THE
SEVERAL PERMITS.


Thank You

Joseph V. Niedzwiedz, Trustee
Hornin ST REALTY LLC.
518-4988118 - fax 502-9988102


7/11/03

3.0
75
235
72
1+63

N

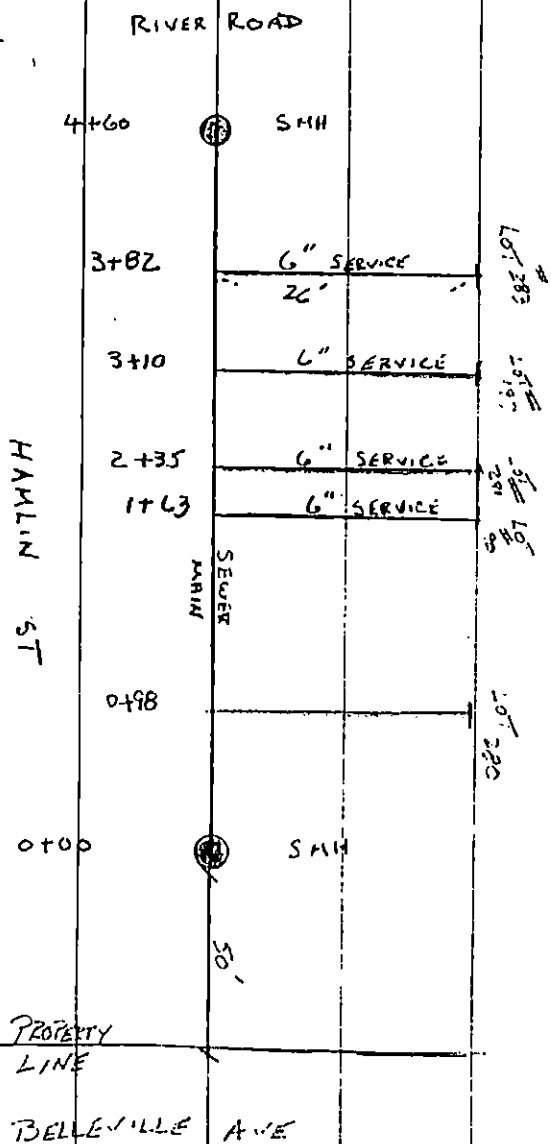

9-17-03
WEDNESDAY
SUNNY 40°
HAMLIN ST- SEWER INSP
PERMIT #
PLOT / LOT
MENARD BROS / CONTRACTOR
508-995-4022

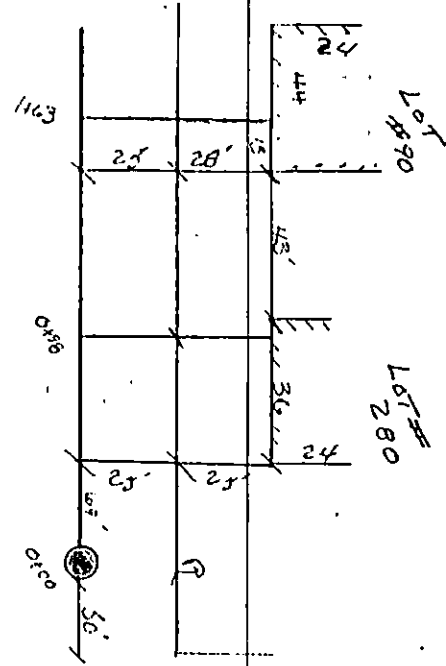

SUNNY MO.


9-17-03
WEDNESDAY

HAMLIN ST - SEWER INSP


PERMIT #

PLOT / LOT

MENARD BROS / CONTRACTOR
508-995-4022

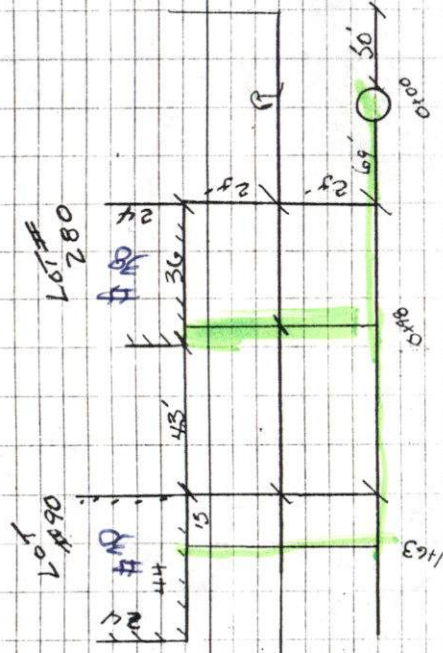

RIVER ROAD

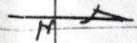

LOT 280

LOT 281

LOT 282

LOT 548

LOT 549

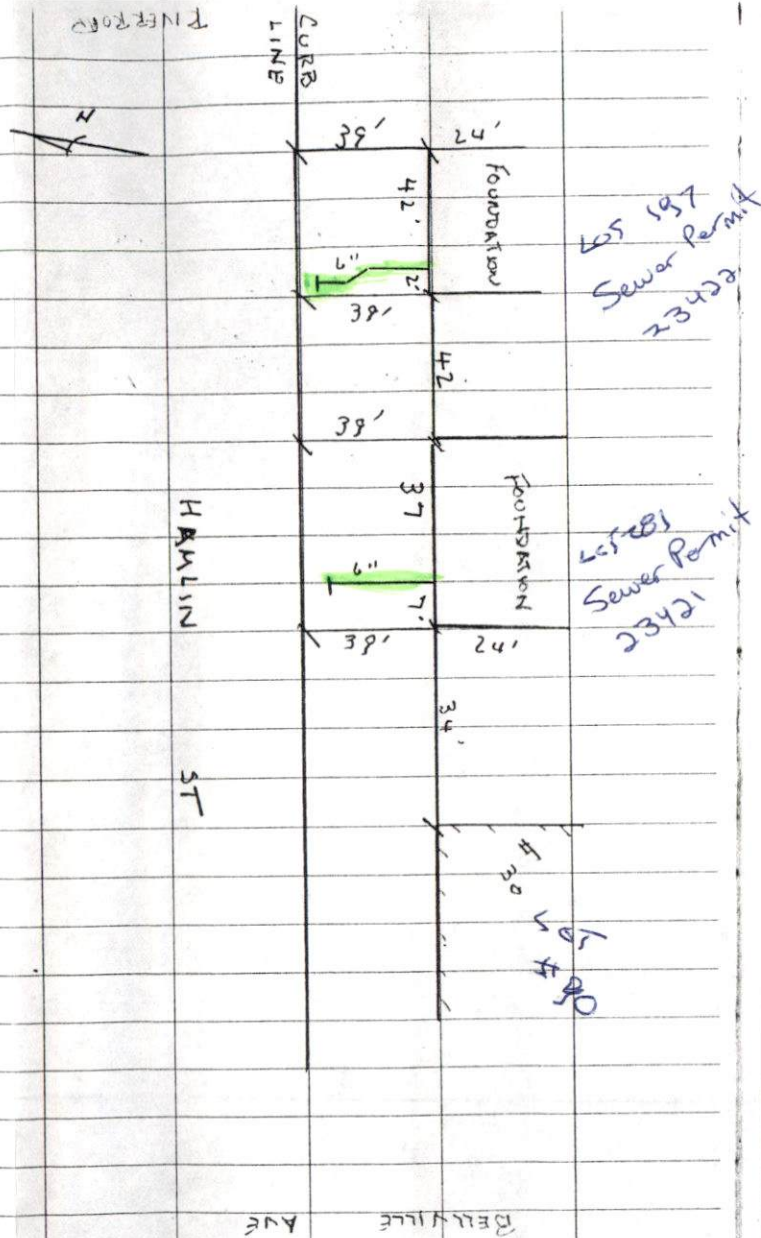

10-26-04

HAMLIN ST SEWER INSP

2-LOTS HAVE TO LOOK UP
PERMIT NUMBERS

MEMPHIS DRO - CONTRACTORS