

PERMIT NO.  
23422



CITY OF NEW BEDFORD  
SEWER AND/OR STORM DRAIN PERMIT

DATE 7/11/03  
EXP 7/11/04

This certifies that permission is granted to

Joseph V. Medeiros, Jr., Trs. 22 Tarklin Hill Rd. NB, MA 508-998-8112  
Property Owner Address #14 Tel.

to connect a sewer and/or storm drain located at Hamlin St. (SS) 120'± W x River Rd.  
Assessor's Plot 119, Lot 197, to the sewer and/or storm drain in Hamlin St. Street

to be laid in accordance with the conditions in this application and the City of New Bedford ordinances.

TYPE OF USE: ☒ RESIDENTIAL ☐ COMMERICAL ☐ INDUSTRIAL ☐ OTHER

330 GPD

If applicant other than actual property owner, attach Letter of Authorization from Property Owner.

Name.....Tel.....

Mailing Address.....

The Bonded Contractor/Drain Layer authorized to perform this work is:

Manoia Brothers  
Cardosa Contracting, Inc. 12 White St. Acushnet MA 508-998-5115  
Name Address Tel.

Type of Pipe Required: PVC SDR-35

PERMIT EXPIRES ONE YEAR AFTER DATE OF ISSUE

- \* Requires separate connections for sewage and storm drain where applicable. Storm water cannot be discharged to a sanitary sewer.
- \* All work must be inspected and approved by a D.P.W. inspector before backfilling.
- \* If this connection is to be part of a private service shared jointly with other building owners, attach copy of Recorded Joint Maintenance Agreement.
- \* Permits can be issued to Industrial and/or Commercial Applicants only upon receipt and approval by the Commissioner of Public Works of required plans and supplemental information.
- \* In addition, a City-issued Industrial User Discharge Permit and/or a Sewer Extension/Connection Permit issued by the Commonwealth of Massachusetts D.E.P. shall be required by the City for Industrial Discharge into the sewer system.

Industrial User Discharge Permit No.....Date.....

Comm. Mass. Sewer Conn./Ext. Permit No.....Date.....

A Filing and Inspection Fee of \$ 150.00 plus an Entrance Fee of \$..... where applicable, must accompany this application.

Bank # State's Ferry Check # 219 Date: 7/11/03 Receipt # 4657

Other requirements: Insp. Only, Sewer Main 8"

Foundation Permit # 815-03

☒ Sewer

Connection made to

Part of jointly-shared private line ☐ Yes ☒ No

☐ Storm Drain

Applicant agrees to abide by the above terms, as well as all pertinent ordinances of the City of New Bedford, and such other special rules as the Commissioner of Public Works may deem necessary

Quate M. Andrade (ms)  
Commissioner of Public Works  
Acting City Engineer

Catherine Medeiros  
Signature of Property Owner or Representative

INSPECTOR'S REPORT

INSPECTED BY: KEVIN CORWELL

DATE: 10-26-04

COMMENTS:

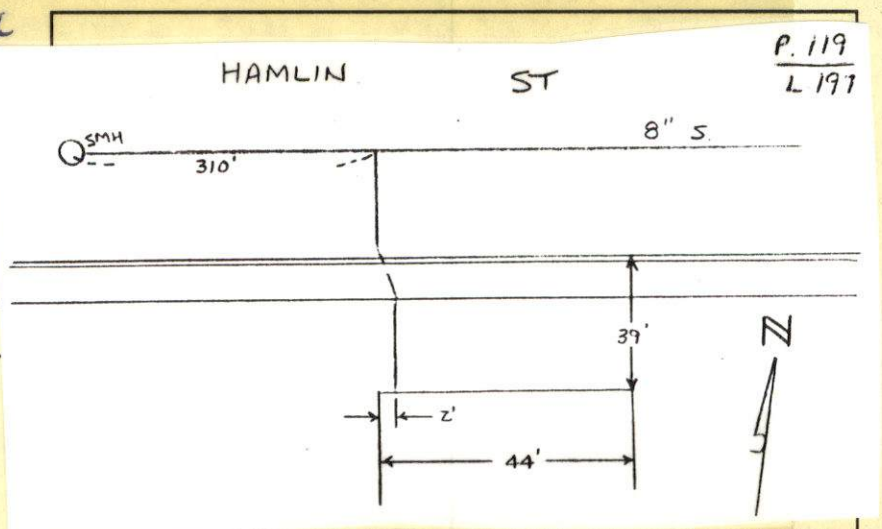
\_\_\_\_\_  
\_\_\_\_\_  
\_\_\_\_\_

☒ APPROVED

☐ DISAPPROVED

Kevin J. Corwell

SIGNATURE



SKETCH PLAN

PERMIT NO.  
23422



CITY OF NEW BEDFORD

DATE 7/11/03  
EXP. 7/11/04

SEWER AND/OR STORM DRAIN PERMIT

This certifies that permission is granted to  
Joseph V. Medeiros, Jr., Trs. 22 Tarklin Hill Rd. NB, MA 508-998-8118  
Property Owner Address Tel.

to connect a sewer and/or storm drain located at Hamlin St (SS) 120'± W x River Rd.  
Assessor's Plot 119, Lot 197, to the sewer and/or storm drain in Hamlin St. Street

to be laid in accordance with the conditions in this application and the City of New Bedford ordinances.

TYPE OF USE: ☒ RESIDENTIAL ☐ COMMERICAL ☐ INDUSTRIAL ☐ OTHER

330 GPD

If applicant other than actual property owner, attach Letter of Authorization from Property Owner.

Name.....Tel.....

Mailing Address.....

The Bonded Contractor/Drain Layer authorized to perform this work is: Menard Bros 307 County Rd. W. Wareham

~~Cordova Contracting Inc 12 White St. Acushnet MA 508-998-5115~~  
Name Address 508-995-4022 Tel.

Type of Pipe Required: PVC SDR-35

PERMIT EXPIRES ONE YEAR AFTER DATE OF ISSUE

- \* Requires separate connections for sewage and storm drain where applicable. Storm water cannot be discharged to a sanitary sewer.
- \* All work must be inspected and approved by a D.P.W. inspector before backfilling.
- \* If this connection is to be part of a private service shared jointly with other building owners, attach copy of Recorded Joint Maintenance Agreement.
- \* Permits can be issued to Industrial and/or Commercial Applicants only upon receipt and approval by the Commissioner of Public Works of required plans and supplemental information.
- \* In addition, a City-issued Industrial User Discharge Permit and/or a Sewer Extension/Connection Permit issued by the Commonwealth of Massachusetts D.E.P. shall be required by the City for Industrial Discharge into the sewer system.

Industrial User Discharge Permit No.....Date.....

Comm. Mass. Sewer Conn./Ext. Permit No.....Date.....

A Filing and Inspection Fee of \$150.00 plus an Entrance Fee of \$..... where applicable, must accompany this application.

Bank # State's Ferry Check # 219 Date: 7/11/03 Receipt # 4657

Other requirements: Insp. Only, Sewer Main 8"  
Foundation Permit # 815-03

☒ Sewer

Connection made to Part of jointly-shared private line ☐ Yes ☒ No

☐ Storm Drain

Applicant agrees to abide by the above terms, as well as all pertinent ordinances of the City of New Bedford, and such other special rules as the Commissioner of Public Works may deem necessary

Quate M. Andrade (ms)  
~~Commissioner of Public Works~~  
Acting City Engineer

Catherine Medeiros  
Signature of Property Owner or Representative

INSPECTOR'S REPORT

INSPECTED BY: \_\_\_\_\_

DATE: \_\_\_\_\_

COMMENTS: \_\_\_\_\_

\_\_\_\_\_

\_\_\_\_\_

\_\_\_\_\_

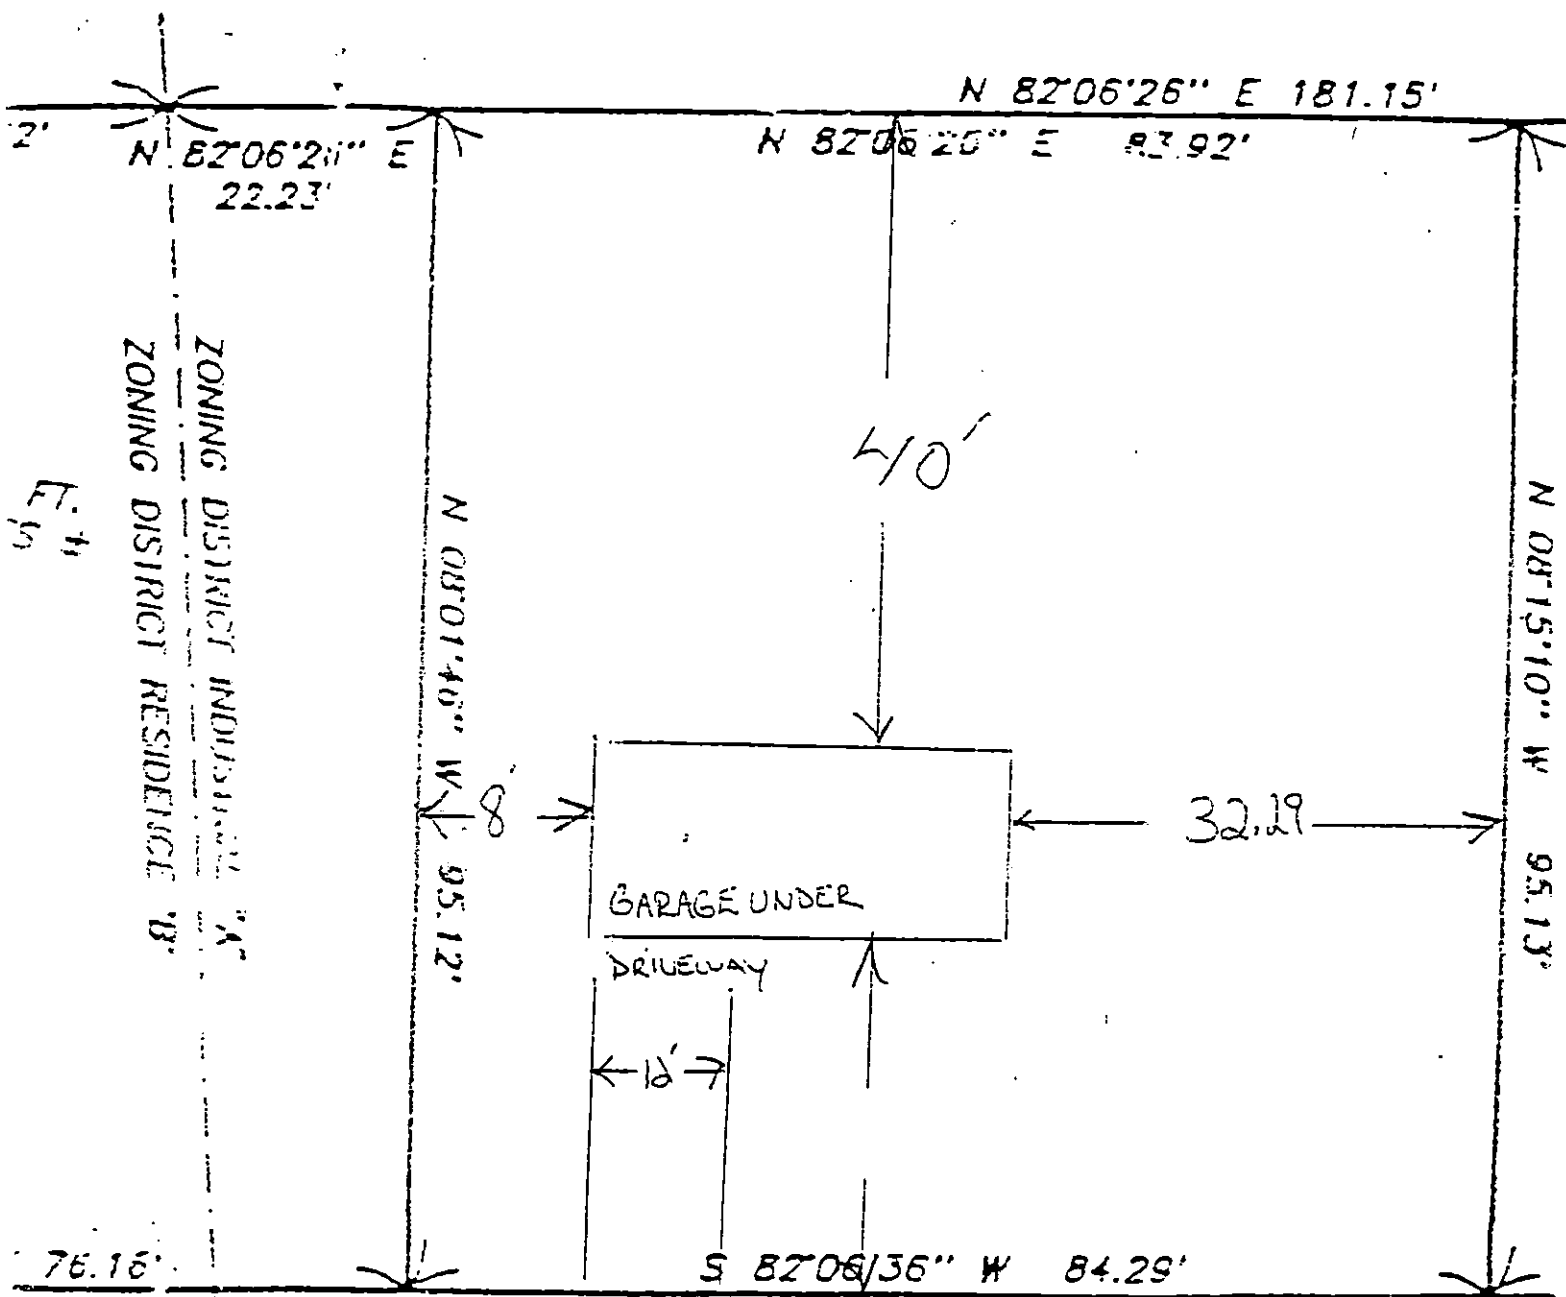
☐ APPROVED

☐ DISAPPROVED

SIGNATURE

SKETCH PLAN

AYOUT) STREET



119-16  
N/F  
DAVID AND MAE  
RAWCLIFF  
L.C. 9093A

7/11/03

To Whom  
IT MY CONCERN

RE. TO SEWER PERMITS  
WILL YOU PLEASE HAVE MY  
WIFE SIGN MY NAME FOR THE  
SEWER PERMITS.

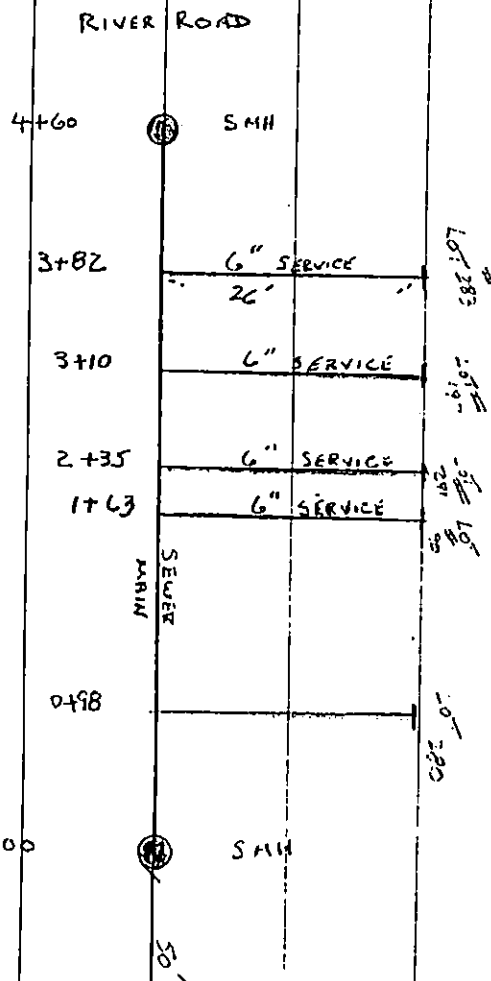
Thank You  
Joseph V. Madenjian Jr. Trustee  
HOMER ST REALTY LLC.  
508-9988118 - FAX 508-9988102

310  
 75  
 235  
 72  
 163

HAMLIN ST

PROPERTY LINE

BELLEVILLE AVE




9-17-03  
 WEDNESDAY


SUNNY 40°

HAMLIN ST-SEWER INSP  
 PERMIT #

PLOT / LOT

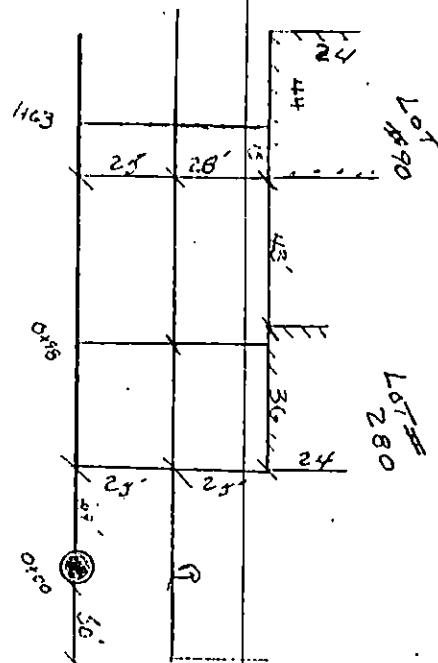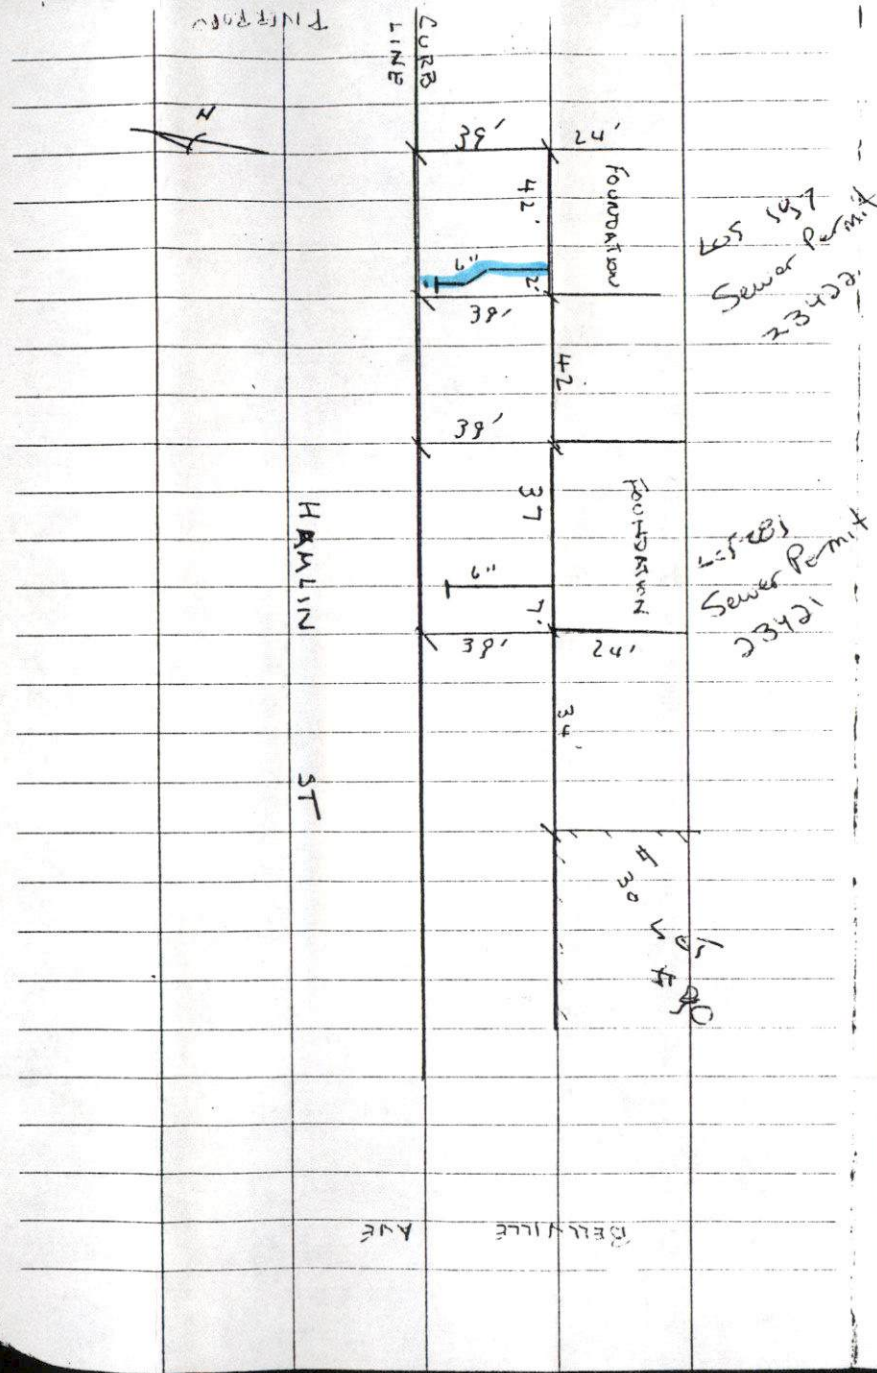MENARD BROS / CONTRACTOR  
 508-995-4022






WEDNESDAY

PERMIT

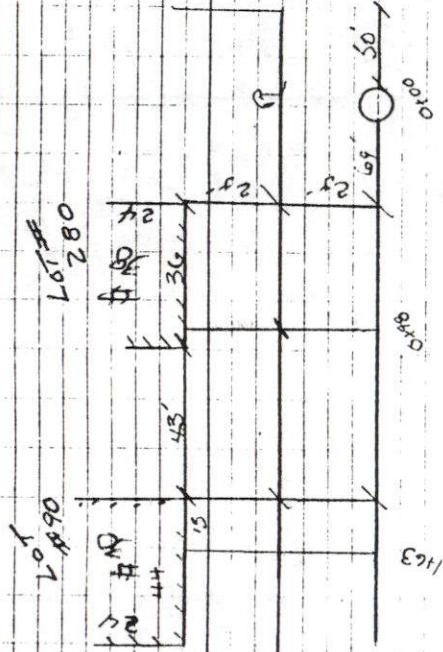508-995-4022  
MENARD Bros / CONTRACTOR



HAMLIN  
15

8540

0+0

HW 5

PROPERTY LINE

| |
|---|
| 36  | 37  | 38  | 99  | 100 |     |     | 101 | 102 | 103 | 200 |

