

PERMIT NO.

23432



CITY OF NEW BEDFORD

DATE...8-6-03.....

SEWER AND/OR STORM DRAIN PERMIT

This certifies that permission is granted to

Cristina / Joseph Gonçalves 13 Pine Ridge St. 508.996.0505..
Property Owner Address Tel.

to connect a sewer and/or storm drain located at Pine Ridge St.
Assessor's Plot..121...., Lot...7.7...., to the sewer and/or storm drain in Pine Ridge St. Street
to be laid in accordance with the conditions in this application and the City of New Bedford ordinances.

TYPE OF USE: ☒ RESIDENTIAL ☐ COMMERCIAL ☐ INDUSTRIAL ☐ OTHER

330 g.p.d.

If applicant other than actual property owner, attach Letter of Authorization from Property Owner.

Name.....Tel.....

Mailing Address.....

The Bonded Contractor/Drain Layer authorized to perform this work is:

Nelson Cardozo 12 White St. Acushnet 508.998.5115..
Name Address Tel.

Type of Pipe Required: pvc sdr-35

PERMIT EXPIRES ONE YEAR AFTER DATE OF ISSUE 8-6-04

- * Requires separate connections for sewage and storm drain where applicable. Storm water cannot be discharged to a sanitary sewer.
- * All work must be inspected and approved by a D.P.W. inspector before backfilling.
- * If this connection is to be part of a private service shared jointly with other building owners, attach copy of Recorded Joint Maintenance Agreement.
- * Permits can be issued to Industrial and/or Commercial Applicants only upon receipt and approval by the Commissioner of Public Works of required plans and supplemental information.
- * In addition, a City-issued Industrial User Discharge Permit and/or a Sewer Extension/Connection Permit issued by the Commonwealth of Massachusetts D.E.P. shall be required by the City for Industrial Discharge into the sewer system.

Industrial User Discharge Permit No.....Date.....

Comm. Mass. Sewer Conn./Ext. Permit No.....Date.....

A Filing and Inspection Fee of \$150.00 plus an Entrance Fee of \$550.00 where applicable, must accompany this application.

Bank # First Fed Check # 1067 Date: 8-6-03 Receipt # 4684

Other requirements: inspection only - stub exists

Connection made to ☒ Sewer ☐ Storm Drain
Part of jointly-shared private line ☐ Yes ☒ No

FOR INSPECTION ONLY, A 24 HOUR NOTICE IS REQUIRED AND THE CONTRACTOR/APPLICANT IS REQUIRED TO NOTIFY THE ENGINEERING DIVISION AT 979-1527

Applicant agrees to abide by the above terms, as well as all pertinent ordinances of the City of New Bedford, and such other special rules as the Commissioner of Public Works may deem necessary

Quarte M. Andrade
Acting City Engineer mn

Cristina J. Gonçalves
Signature of Property Owner or Representative

INSPECTOR'S REPORT

INSPECTED BY: Paulo Condez


DATE: 8/18/03

COMMENTS:

☒ APPROVED ☐ DISAPPROVED

Paulo Condez

SIGNATURE

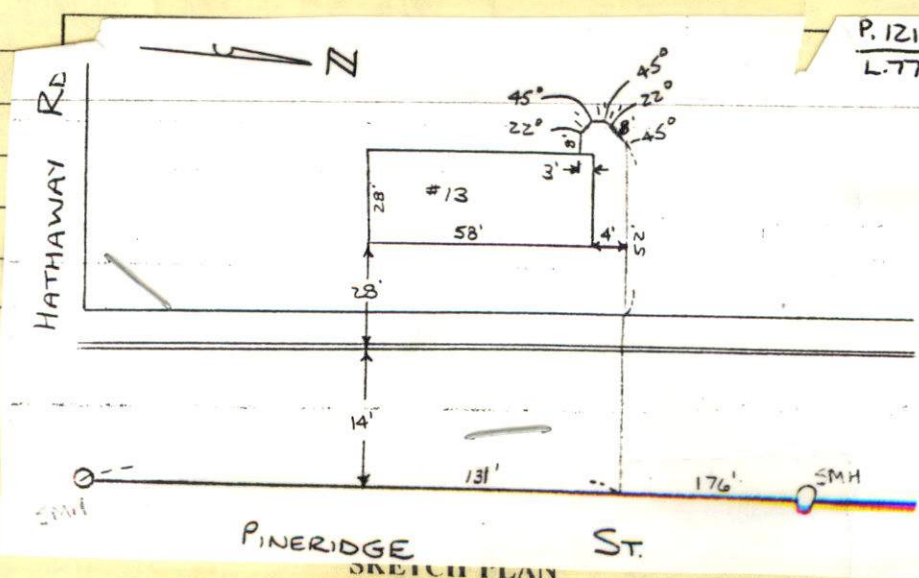

PERMIT NO.
23432



CITY OF NEW BEDFORD

DATE 8-6-03

SEWER AND/OR STORM DRAIN PERMIT

This certifies that permission is granted to

Cristina / Joseph Gonçalves 13 Pine Ridge St. 508.996.0505
Property Owner Address Tel.

to connect a sewer and/or storm drain located at Pine Ridge St.
Assessor's Plot 121, Lot 7.7, to the sewer and/or storm drain in Pine Ridge St. Street
to be laid in accordance with the conditions in this application and the City of New Bedford ordinances.

TYPE OF USE: ☒ RESIDENTIAL ☐ COMMERCIAL ☐ INDUSTRIAL ☐ OTHER

If applicant other than actual property owner, attach Letter of Authorization from Property Owner.

330 g.p.d.

Name Tel.

Mailing Address

The Bonded Contractor/Drain Layer authorized to perform this work is:

Nelson Cardoso 12 White St. Acushnet 508.998.5115
Name Address Tel.

Type of Pipe Required: pvc sdr-35

PERMIT EXPIRES ONE YEAR AFTER DATE OF ISSUE 8-6-04

* Requires separate connections for sewage and storm drain where applicable. Storm water cannot be discharged to a sanitary sewer.

* All work must be inspected and approved by a D.P.W. inspector before backfilling.

* If this connection is to be part of a private service shared jointly with other building owners, attach copy of Recorded Joint Maintenance Agreement.

* Permits can be issued to Industrial and/or Commercial Applicants only upon receipt and approval by the Commissioner of Public Works of required plans and supplemental information.

* In addition, a City-issued Industrial User Discharge Permit and/or a Sewer Extension/Connection Permit issued by the Commonwealth of Massachusetts D.E.P. shall be required by the City for Industrial Discharge into the sewer system.

Industrial User Discharge Permit No. Date

Comm. Mass. Sewer Conn./Ext. Permit No. Date

A Filing and Inspection Fee of \$150.00, plus an Entrance Fee of \$550.00 where applicable, must accompany this application.

Bank # First Fed Check # 1067 Date: 8-6-03 Receipt # 4684

Other requirements: inspection only - stub exists

☒ Sewer

Connection made to

☐ Storm Drain

Part of jointly-shared private line ☐ Yes ☒ No

FOR INSPECTION ONLY, A 24 HOUR
NOTICE IS REQUIRED AND THE
CONTRACTOR/APPLICANT IS
REQUIRED TO NOTIFY THE
ENGINEERING DIVISION AT 979-1527

Applicant agrees to abide by the above terms, as well as all pertinent ordinances of the City of New Bedford, and such other special rules as the Commissioner of Public Works may deem necessary

Quate M. Andrade

Acting City Engineer mn

Cristina H. Gonçalves

Signature of Property Owner or Representative

INSPECTOR'S REPORT

INSPECTED BY:

DATE:

COMMENTS:

☐ APPROVED

☐ DISAPPROVED

SIGNATURE

SKETCH PLAN

03-4

MODIFIED

FEE

\$ 50.00

COMMONWEALTH OF MASSACHUSETTS

DEPARTMENT OF INSPECTIONAL SERVICES
Environmental Health Division

Board of Health, New Bedford, MA.

FOR DISPOSAL SYSTEM CONSTRUCTION PERMIT

Application for a Permit to ~~Construct~~ ☒ Complete System ☐ Individual Components ☐ Abandonment

Location	13 Pine Ridge St. N.B.
Map Parcel#	121
Lot#	77
Installer's Name	Nelson Cardoso
Address	
Telephone#	
Owner's Name	Joseph & Christina Goncalves
Address	13 Pine Ridge St. N.B.
Telephone#	508 996-0505
Designer's Name	
Address	
Telephone#	

Type of Building	
Dwelling - No. of Bedrooms	
Other - Type of Building	
Other Features	
Design flow min. required	gpd
Design flow provided	gpd
Plan Date	
Number of Inlets	
Revision Date	
Name of Soil Engineer	
Date of Evaluation	

DESCRIPTION OF REPAIRS OR ALTERATIONS
Abandon system, tie into city
sewer.
owner C.H. Stenmark
The undersigned agrees to install the above described Individual Sewage Disposal System in accordance with the provisions of TITLE 5 and further agrees to not to place the system in operation until a Certificate of Compliance has been issued by the Board of Health.
Signed PPW permit 23432 Date 8/6/03

Inspections	
Description of Work: ☐ Individual Component(s) ☒ Complete System	
The undersigned hereby certifies that the Sewage Disposal System: Constructed () Repaired () Upgraded () Abandoned ()	
by <u>JOSEPH & CHRISTINA GONCALVES</u>	
at <u>13 PINE RIDGE ST. NEW BEDFORD</u>	
has been installed in accordance with the provisions of 310 CMR 15.00 (Title 5) and the approved design plans/as-built plans relating to application No. <u>DPW 23432</u> dated <u>8/6/03</u> Approved Design Flow (gpd)	
Installer <u>NELSON CARDOSO 12 WHITE ST. ACUSHNET MA</u>	
Inspector <u>Jim Gaudin</u> Date: <u>9-3-03</u>	

CERTIFICATE OF COMPLIANCE


Board of Health, New Bedford, MA.


COMMONWEALTH OF MASSACHUSETTS

FEE \$ 50.00

COPY

N →

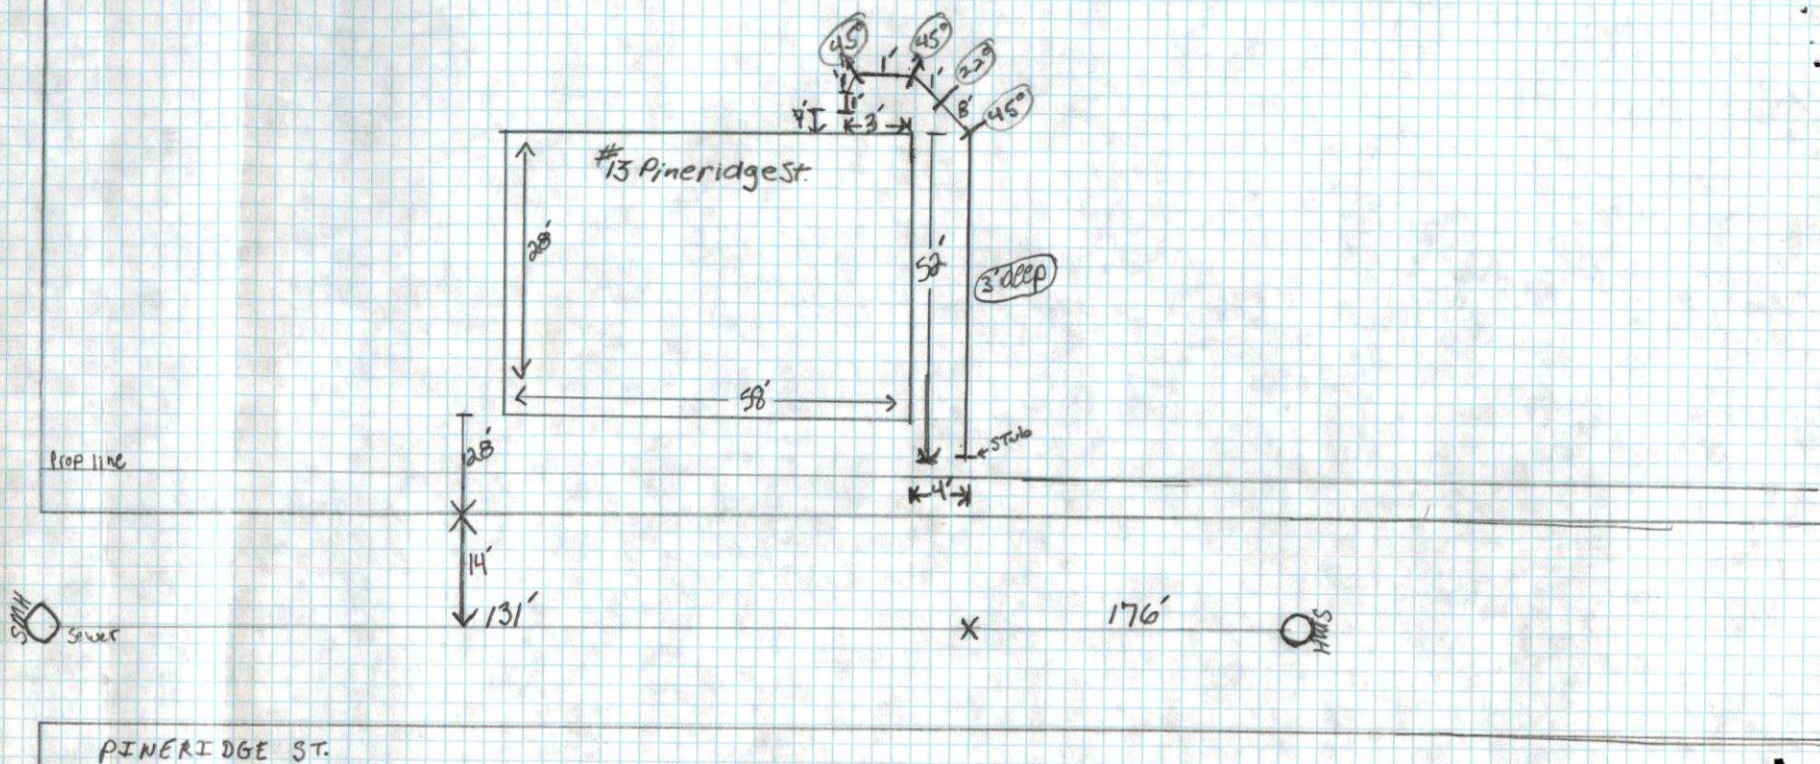

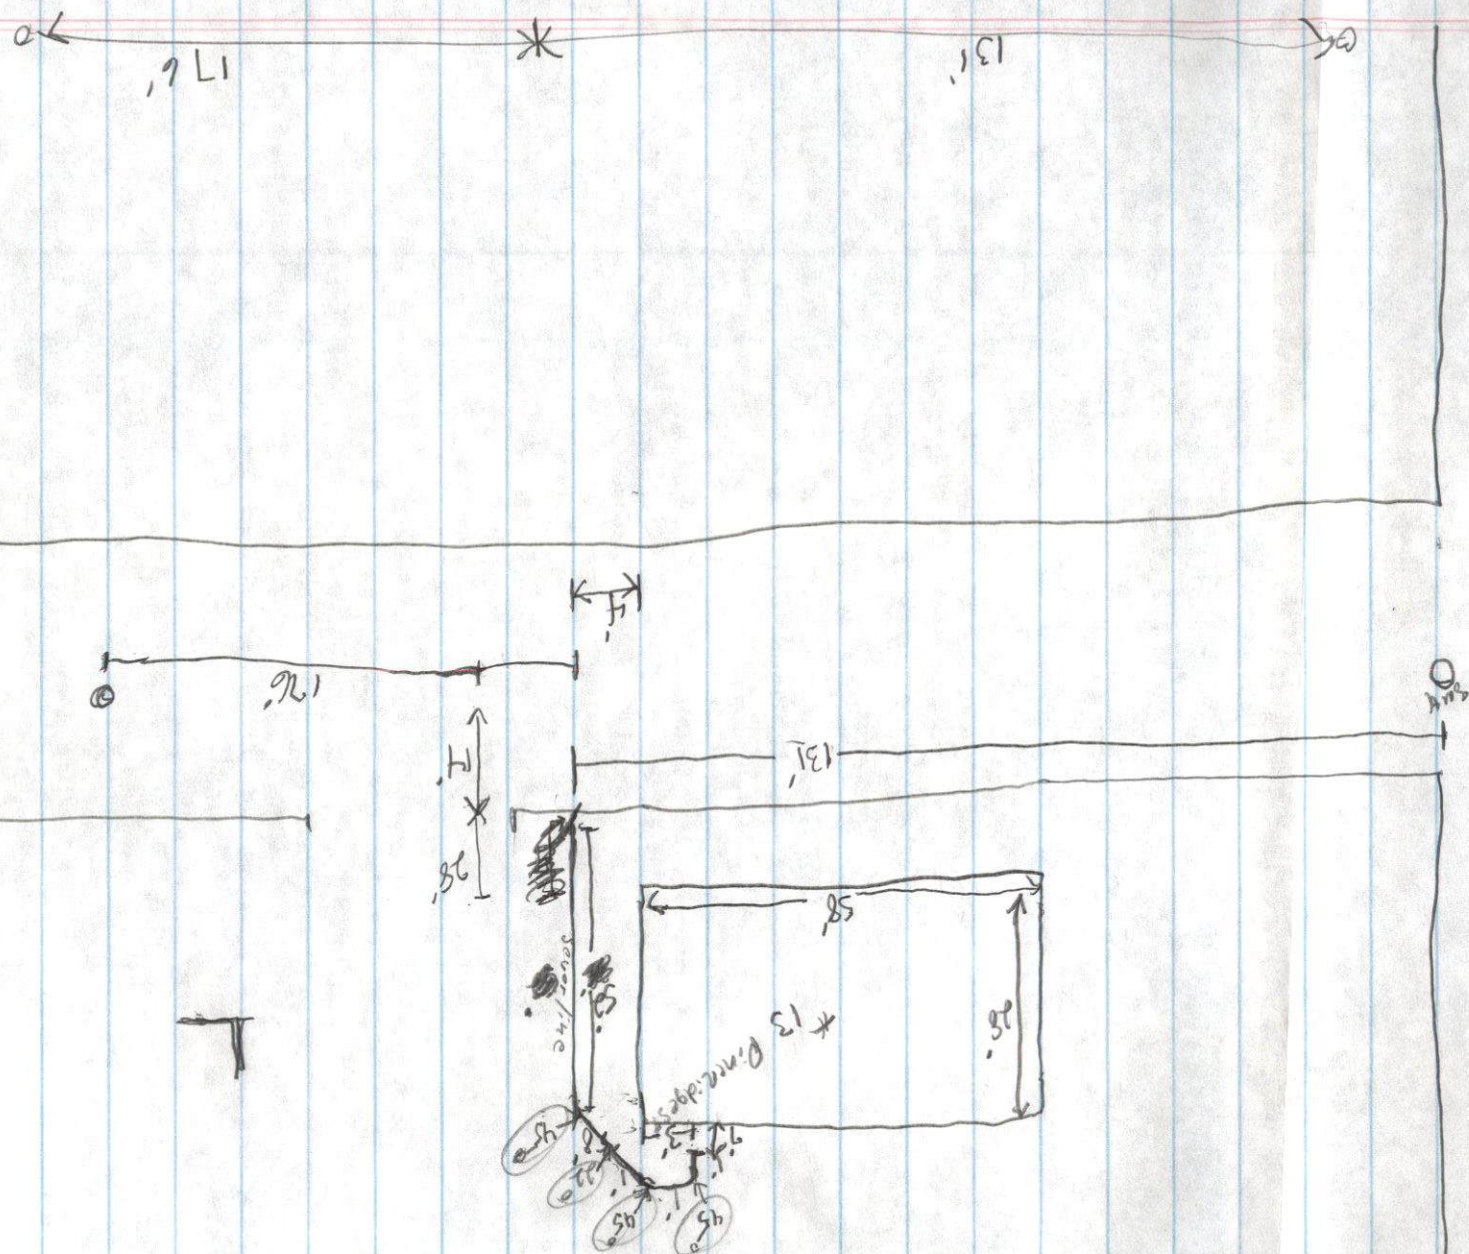

REPAIR SHOP

8-18-03

Date

location

13 Pine Ridge St.

permit # 23432

description of work


Sewer Inspection

work done

to Mon.

10:30 - 11:00

for Nelson Cardosa

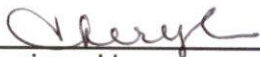

signed by

ON LOT / B-CARD P402G. Paul