

2 pm Friday 11/21/03



PERMIT NO.
23473

CITY OF NEW BEDFORD
SEWER AND/OR STORM DRAIN PERMIT

DATE 10/10/03
EXP. 10/10/04

This certifies that permission is granted to

Stephen Pina 6 Spruce St. New Bedford 508-992-8423
Property Owner Address Tel.

To connect a sewer and/or storm drain located at 182 Liberty St. Maxfield St.

Assessor's Plot 51 Lot 10, to the sewer and/or storm drain in Maxfield St. Street

To be laid in accordance with the conditions in this application and the City of New Bedford ordinances.

TYPE OF USE: RESIDENTIAL COMMERCIAL INDUSTRIAL OTHER ZOO GPD

If applicant other than actual property owner, attach Letter of Authorization from Property Owner.

Name Mailing Address Tel.

The Bonded Contractor/Drain Layer authorized to perform this work is:
Paga Contracting 123 High Hill Rd. Marlborough MA 508-995-1700

Name Address Tel.
Type of Pipe Required: PVC SDR-35

PERMIT EXPIRES ONE YEAR AFTER DATE OF ISSUE

- Requires separate connections for sewage and storm drain where applicable. Storm water cannot be discharged to a sanitary sewer.
 - All work must be inspected and approved by a D.P.I. inspector before backfilling.
 - If this connection is to be part of a private service shared jointly with other building owners, attach copy of Recorded Joint Maintenance Agreement.
 - Permits can be issued to Industrial and/or Commercial Applicants only upon receipt and approval by the Commissioner of Public Infrastructure of required plans and supplemental information.
 - In addition, a City-issued Industrial User Discharge Permit and/or a Sewer Extension/Connection Permit issued by the Commonwealth of Massachusetts D.E.P. shall be required by the City for Industrial Discharge into the sewer system.
- Industrial User Discharge Permit No. Date.

Comm. Mass. Sewer Conn./Ext. Permit No. Date.
A Filing and Inspection Fee of \$150, plus an Entrance Fee of \$ where applicable, must accompany this application.


Bank# CASH Check# Date 10/10/03 Receipt# 567

Other requirements: Insp. Only. Connect to 10" Sewer in Maxfield St.
from mdc trap

Connection made to
Sewer
Storm Drain


Applicant agrees to abide by the ab
other special rules as the Commissio
Duarte M. Gindran
City Engineer

INSPECTED BY: PAULO COM.
DATE: 11/21/03
COMMENTS:

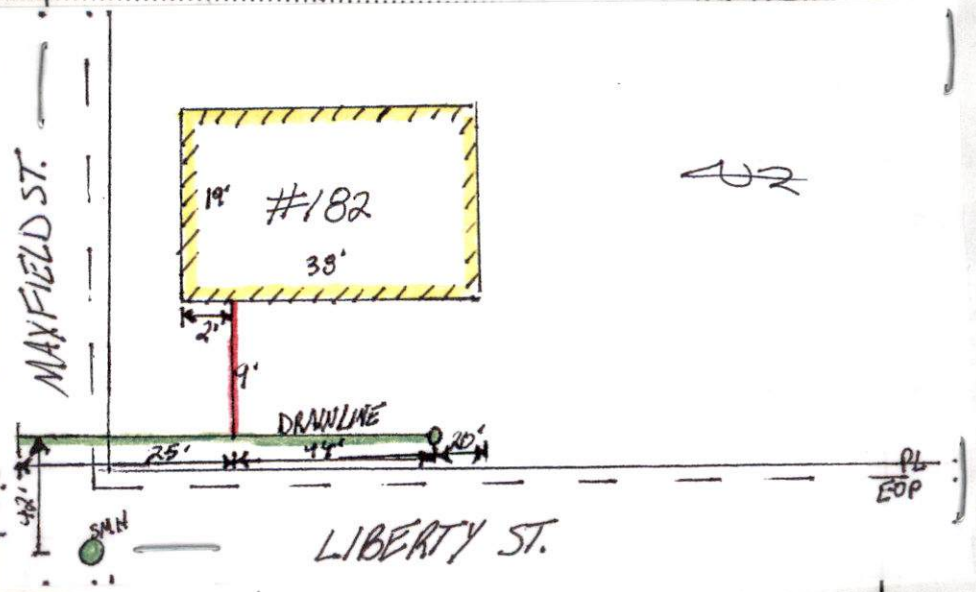

APPROVED DISAPPROVED

ON PLAT/NO CARD NO YELLOW P 83 OF ORIGINAL

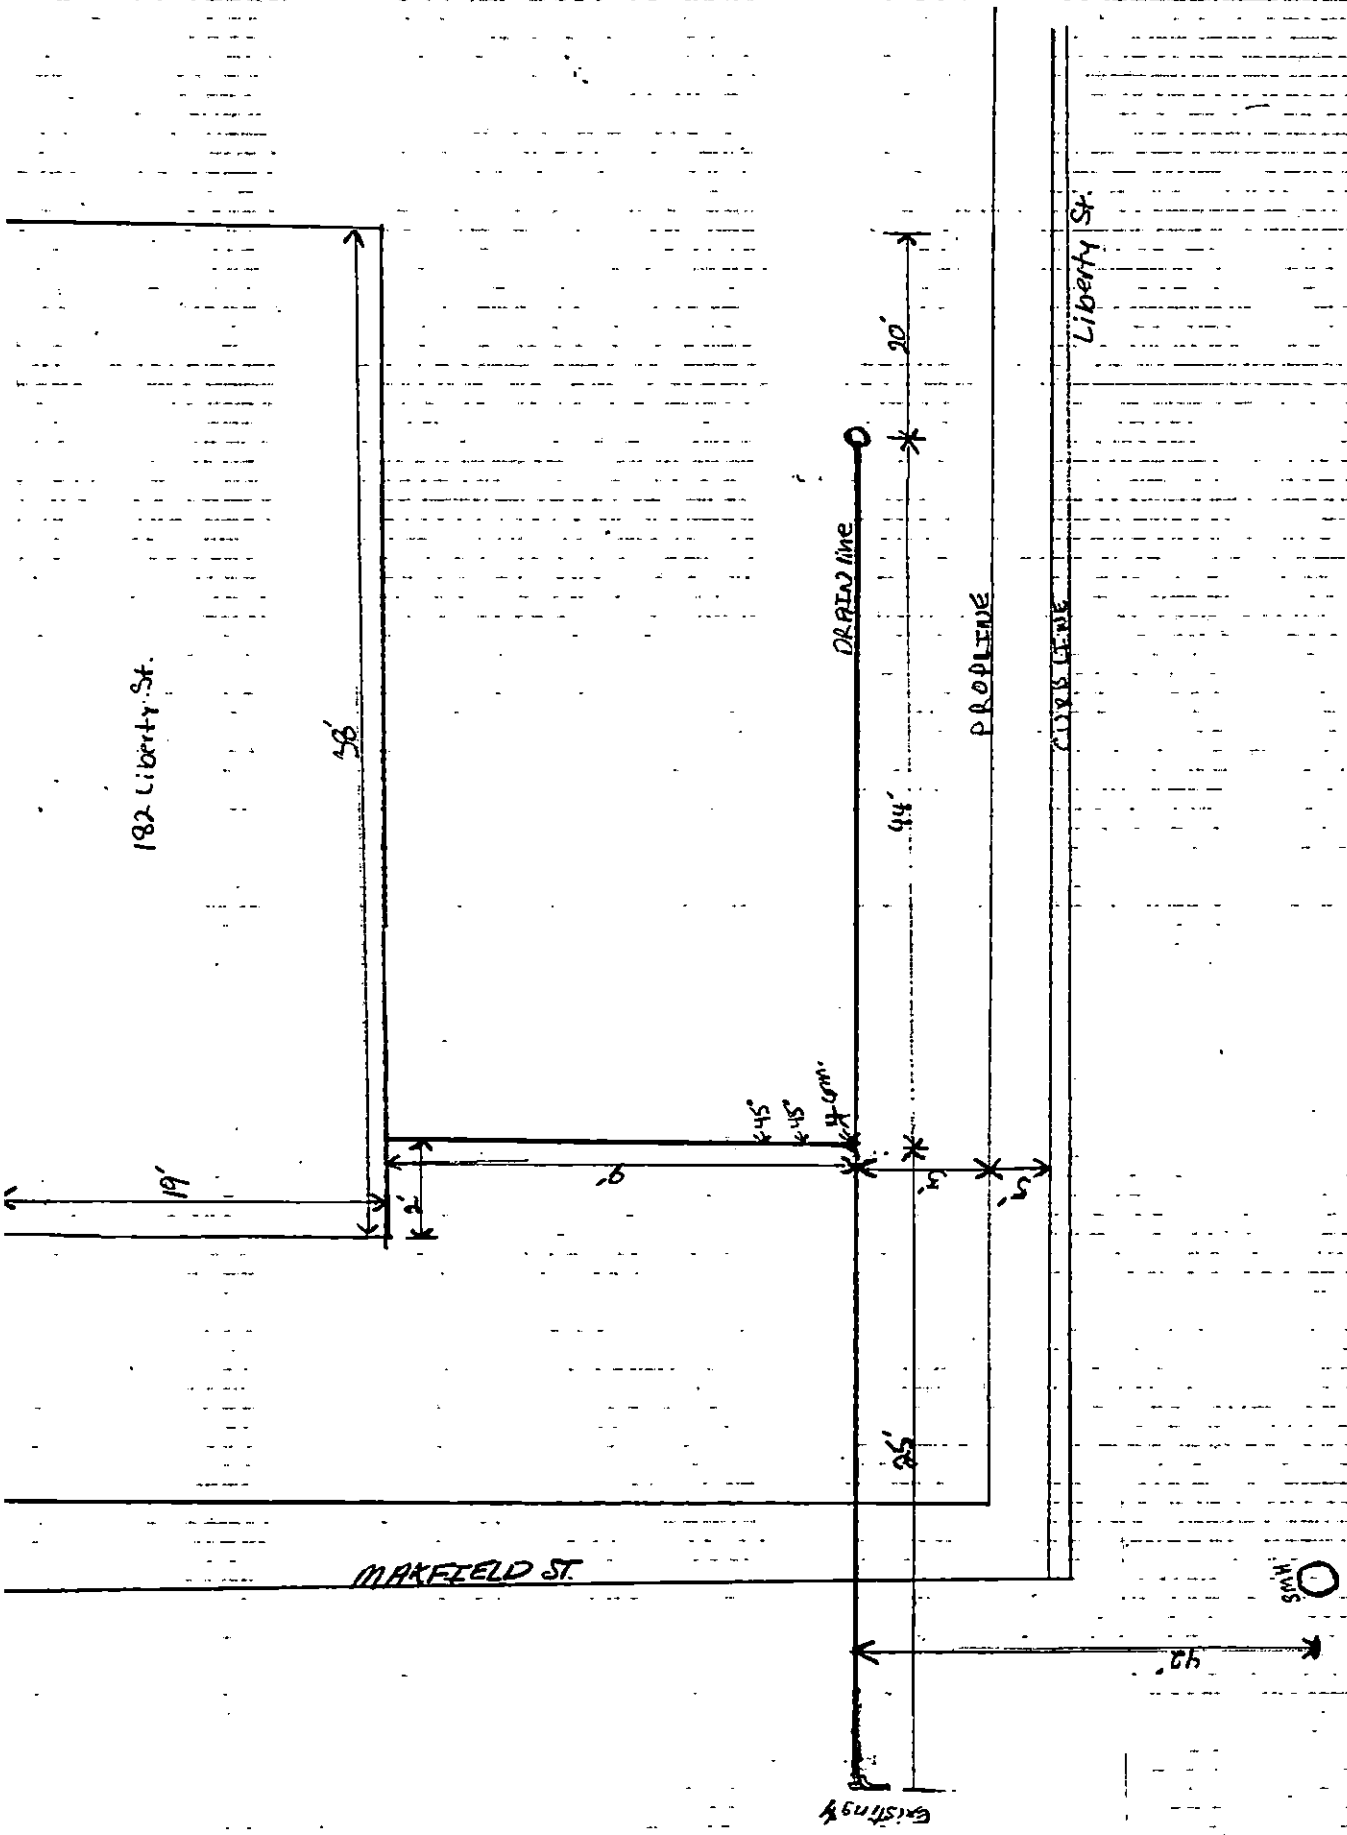

PAUL CONDEZ