



PERMIT NO.

23475

CITY OF NEW BEDFORD
SEWER AND/OR STORM DRAIN PERMIT

DATE 10/14/03

This certifies that permission is granted to

Carmen Umbelina 873 Tradewind St. NB MA 508 990 0878
Property Owner Address Tel.

To connect a sewer and/or storm drain located at 873 Tradewind St.

Assessor's Plot 73 Lot 18, to the sewer and/or storm drain in Tradewind St.

To be laid in accordance with the conditions in this application and the City of New Bedford ordinances.

TYPE OF USE: ☒ RESIDENTIAL ☐ COMMERCIAL ☐ INDUSTRIAL ☐ OTHER400 gpd.
550 gpd

If applicant other than actual property owner, attach Letter of Authorization from Property Owner.

Name Tel.

Mailing Address

The Bonded Contractor/Drain Layer authorized to perform this work is:

R. J. Canessa P.O. Box 51643 NB MA 508-993-9508
Name Address Tel.

Type of Pipe Required: SDR 35 PVC

PERMIT EXPIRES ONE YEAR AFTER DATE OF ISSUE 10/14/04

- Requires separate connections for sewage and storm drain where applicable. Storm water cannot be discharged to a sanitary sewer.
 - All work must be inspected and approved by a D.P.I. inspector before backfilling.
 - If this connection is to be part of a private service shared jointly with other building owners, attach copy of Recorded Joint Maintenance Agreement.
 - Permits can be issued to Industrial and/or Commercial Applicants only upon receipt and approval by the Commissioner of Public Infrastructure of required plans and supplemental information.
 - In addition, a City-issued Industrial User Discharge Permit and/or a Sewer Extension/Connection Permit issued by the Commonwealth of Massachusetts D.E.P. shall be required by the City for Industrial Discharge into the sewer system.
- Industrial User Discharge Permit No. Date.

Comm. Mass. Sewer Conn./Ext. Permit No. Date.

A Filing and Inspection Fee of \$150.00 plus an Entrance Fee of \$440.00 where applicable, must accompany this application.

Bank# 6020 Check# 2459 Date 10-14-03 Receipt# 4756

Other requirements: 8" sewer

24 hr. inspection

Connection made to ☒ Sewer ☐ Storm Drain Part of jointly-shared private line YES ☒ NO Carmen Umbelina

Applicant agrees to abide by the above terms, as well as all pertinent ordinances of the City of New Bedford, and such other special rules as the Commissioner of Public Infrastructure and/or City Engineer may deem necessary

Duarte M. Andrade
Acting City Engineer mn

Signature of Property Owner or Representative

INSPECTOR'S REPORT


INSPECTED BY: KEVIN J CORNELL

DATE: 10-23-03

COMMENTS:

APPROVED

DISAPPROV

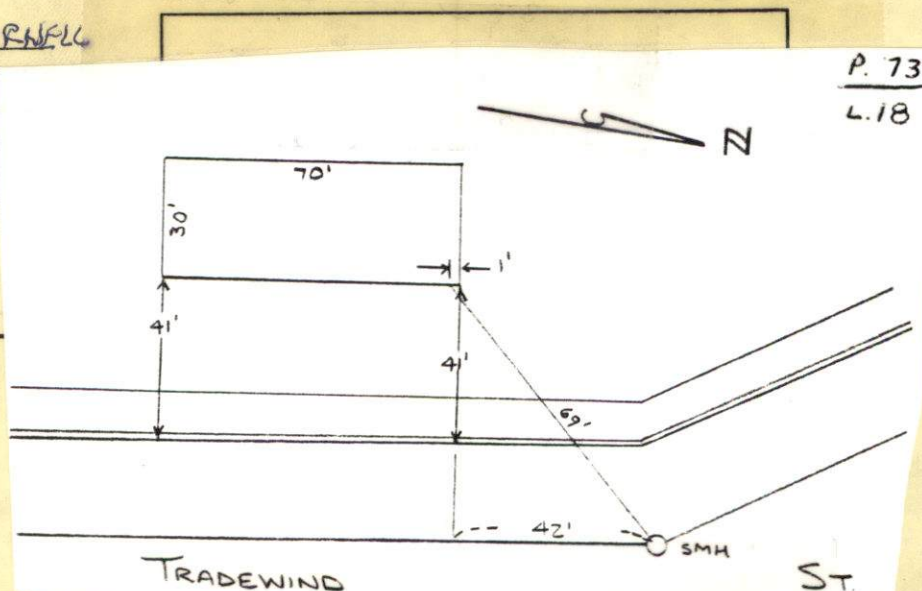Kevin J Cornell
SIGNATURE

13' sw's



PERMIT NO.

23475

CITY OF NEW BEDFORD
SEWER AND/OR STORM DRAIN PERMIT

DATE 10/14/03

This certifies that permission is granted to

Carmen Umbelina 873 Tradewind St. NB MA 508 9900878
Property Owner Address Tel.

To connect a sewer and/or storm drain located at 873 Tradewind St.

Assessor's Plot 73 Lot 18, to the sewer and/or storm drain in Tradewind Street

To be laid in accordance with the conditions in this application and the City of New Bedford ordinances.

TYPE OF USE: ☒ RESIDENTIAL ☐ COMMERCIAL ☐ INDUSTRIAL ☐ OTHER 550 g.p.d.

If applicant other than actual property owner, attach Letter of Authorization from Property Owner.

Name Tel.

Mailing Address

The Bonded Contractor/Drain Layer authorized to perform this work is:

R. J. Canessa P.O. Box 51643 NB MA 508-993-9508

Name Address Tel.

Type of Pipe Required: SDR 35 PVC

PERMIT EXPIRES ONE YEAR AFTER DATE OF ISSUE

10/14/04

- Requires separate connections for sewage and storm drain where applicable. Storm water cannot be discharged to a sanitary sewer.
 - All work must be inspected and approved by a D.P.I. inspector before backfilling.
 - If this connection is to be part of a private service shared jointly with other building owners, attach copy of Recorded Joint Maintenance Agreement.
 - Permits can be issued to Industrial and/or Commercial Applicants only upon receipt and approval by the Commissioner of Public Infrastructure of required plans and supplemental information.
 - In addition, a City-issued Industrial User Discharge Permit and/or a Sewer Extension/Connection Permit issued by the Commonwealth of Massachusetts D.E.P. shall be required by the City for Industrial Discharge into the sewer system.
- Industrial User Discharge Permit No. Date

Comm. Mass. Sewer Conn./Ext. Permit No. Date

A Filing and Inspection Fee of \$150.00, plus an Entrance Fee of \$440.00 where applicable, must accompany this application.

Bank# 6220 Check# 2459 Date 10-14-03 Receipt# 4756

Other requirements: 8" sewer

24 hr. inspection

Connection made to Sewer Part of jointly-shared private line YES NO Carmen Umbelina
Storm Drain

Applicant agrees to abide by the above terms, as well as all pertinent ordinances of the City of New Bedford, and such other special rules as the Commissioner of Public Infrastructure and/or City Engineer may deem necessary

Duarte M. Andrade
Acting City Engineer mn

Signature of Property Owner or Representative

INSPECTOR'S REPORT

INSPECTED BY:

DATE:

COMMENTS:

APPROVED

DISAPPROVED

SIGNATURE

SKETCH PLAN


10-28-03

THURSDAY CLOUDY 45°

873 TRADEWIND ST - SEWER INSP

R-J CANESSA / CONSTRUCTION CONTRACTOR

10' SW

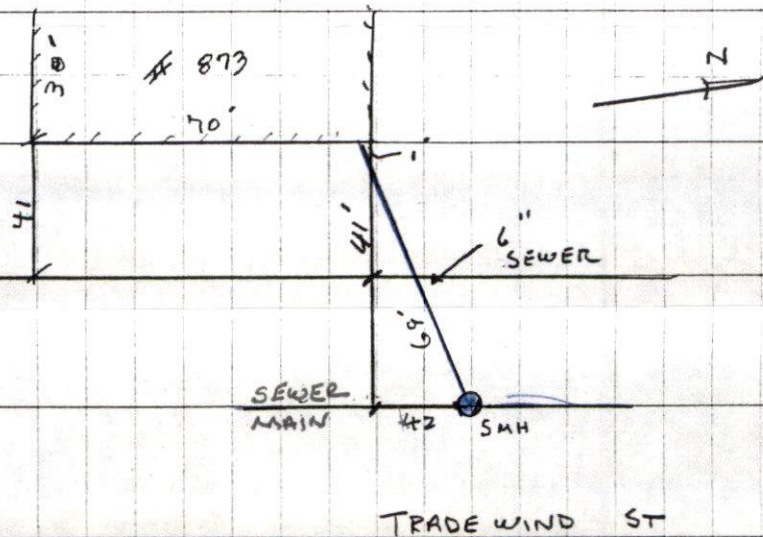

OAKDALE ST

TRADEWIND ST