



PERMIT NO. **23499** (SEE # **23402**) CITY OF NEW BEDFORD SEWER AND/OR STORM DRAIN PERMIT

DATE **12/1/2003**
EXP. **12/1/2004**

This certifies that permission is granted to

Property Owner **Robert J. Valton** Address **623 Madison St. Fall River, MA** Tel. **508-496-9010** cell. **508-496-9010**

To connect a sewer and/or storm drain located at **Liberty St. (E) 400' Sx Durfee St.**

Assessor's Plot **75** Lot **543**, to the sewer and/or storm drain in **Liberty St.** Street

To be laid in accordance with the conditions in this application and the City of New Bedford ordinances.
TYPE OF USE: RESIDENTIAL COMMERCIAL INDUSTRIAL OTHER **330 GPD**

If applicant other than actual property owner, attach Letter of Authorization from Property Owner.
Name..... Tel.....
Mailing Address.....

The Bonded Contractor/Drain Layer authorized to perform this work is:
Timothy Valton **34 Clifford Heights Road Fall River, MA** **508-675-0032**
Name..... Address..... Tel.....
Type of Pipe Required: **1 1/2" - Schedule 40**

PERMIT EXPIRES ONE YEAR AFTER DATE OF ISSUE

- Requires separate connections for sewage and storm drain where applicable. Storm water cannot be discharged to a sanitary sewer.
 - All work must be inspected and approved by a D.P.I. inspector before backfilling.
 - If this connection is to be part of a private service shared jointly with other building owners, attach copy of Recorded Joint Maintenance Agreement.
 - Permits can be issued to Industrial and/or Commercial Applicants only upon receipt and approval by the Commissioner of Public Infrastructure of required plans and supplemental information.
 - In addition, a City-issued Industrial User Discharge Permit and/or a Sewer Extension/Connection Permit issued by the Commonwealth of Massachusetts D.E.P. shall be required by the City for Industrial Discharge into the sewer system.
- Industrial User Discharge Permit No..... Date.....

Comm. Mass. Sewer Conn./Ext. Permit No..... Date.....
A Filing and Inspection Fee of \$ **150.00**, plus an Entrance Fee of \$..... where applicable, must accompany this application.

Bank# **Bank of Fall River** Check# **1075** Date **12/1/03** Receipt# **4800**

Other requirements: **Insp Only - Connect to 2" Force Main with grinder Pump. Flowable Fill is Required.**

Connection made to Sewer Part of jointly-shared private line YES NO
Storm Drain

Applicant agrees to abide by the above terms, as well as all pertinent ordinances of the City of New Bedford, and such other special rules as the Commissioner of Public Infrastructure and/or City Engineer may deem necessary
Duarte M. Andrade **ms** **Robert J. Valton**
City Engineer Signature of Property Owner or Representative



INSPECTOR'S REPORT

INSPECTED BY: _____
DATE: _____
COMMENTS: _____
APPROVED _____ DISAPPROVED _____


SIGNATURE

Sewer permit already issued back on 6/18/2003
23402

SKETCH PLAN

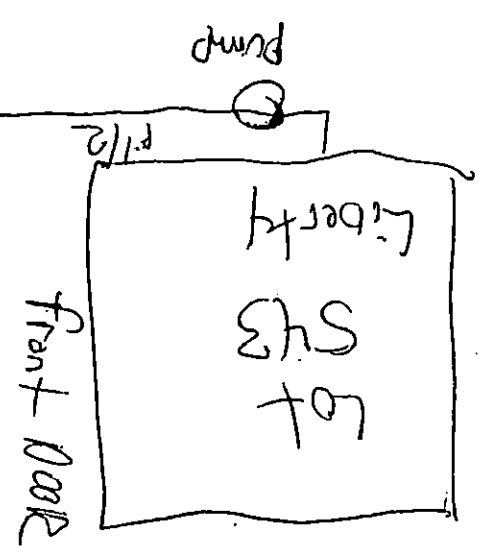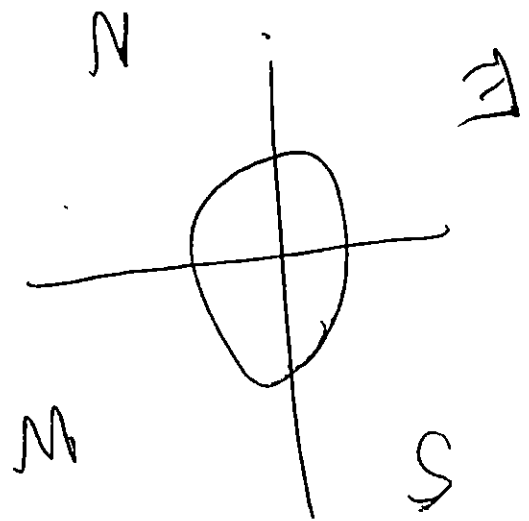

Curb Stop
w/ Box
Ball Valve

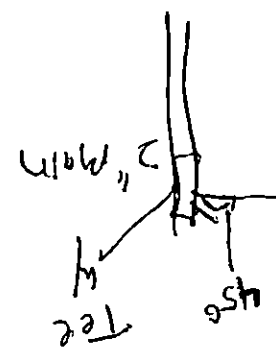

Liberty St.



PERMIT NO.

CITY OF NEW BEDFORD
SEWER AND/OR STORM DRAIN PERMIT

DATE 12/1/2003
EXP. 12/1/2004

23499

This certifies that permission is granted to

Property Owner Robert J. Valton Address 623 Madison St. Fall River, MA Tel. cell. 508-496-9010

To connect a sewer and/or storm drain located at Liberty St. (ES) 400' SX Durfee St

Assessor's Plot 75 Lot 543, to the sewer and/or storm drain in Liberty St. Street

To be laid in accordance with the conditions in this application and the City of New Bedford ordinances.
TYPE OF USE: RESIDENTIAL COMMERCIAL INDUSTRIAL OTHER 330 GPD

If applicant other than actual property owner, attach Letter of Authorization from Property Owner.

Name Timothy Valton Tel. 508-675-0032
Mailing Address 34 Stafford Heights Road Fall River, MA
The Bonded Contractor/Drain Layer authorized to perform this work is:
Name Timothy Valton Address 34 Stafford Heights Road Fall River, MA Tel. 508-675-0032
Type of Pipe Required: 1 1/2" - Schedule 40

PERMIT EXPIRES ONE YEAR AFTER DATE OF ISSUE

- Requires separate connections for sewage and storm drain where applicable. Storm water cannot be discharged to a sanitary sewer.
 - All work must be inspected and approved by a D.P.I. inspector before backfilling.
 - If this connection is to be part of a private service shared jointly with other building owners, attach copy of Recorded Joint Maintenance Agreement.
 - Permits can be issued to Industrial and/or Commercial Applicants only upon receipt and approval by the Commissioner of Public Infrastructure of required plans and supplemental information.
 - In addition, a City-issued Industrial User Discharge Permit and/or a Sewer Extension/Connection Permit issued by the Commonwealth of Massachusetts D.E.P. shall be required by the City for Industrial Discharge into the sewer system.
- Industrial User Discharge Permit No. _____ Date _____

Comm. Mass. Sewer Conn./Ext. Permit No. _____ Date _____
A Filing and Inspection Fee of \$ 150.00, plus an Entrance Fee of \$ — where applicable, must accompany this application.

Bank# Bank of Fall River Check# 1075 Date 12/1/03 Receipt# 4800

Other requirements: Insp Only - Connect to 2" Force Main with grinder Pump. Flowable Fill is Required.

Connection made to Sewer Part of jointly-shared private line YES NO
Storm Drain

Applicant agrees to abide by the above terms, as well as all pertinent ordinances of the City of New Bedford, and such other special rules as the Commissioner of Public Infrastructure and/or City Engineer may deem necessary


City Engineer Duarte M. Andrade ms Signature of Property Owner or Representative Robert J. Valton

INSPECTOR'S REPORT



INSPECTED BY: _____
DATE: _____
COMMENTS: _____

APPROVED _____ DISAPPROVED _____

SIGNATURE

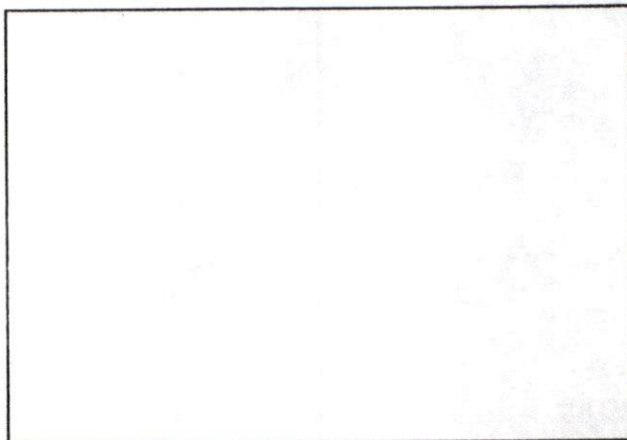


SKETCH PLAN

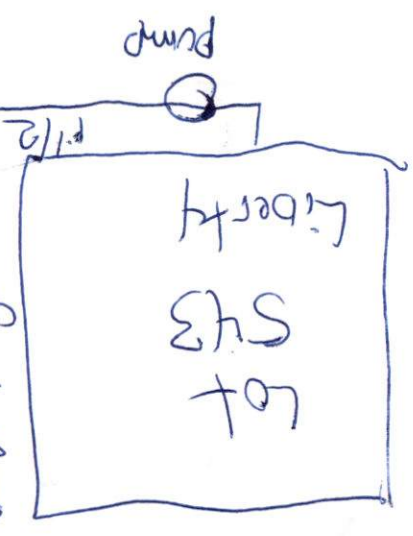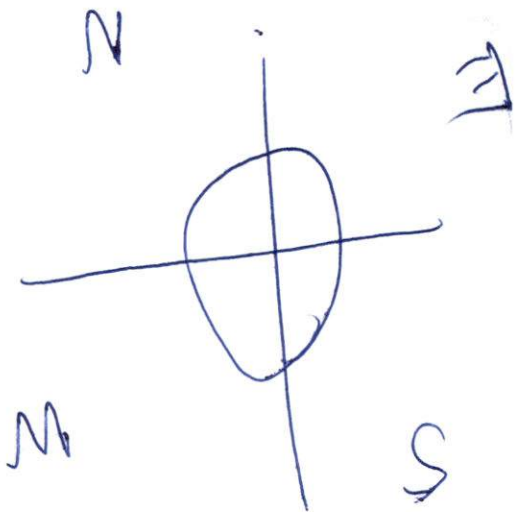

Pump

P. 1/2

Curb Stop
w/ Box
Ball Valve

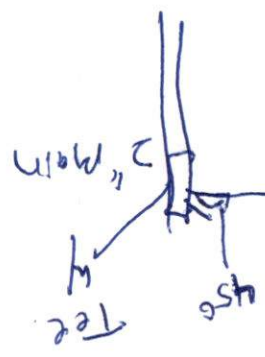

Liberty St.