



PERMIT NO. NO SKETCH

CITY OF NEW BEDFORD
SEWER AND/OR STORM DRAIN PERMIT

DATE 12-5-03

23501 (AS-BUILT STOP)

This certifies that permission is granted to

Wayland Devlmt. Corp. 867 Middle Road Acushnet
Property Owner Address #75 n.w. c. of Tel. 763-8868
158 Elm. Melrose Abut. N.B. Ma. 508-995-8240

To connect a sewer and/or storm drain located at Erin Ct. 140' n. of Katelyn Way

Assessor's Plot 132g Lot 38, to the sewer and/or storm drain in Erin Ct. Street

To be laid in accordance with the conditions in this application and the City of New Bedford ordinances.

TYPE OF USE: ☒ RESIDENTIAL ☐ COMMERCIAL ☐ INDUSTRIAL ☐ OTHER 330 gpd

If applicant other than actual property owner, attach Letter of Authorization from Property Owner.

Name atty. Chip Mufford Tel. 508-995-8240

Mailing Address P.O. Box 317 Fairhaven, Ma.

The Bonded Contractor/Drain Layer authorized to perform this work is:

D. W. White Const. Inc. 867 Middle Rd. Acushnet 508-763-8868

Name Address Tel.

Type of Pipe Required: pvc sdr - 35

PERMIT EXPIRES ONE YEAR AFTER DATE OF ISSUE 12/5/04

- Requires separate connections for sewage and storm drain where applicable. Storm water cannot be discharged to a sanitary sewer.
- All work must be inspected and approved by a D.P.I. inspector before backfilling.
- If this connection is to be part of a private service shared jointly with other building owners, attach copy of Recorded Joint Maintenance Agreement.
- Permits can be issued to Industrial and/or Commercial Applicants only upon receipt and approval by the Commissioner of Public Infrastructure of required plans and supplemental information.
- In addition, a City-issued Industrial User Discharge Permit and/or a Sewer Extension/Connection Permit issued by the Commonwealth of Massachusetts D.E.P. shall be required by the City for Industrial Discharge into the sewer system.

Industrial User Discharge Permit No. Date

Comm. Mass. Sewer Conn./Ext. Permit No. Date

A Filing and Inspection Fee of \$150.00 plus an Entrance Fee of \$ where applicable, must accompany this application.

Bank# Compass Check# 32259 Date 12/9/03 Receipt# 4803

Other requirements: 24 hr. inspection notice 508-995-1527

Build according to approved subdivision plans/connect to 8" sewer.

Connection made to ☒ Sewer ☐ Storm Drain Part of jointly-shared private line YES ☒ NO

Applicant agrees to abide by the above terms, as well as all pertinent ordinances of the City of New Bedford, and such other special rules as the Commissioner of Public Infrastructure and/or City Engineer may deem necessary

Dimitri M. Andriadey
Acting City Engineer

Signature of Property Owner or Representative

INSPECTOR'S REPORT

INSPECTED BY:


DATE:

COMMENTS:

APPROVED

DISAP

SIGNATURE

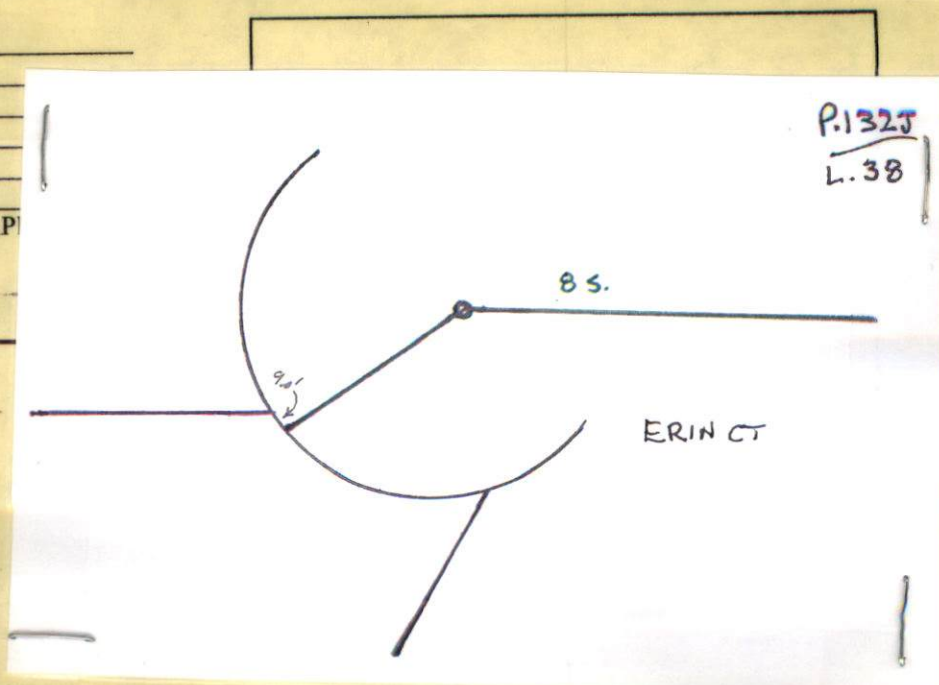



PERMIT NO.

23501

CITY OF NEW BEDFORD
SEWER AND/OR STORM DRAIN PERMIT

DATE 12-5-03

This certifies that permission is granted to

867 Middle Road Acushnet
Wayland Devlmt. Corp. 158 Chas. Melander Blvd. NB Ma. 508-763-8868
Property Owner Address Tel. 763-8868

To connect a sewer and/or storm drain located at Erin Ct. 140' n. of Katelyn Way

Assessor's Plot 132 J Lot 3.8 to the sewer and/or storm drain in Erin Ct. Street

To be laid in accordance with the conditions in this application and the City of New Bedford ordinances.

TYPE OF USE: RESIDENTIAL

COMMERCIAL

INDUSTRIAL

OTHER

330 gpd

If applicant other than actual property owner, attach Letter of Authorization from Property Owner.

Name: atty. Chip Mulford Tel. 508-995-8240

Mailing Address: P.O. Box 817 Fairhaven, Ma.

The Bonded Contractor/Drain Layer authorized to perform this work is:

D. W. White Const. Inc. 867 Middle Rd. Acushnet 508-763-8868
Name Address Tel.

Type of Pipe Required: pvc sdr-35

PERMIT EXPIRES ONE YEAR AFTER DATE OF ISSUE 12/5/04

- Requires separate connections for sewage and storm drain where applicable. Storm water cannot be discharged to a sanitary sewer.
 - All work must be inspected and approved by a D.P.I. inspector before backfilling.
 - If this connection is to be part of a private service shared jointly with other building owners, attach copy of Recorded Joint Maintenance Agreement.
 - Permits can be issued to Industrial and/or Commercial Applicants only upon receipt and approval by the Commissioner of Public Infrastructure of required plans and supplemental information.
 - In addition, a City-issued Industrial User Discharge Permit and/or a Sewer Extension/Connection Permit issued by the Commonwealth of Massachusetts D.E.P. shall be required by the City for Industrial Discharge into the sewer system.
- Industrial User Discharge Permit No. Date.

Comm. Mass. Sewer Conn./Ext. Permit No. Date.

A Filing and Inspection Fee of \$150.00 plus an Entrance Fee of \$ where applicable, must accompany this application.

Bank# Compass Check# 32259 Date 12/9/03 Receipt# 4803

Other requirements: 24 hr. inspection notice 508-979-1527

Build according to approved subdivision plans/connect to 8" sewer.

Connection made to

Sewer

Part of jointly-shared private line

YES

NO

Storm Drain

Applicant agrees to abide by the above terms, as well as all pertinent ordinances of the City of New Bedford, and such other special rules as the Commissioner of Public Infrastructure and/or City Engineer may deem necessary

Duarte M. Andrade
Acting City EngineerChip Mulford
Signature of Property Owner or Representative

INSPECTOR'S REPORT

INSPECTED BY: _____

DATE: _____

COMMENTS: _____

APPROVED

DISAPPROVED

SIGNATURE

SKETCH PLAN

TELEPHONE (508) 763-8868
OFFICE FAX (508) 997-9998

Wayland Development Corporation

867 MIDDLE ROAD-ACUSHNET, MA 02743

December 8, 2003

Mr. Duarte Andrade
Acting Chief Engineer
Engineering Department
City of New Bedford, MA 02740

Re: Authorization of Agent

Dear Mr. Andrade,


This letter will confirm that Ralph E. "Chip" Mulford, an attorney and the Corporate Counsel for Long Built Homes/Long Realty Inc., is authorized to act on Wayland Development Corporation's behalf, including affixing the Corporation's signature, when applying for and securing permits for the Woodford Estates subdivision from your Department, including but not limited to the following:

1. Sewer/Drain Service Permits;
2. Water Service Permits;
3. Driveway Installation Permits; and
4. Sidewalk Installation Permits.

Wayland Development Corp., acting through Mr. Mulford, its Agent for these limited purposes, agrees to conform to and abide by all City rules and regulations applicable to any permits being applied for.

Thank you in advance for your cooperation.

Sincerely,
Wayland Development Corp.

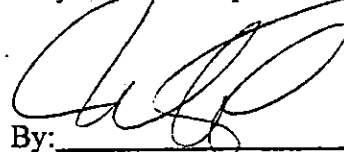

By: _____
Mark W. White
Treasurer
Hereunto Duly Authorized



CITY OF NEW BEDFORD

NO. 3070-03

LICENSE NO. _____

DATE 12/5 2003

FOUNDATION PERMIT

MSBC Sect. 111.8 – Any permit issued shall be deemed abandoned and invalid unless the work authorized by it shall have been commenced within six (6) months after its issuance.

This certifies that LONG BUILT HOMES, owner/contractor
has permission to INSTALL FOUNDATION
on P135-J L-38 ERIN COURT

providing that the person accepting this permit shall in every respect conform to the terms of the application therefor on file in this office; to the provisions of the Statute of the Commonwealth and to the By-Laws of the City of New Bedford relating to the Inspection, Erection, Enlarging, Altering, Raising, Moving, Repairing or Tearing Down of a Building.

WIRING INSPECTOR

PLUMBING INSPECTOR

BUILDING INSPECTOR

YOUR AREA INSPECTOR IS: _____

– Tel. 979-1540 Between 8:00 AM – 9:00 AM

NOTICE: NOTIFY INSPECTOR 48 HOURS
IN ADVANCE OF APPLYING
SHEATING OR LATHING

OCCUPANCY PERMIT REQUIRED BEFORE OCCUPANCY

No Building or Structure shall be used or occupied until the Certificate of Use and Occupancy shall have been issued by the Building Commissioner – MSBC. Sect. 120.1 – N.B. Zoning Ord. Sect. 9-269

THIS CARD MUST BE DISPLAYED IN A CONSPICUOUS PLACE ON THE PREMISES
AND NOT TORN DOWN OR REMOVED UNTIL COMPLETION OF WORK

SUBJECT TO MASSACHUSETTS STATE
BUILDING CODE REQUIREMENTS