



PERMIT NO. NO SKETCH  
23511 (AS-BUILT STUB)

CITY OF NEW BEDFORD  
SEWER AND/OR STORM DRAIN PERMIT

DATE 12/22/2003  
EXP. 12/22/2004

This certifies that permission is granted to

Wayland Development Corp. 867 Middle Rd Acushnet MA 02743  
Property Owner Address Tel. 508-763-8868

To connect a sewer and/or storm drain located at 8" #11 Erin Court

Assessor's Plot 132J Lot 51, to the sewer and/or storm drain in 8" Erin Court Street

To be laid in accordance with the conditions in this application and the City of New Bedford ordinances.

TYPE OF USE: RESIDENTIAL COMMERCIAL INDUSTRIAL OTHER 330 GPD

If applicant other than actual property owner, attach Letter of Authorization from Property Owner.

Name Ralph Mulford Tel. 508-995-8240

Mailing Address P.O. Box 817 Fairhaven, MA

The Bonded Contractor/Drain Layer authorized to perform this work is:

D.W. White 867 Middle Rd Acushnet, MA 508-763-8868

Name Address Tel.

Type of Pipe Required: PVC - SDR-35

PERMIT EXPIRES ONE YEAR AFTER DATE OF ISSUE

- Requires separate connections for sewage and storm drain where applicable. Storm water cannot be discharged to a sanitary sewer.
- All work must be inspected and approved by a D.P.I. inspector before backfilling.
- If this connection is to be part of a private service shared jointly with other building owners, attach copy of Recorded Joint Maintenance Agreement.
- Permits can be issued to Industrial and/or Commercial Applicants only upon receipt and approval by the Commissioner of Public Infrastructure of required plans and supplemental information.
- In addition, a City-issued Industrial User Discharge Permit and/or a Sewer Extension/Connection Permit issued by the Commonwealth of Massachusetts D.E.P. shall be required by the City for Industrial Discharge into the sewer system.

Industrial User Discharge Permit No. Date.

Comm. Mass. Sewer Conn./Ext. Permit No. Date.

A Filing and Inspection Fee of \$150, plus an Entrance Fee of \$ where applicable, must accompany this application.

Bank# Check# Date Receipt#

Other requirements: Insp Only - Connect to 8" Sewer

Must call 24 hrs. prior for service inspection

Connection made to Sewer Part of jointly-shared private line YES NO  
Storm Drain

Applicant agrees to abide by the above terms, as well as all pertinent ordinances of the City of New Bedford, and such other special rules as the Commissioner of Public Infrastructure and/or City Engineer may deem necessary


Dante M. Andrade ms City Engineer  
Chip Mulford Signature of Property Owner or Representative  
Chip Mulford

INSPECTOR'S REPORT

INSPECTED BY:  
DATE:  
COMMENTS:

APPROVED

SIGNATURE

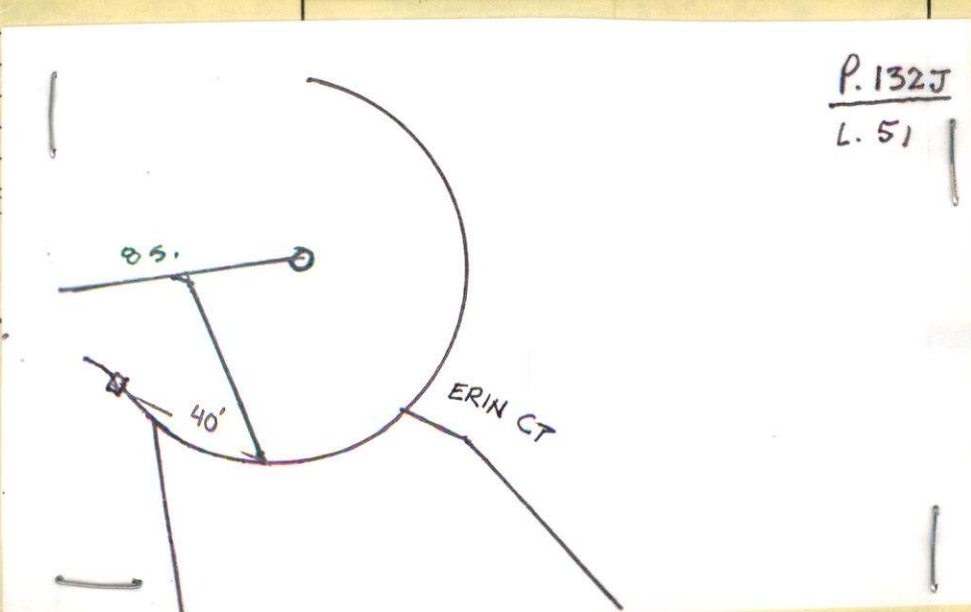





PERMIT NO.

23511

CITY OF NEW BEDFORD  
SEWER AND/OR STORM DRAIN PERMIT

DATE 12/22/2003  
EXP. 12/22/2004

This certifies that permission is granted to

Wayland Development Corp. 867 Middle Rd Acushnet, MA 02743  
Property Owner Address Tel. 508-763-8868

To connect a sewer and/or storm drain located at #11 Erin Court

Assessor's Plot 132J Lot 51, to the sewer and/or storm drain in Erin Court Street

To be laid in accordance with the conditions in this application and the City of New Bedford ordinances.

TYPE OF USE: RESIDENTIAL COMMERCIAL INDUSTRIAL OTHER 330 GPD

If applicant other than actual property owner, attach Letter of Authorization from Property Owner.

Name Ralph Mulford Tel. 508-995-8240

Mailing Address P.O. Box 817 Fairhaven, MA

The Bonded Contractor/Drain Layer authorized to perform this work is:

Dw. White 867 Middle Rd Acushnet, MA 508-763-8868

Name Address Tel.

Type of Pipe Required: PVC - SDR-35

PERMIT EXPIRES ONE YEAR AFTER DATE OF ISSUE

- Requires separate connections for sewage and storm drain where applicable. Storm water cannot be discharged to a sanitary sewer.
- All work must be inspected and approved by a D.P.I. inspector before backfilling.
- If this connection is to be part of a private service shared jointly with other building owners, attach copy of Recorded Joint Maintenance Agreement.
- Permits can be issued to Industrial and/or Commercial Applicants only upon receipt and approval by the Commissioner of Public Infrastructure of required plans and supplemental information.
- In addition, a City-issued Industrial User Discharge Permit and/or a Sewer Extension/Connection Permit issued by the Commonwealth of Massachusetts D.E.P. shall be required by the City for Industrial Discharge into the sewer system.

Industrial User Discharge Permit No. Date

Comm. Mass. Sewer Conn./Ext. Permit No. Date

A Filing and Inspection Fee of \$150.00, plus an Entrance Fee of \$ where applicable, must accompany this application.

Bank# Check# Date Receipt#

Other requirements: Insp. Only - Connect to 8" Sewer

Must call 24 hrs prior for service inspection

Connection made to Sewer Part of jointly-shared private line YES NO  
Storm Drain

Applicant agrees to abide by the above terms, as well as all pertinent ordinances of the City of New Bedford, and such other special rules as the Commissioner of Public Infrastructure and/or City Engineer may deem necessary

Duarte M. Andrade ms  
City Engineer

Chip Mulford  
Signature of Property Owner or Representative  
Chip Mulford

INSPECTOR'S REPORT

INSPECTED BY:


DATE:

COMMENTS:

APPROVED

DISAPPROVED

SIGNATURE

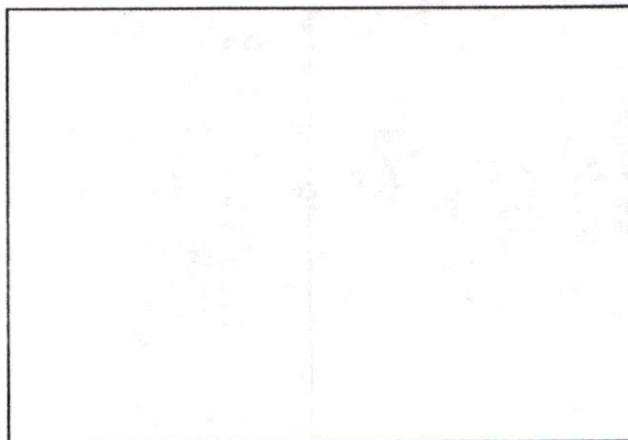

SKETCH PLAN

TELEPHONE (508) 763-8868  
OFFICE FAX (508) 997-9998

# Wayland Development Corporation

867 MIDDLE ROAD-ACUSHNET, MA 02743

---

December 8, 2003

Mr. Duarte Andrade  
Acting Chief Engineer  
Engineering Department  
City of New Bedford, MA 02740

Re: Authorization of Agent

Dear Mr. Andrade,


This letter will confirm that Ralph F. "Chip" Mulford, an attorney and the Corporate Counsel for Long Built Homes/Long Realty Inc., is authorized to act on Wayland Development Corporation's behalf, including affixing the Corporation's signature, when applying for and securing permits for the Woodford Estates subdivision from your Department, including but not limited to the following:

1. Sewer/Drain Service Permit;
2. Water Service Permits;
3. Driveway Installation Permits; and
4. Sidewalk Installation Permits.

Wayland Development Corp., acting through Mr. Mulford, its Agent for these limited purposes, agrees to conform to and abide by all City rules and regulations applicable to any permits being applied for.

Thank you in advance for your cooperation.

Sincerely,  
Wayland Development Corp.

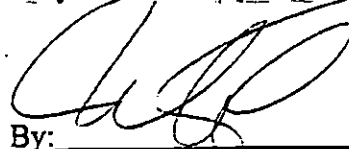

By: \_\_\_\_\_  
Mark W. White  
Treasurer  
Hereunto Duly Authorized





# CITY OF NEW BEDFORD

b64 .

NO. 3134-03

LICENSE NO. \_\_\_\_\_

DATE 12/22 2003

## FOUNDATION PERMIT

MSBC Sect. 111.8 – Any permit issued shall be deemed abandoned and invalid unless the work authorized by it shall have been commenced within six (6) months after its issuance.

This certifies that Long Built Homes, owner/contractor

has permission to INSTALL FOUNDATION

on P132-J L51 ERIN COURT #11 8" S

providing that the person accepting this permit shall in every respect conform to the terms of the application therefor on file in this office; to the provisions of the Statute of the Commonwealth and to the By-Laws of the City of New Bedford relating to the Inspection, Erection, Enlarging, Altering, Raising, Moving, Repairing or Tearing Down of a Building.

WIRING INSPECTOR

PLUMBING INSPECTOR

BUILDING INSPECTOR

\_\_\_\_\_  
\_\_\_\_\_  
ROUGH FINISH

YOUR AREA INSPECTOR IS: \_\_\_\_\_

– Tel. 979-1540 Between 8:00 AM – 9:00 AM

NOTICE: NOTIFY INSPECTOR 48 HOURS  
IN ADVANCE OF APPLYING  
SHEATING OR LATHING

### OCCUPANCY PERMIT REQUIRED BEFORE OCCUPANCY

No Building or Structure shall be used or occupied until the Certificate of Use and Occupancy shall have been issued by the Building Commissioner – MSBC. Sect. 120.1 – N.B. Zoning Ord. Sect. 9-269

THIS CARD MUST BE DISPLAYED IN A CONSPICUOUS PLACE ON THE PREMISES  
AND NOT TORN DOWN OR REMOVED UNTIL COMPLETION OF WORK

SUBJECT TO MASSACHUSETTS STATE  
BUILDING CODE REQUIREMENTS

William Smith  
BUILDING INSPECTOR