



PERMIT NO.

CITY OF NEW BEDFORD  
SEWER AND/OR STORM DRAIN PERMIT

DATE 2/5/04

23517

This certifies that permission is granted to

Thomas Monast 238 Haskell St. NB 508-9989452  
Property Owner Address Tel.

To connect a sewer and/or storm drain located at stub on Haskell St.

Assessor's Plot 123A Lot 97, to the sewer and/or storm drain in Haskell Street

To be laid in accordance with the conditions in this application and the City of New Bedford ordinances.

TYPE OF USE: ☒ RESIDENTIAL ☐ COMMERCIAL ☐ INDUSTRIAL ☐ OTHER

2203 pd.

If applicant other than actual property owner, attach Letter of Authorization from Property Owner.

Name.....Tel.....

Mailing Address.....

The Bonded Contractor/Drain Layer authorized to perform this work is:

John Golder 11 Manmouth St. Acushnet Ma 508-995-9819  
Name Address Tel.

Type of Pipe Required: PVC SDR 35

PERMIT EXPIRES ONE YEAR AFTER DATE OF ISSUE

- Requires separate connections for sewage and storm drain where applicable. Storm water cannot be discharged to a sanitary sewer.
- All work must be inspected and approved by a D.P.I. inspector before backfilling.
- If this connection is to be part of a private service shared jointly with other building owners, attach copy of Recorded Joint Maintenance Agreement.
- Permits can be issued to Industrial and/or Commercial Applicants only upon receipt and approval by the Commissioner of Public Infrastructure of required plans and supplemental information.
- In addition, a City-issued Industrial User Discharge Permit and/or a Sewer Extension/Connection Permit issued by the Commonwealth of Massachusetts D.E.P. shall be required by the City for Industrial Discharge into the sewer system.

Industrial User Discharge Permit No.....Date.....

Comm. Mass. Sewer Conn./Ext. Permit No.....Date.....

A Filing and Inspection Fee of \$50.00 plus an Entrance Fee of \$218.70 where applicable, must accompany this application.

Bank# n/a <sup>cash</sup> Check# 368.70 Date 2/5/04 Receipt# 624

Other requirements: 24 hr. inspection notice

Stub at property line

Connection made to Sewer Part of jointly-shared private line YES ☒ NO  
Storm Drain

Applicant agrees to abide by the above terms, as well as all pertinent ordinances of the City of New Bedford, and such other special rules as the Commissioner of Public Infrastructure and/or City Engineer may deem necessary

Duante M. Andradef  
City Engineer mn


Thomas A Monast  
Signature of Property Owner or Representative

INSPECTOR'S REPORT

INSPECTED BY: Euzebio ARAND  
DATE: 3-3-04  
COMMENTS:

APPROVED DISAPPROVED

[Signature]  
SIGNATURE

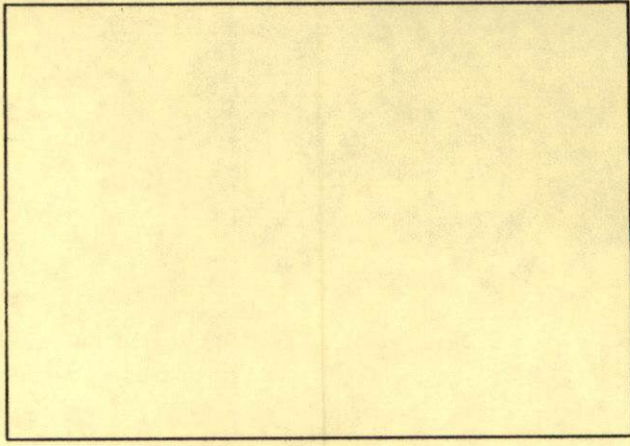

SKETCH PLAN



HWS

121

HASKELL ST.

6/4

50'

14'

11'

30'

24'

13'

5'

8'


14'

17'

9'

14'

8'

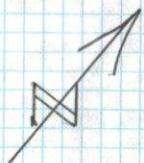

3-3-04

#238 HASKELL ST.





PERMIT NO.

23517

CITY OF NEW BEDFORD  
SEWER AND/OR STORM DRAIN PERMIT

DATE 2/5/04

This certifies that permission is granted to

Thomas Monast 238 Haskell St. NB 508-998-9452  
Property Owner Address Tel.

To connect a sewer and/or storm drain located at stub on Haskell St.

Assessor's Plot 123 A Lot 97, to the sewer and/or storm drain in Haskell Street

To be laid in accordance with the conditions in this application and the City of New Bedford ordinances.

TYPE OF USE: ☒ RESIDENTIAL ☐ COMMERCIAL ☐ INDUSTRIAL ☐ OTHER 2203 pd.

If applicant other than actual property owner, attach Letter of Authorization from Property Owner.

Name Mailing Address Tel.

The Bonded Contractor/Drain Layer authorized to perform this work is:

John Galda 11 Manmouth St. Acushnet Ma 508-995-9819  
Name Address Tel.

Type of Pipe Required: P.V.C. S.D.R. 35

## PERMIT EXPIRES ONE YEAR AFTER DATE OF ISSUE

- Requires separate connections for sewage and storm drain where applicable. Storm water cannot be discharged to a sanitary sewer.
  - All work must be inspected and approved by a D.P.I. inspector before backfilling.
  - If this connection is to be part of a private service shared jointly with other building owners, attach copy of Recorded Joint Maintenance Agreement.
  - Permits can be issued to Industrial and/or Commercial Applicants only upon receipt and approval by the Commissioner of Public Infrastructure of required plans and supplemental information.
  - In addition, a City-issued Industrial User Discharge Permit and/or a Sewer Extension/Connection Permit issued by the Commonwealth of Massachusetts D.E.P. shall be required by the City for Industrial Discharge into the sewer system.
- Industrial User Discharge Permit No. Date

Comm. Mass. Sewer Conn./Ext. Permit No. Date

A Filing and Inspection Fee of \$150.00 plus an Entrance Fee of \$218.70 where applicable, must accompany this application.

Bank# n/a cash Check# 368.70 Date 2/5/04 Receipt# 624

Other requirements: 24 hr. inspection notice

Stub at property line

Connection made to Sewer Part of jointly-shared private line YES NO  
Storm Drain

Applicant agrees to abide by the above terms, as well as all pertinent ordinances of the City of New Bedford, and such other special rules as the Commissioner of Public Infrastructure and/or City Engineer may deem necessary

Duarte M. Andrada City Engineer mn

Thomas A. Monast Signature of Property Owner or Representative

## INSPECTOR'S REPORT

INSPECTED BY:

DATE:

COMMENTS:

APPROVED

DISAPPROVED

SIGNATURE

SKETCH PLAN



No. 04-15

Michelle

FEE 50.00  
Pd. # 0500  
2/5/04

## COMMONWEALTH OF MASSACHUSETTS

Board of Health, NEW BEDFORD, MA.

## APPLICATION FOR DISPOSAL SYSTEM CONSTRUCTION PERMIT

COPY

Application for a Permit to Construct ( ) Repair ( ) Upgrade ( ) Abandon ( ) ☒ Complete System ☐ Individual Components

Location <u>238 Haskell St.</u>	Owner's Name <u>Thomas MONAST</u>
Map/Parcel# <u>123A</u>	Address <u>= same -</u>
Lot# <u>97</u>	Telephone#
Installer's Name <u>John Golda</u>	Designer's Name
Address <u>13 Monmouth St.</u>	Address
Telephone#	Telephone#

Type of Building RESIDENCE Lot Size \_\_\_\_\_ sq. ft.  
Dwelling - No. of Bedrooms \_\_\_\_\_ Garbage grinder ( )  
Other - Type of Building \_\_\_\_\_ No. of persons \_\_\_\_\_ Showers ( ), Cafeteria ( )  
Other Fixtures \_\_\_\_\_  
Design Flow (min. required) \_\_\_\_\_ gpd Calculated design flow \_\_\_\_\_ Design flow provided \_\_\_\_\_ gpd  
Plan: Date \_\_\_\_\_ Number of sheets \_\_\_\_\_ Revision Date \_\_\_\_\_  
Title \_\_\_\_\_  
Description of Soil(s) \_\_\_\_\_  
Soil Evaluator Form No. \_\_\_\_\_ Name of Soil Evaluator \_\_\_\_\_ Date of Evaluation \_\_\_\_\_

DESCRIPTION OF REPAIRS OR ALTERATIONS Abandon septic system  
DPW permit No. 23517 dated 2/5/04 (copy attached)

The undersigned agrees to install the above described Individual Sewage Disposal System in accordance with the provisions of TITLE 5 and further agrees to not to place the system in operation until a Certificate of Compliance has been issued by the Board of Health.

Signed THOMAS MONAST (signature) Date 2-5-04

Inspections \_\_\_\_\_  
\_\_\_\_\_  
\_\_\_\_\_

No. 04-15

## COMMONWEALTH OF MASSACHUSETTS

Board of Health, NEW BEDFORD, MA.

## CERTIFICATE OF COMPLIANCE

FEE 50.00

COPY

Description of Work: ☐ Individual Component(s) ☒ Complete SystemThe undersigned hereby certify that the Sewage Disposal System; Constructed ( ), Repaired ( ), Upgraded ( ), Abandoned ( ☒ )

by: THOMAS MONAST  
at 238 HASKELL ST. NEW BEDFORD MA 02745

has been installed in accordance with the provisions of 310 CMR 15.00 (Title 5) and the approved design plans/as-built plans relating to application No. \_\_\_\_\_, dated \_\_\_\_\_, Approved Design Flow \_\_\_\_\_ (gpd)

Installer ACUSHNET TRENCHING CORP. 11 MONMOUTH ST. NEW BEDFORD ACUSHNET MA  
Designer: \_\_\_\_\_ Inspector: Wm Blackburn Date: 3-11-04

The issuance of this permit shall not be construed as a guarantee that the system will function as designed.

No. 04-15

## COMMONWEALTH OF MASSACHUSETTS

Board of Health, NEW BEDFORD, MA.

## DISPOSAL SYSTEM CONSTRUCTION PERMIT

FEE 50.00

COPY

Permission is hereby granted to; Construct ( ) Repair ( ) Upgrade ( ) Abandon ( ☒ ) an individual sewage disposal system at 238 HASKELL ST. as described in the application for Disposal System Construction Permit No. 04-15, dated 2-5-04.

Provided: Construction shall be completed within three years of the date of this permit. All local conditions must be met..