



PERMIT NO.

23530

NO

SKETCH TO USE (AS-BUILT SUB)

This certifies that permission is granted to

CITY OF NEW BEDFORD

SEWER AND/OR STORM DRAIN PERMIT

DATE 3/3/04

Wayland Development Corp 867 Middle Rd. Acushnet 508-763-8868  
Property Owner Address Tel.

To connect a sewer and/or storm drain located at 64 Lauren Dr. 10" sewer no storm drain

Assessor's Plot 132 f Lot 26, to the sewer and/or storm drain in Lauren Dr. Street

To be laid in accordance with the conditions in this application and the City of New Bedford ordinances.

TYPE OF USE: ☒ RESIDENTIAL ☐ COMMERCIAL ☐ INDUSTRIAL ☐ OTHER

330 gpd

If applicant other than actual property owner, attach Letter of Authorization from Property Owner.

Name Robert Long Tel. 508-995-8240

Mailing Address 158 Charles Melancon Blvd N.B.

The Bonded Contractor/Drain Layer authorized to perform this work is:

D. W. White 867 Middle Rd. Acushnet 508-763-8868

Name Address Tel.

Type of Pipe Required: pvc sdr 35

## PERMIT EXPIRES ONE YEAR AFTER DATE OF ISSUE

- Requires separate connections for sewage and storm drain where applicable. Storm water cannot be discharged to a sanitary sewer.
- All work must be inspected and approved by a D.P.I. inspector before backfilling.
- If this connection is to be part of a private service shared jointly with other building owners, attach copy of Recorded Joint Maintenance Agreement.
- Permits can be issued to Industrial and/or Commercial Applicants only upon receipt and approval by the Commissioner of Public Infrastructure of required plans and supplemental information.
- In addition, a City-issued Industrial User Discharge Permit and/or a Sewer Extension/Connection Permit issued by the Commonwealth of Massachusetts D.E.P. shall be required by the City for Industrial Discharge into the sewer system.

Industrial User Discharge Permit No. Date.

Comm. Mass. Sewer Conn./Ext. Permit No. Date.

A Filing and Inspection Fee of \$150.00, plus an Entrance Fee of \$... where applicable, must accompany this application.

Bank# Compass Check# 33476 Date 3/4/04 Receipt# 4841

Other requirements: 24 hr. inspection notice 508-979-1527

Connection made to ☒ Sewer ☐ Storm-Drain  
Part of jointly-shared private line YES ☒ NO

Applicant agrees to abide by the above terms, as well as all pertinent ordinances of the City of New Bedford, and such other special rules as the Commissioner of Public Infrastructure and/or City Engineer may deem necessary

Duarte M. Andrade  
Acting City Engineer mn

Signature of Property Owner or Representative

## INSPECTOR'S REPORT

INSPECTED BY:


DATE:

COMMENTS:

APPROVED

DISAP

SIGNATURE

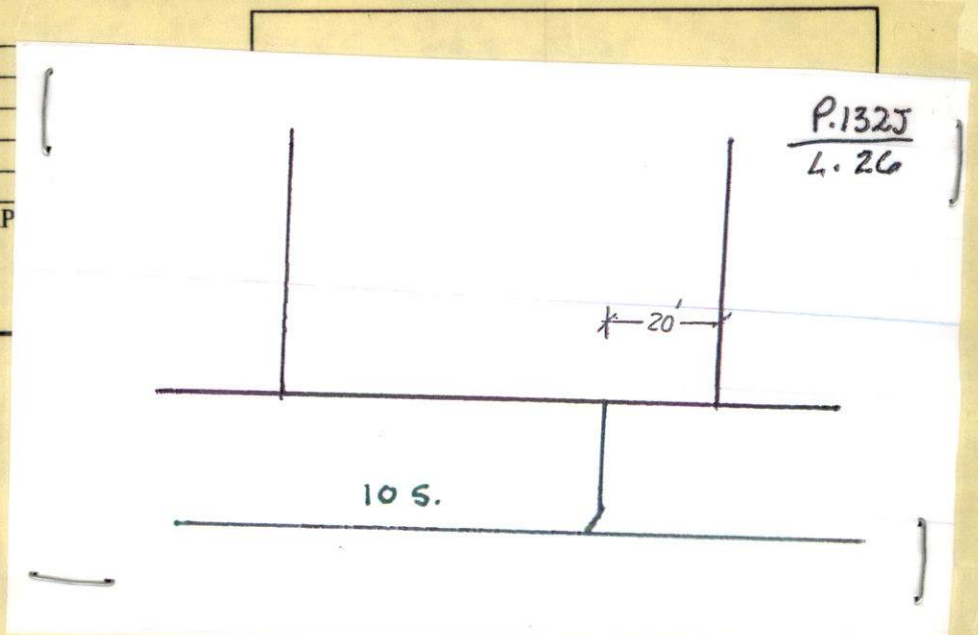





PERMIT NO.

23530

CITY OF NEW BEDFORD  
SEWER AND/OR STORM DRAIN PERMIT

DATE 3/3/04

This certifies that permission is granted to

Wayland Development Corp 867 Middle Rd. Acushnet 508-763-8868  
Property Owner Address Tel.

To connect a sewer and/or storm drain located at 64 Lauren Dr. 10" sewer no storm drain

Assessor's Plot 132 J Lot 26, to the sewer and/or storm drain in Lauren Dr. Street

To be laid in accordance with the conditions in this application and the City of New Bedford ordinances.

TYPE OF USE: ☒ RESIDENTIAL☐ COMMERCIAL☐ INDUSTRIAL☐ OTHER

330 gpd

If applicant other than actual property owner, attach Letter of Authorization from Property Owner.

Name Robert Long Tel 508-995-8240

Mailing Address 158 Charles McLombas Blvd NB

The Bonded Contractor/Drain Layer authorized to perform this work is:

D. W. White 867 Middle Rd. Acushnet 508-763-8868

Name Address Tel.

Type of Pipe Required: pvc sdr 35

## PERMIT EXPIRES ONE YEAR AFTER DATE OF ISSUE

- Requires separate connections for sewage and storm drain where applicable. Storm water cannot be discharged to a sanitary sewer.
- All work must be inspected and approved by a D.P.I. inspector before backfilling.
- If this connection is to be part of a private service shared jointly with other building owners, attach copy of Recorded Joint Maintenance Agreement.
- Permits can be issued to Industrial and/or Commercial Applicants only upon receipt and approval by the Commissioner of Public Infrastructure of required plans and supplemental information.
- In addition, a City-issued Industrial User Discharge Permit and/or a Sewer Extension/Connection Permit issued by the Commonwealth of Massachusetts D.E.P. shall be required by the City for Industrial Discharge into the sewer system.

Industrial User Discharge Permit No. Date

Comm. Mass. Sewer Conn./Ext. Permit No. Date

A Filing and Inspection Fee of \$150.00, plus an Entrance Fee of \$ where applicable, must accompany this application.

Bank# Compass Check# 33476 Date 3/4/04 Receipt# 4841

Other requirements: 24 hr. inspection notice 508-979-1527

Connection made to ☒ Sewer ☐ Storm Drain Part of jointly-shared private line YES ☒ NO

Applicant agrees to abide by the above terms, as well as all pertinent ordinances of the City of New Bedford, and such other special rules as the Commissioner of Public Infrastructure and/or City Engineer may deem necessary

Duarte M. Andrade Acting City Engineer mn

Signature of Property Owner or Representative

## INSPECTOR'S REPORT

INSPECTED BY: \_\_\_\_\_

DATE: \_\_\_\_\_

COMMENTS: \_\_\_\_\_

APPROVED

DISAPPROVED

SIGNATURE

SKETCH PLAN

TELEPHONE (508) 763-8868  
OFFICE FAX (508) 997-9998

# Wayland Development Corporation

867 MIDDLE ROAD-ACUSHNET, MA 02743

---

March 4, 2004

Mr. Duarte Andrade  
Acting Chief Engineer  
Engineering Department  
City of New Bedford, MA 02740

Re: Authorization of Agent

Dear Mr. Andrade,


This letter will confirm that Robert F. Long of Long Built Homes/Long Realty, Inc., is authorized to act on Wayland Development Corporation's behalf, including affixing the Corporation's signature, when applying for and securing permits for the Woodford Estates Subdivision from your Department, including but not limited to the following:

1. Sewer/Drain Service Permits;
2. Water Service Permits;
3. Driveway Installation Permits; and
4. Sidewalk Installation Permits.

Wayland Development Corp., acting through Mr. Long, its Agent for these limited purposes, agrees to conform to and abide by all City rules and regulations applicable to any permits being applied for.

Thank you in advance for your cooperation.

Sincerely,  
Wayland Development Corp.

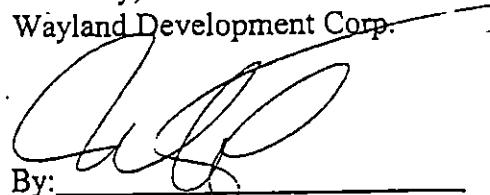

By: \_\_\_\_\_  
Mark W. White  
Treasurer  
Hereunto Duly Authorized



# CITY OF NEW BEDFORD

678

NO. 162-04

LICENSE NO. \_\_\_\_\_

DATE 3/30 2004

## FOUNDATION PERMIT

MSBC Sect. 111.8 – Any permit issued shall be deemed abandoned and invalid unless the work authorized by it shall have been commenced within six (6) months after its issuance.

This certifies that LONG BUILT HOMES, owner/contractor  
has permission to BUILD FOUNDATION  
on P.135-J L-26 LAUREN DRIVE #64 address 10" w  
m.s.d.

providing that the person accepting this permit shall in every respect conform to the terms of the application therefor on file in this office; to the provisions of the Statute of the Commonwealth and to the By-Laws of the City of New Bedford relating to the Inspection, Erection, Enlarging, Altering, Raising, Moving, Repairing or Tearing Down of a Building.

WIRING INSPECTOR

PLUMBING INSPECTOR

BUILDING INSPECTOR

ROUGH FINISH

YOUR AREA INSPECTOR IS: \_\_\_\_\_

– Tel. 979-1540 Between 8:00 AM – 9:00 AM

NOTICE: NOTIFY INSPECTOR 48 HOURS  
IN ADVANCE OF APPLYING  
SHEATING OR LATHING

### OCCUPANCY PERMIT REQUIRED BEFORE OCCUPANCY

No Building or Structure shall be used or occupied until the Certificate of Use and Occupancy shall have been issued by the Building Commissioner – MSBC. Sect. 120.1 – N.B. Zoning Ord. Sect. 9-269

THIS CARD MUST BE DISPLAYED IN A CONSPICUOUS PLACE ON THE PREMISES  
AND NOT TORN DOWN OR REMOVED UNTIL COMPLETION OF WORK

SUBJECT TO MASSACHUSETTS STATE  
BUILDING CODE REQUIREMENTS

*William Smith*  
BUILDING INSPECTOR