



PERMIT NO.

23547

CITY OF NEW BEDFORD  
SEWER AND/OR STORM DRAIN PERMIT

DATE 5/3/2004  
EXP. 5/3/2005

This certifies that permission is granted to

MICHAEL A. TRAZZERA 41 ANTONIO COSTA BLVD NB, MA 508-993-3060  
Property Owner Address #38 Tel.

To connect a sewer and/or storm drain located at BLACKMER ST. (SE) CORN. OF SILVA ST.

Assessor's Plot 25A Lot 46, to the sewer and/or storm drain in BLACKMER ST. Street

To be laid in accordance with the conditions in this application and the City of New Bedford ordinances.

TYPE OF USE: RESIDENTIAL COMMERCIAL INDUSTRIAL OTHER

If applicant other than actual property owner, attach Letter of Authorization from Property Owner.

Name ROBERT MARTIN Tel. 508-954-3106

Mailing Address P.O. Box 50010 New Bedford, MA

The Bonded Contractor/Drain Layer authorized to perform this work is:

FRANK CORP. 615 Tacklin Hill Rd. NB, MA 02745 508-995-9997

Name Address Tel.

Type of Pipe Required: PVC - SDR-35

PERMIT EXPIRES ONE YEAR AFTER DATE OF ISSUE

- Requires separate connections for sewage and storm drain where applicable. Storm water cannot be discharged to a sanitary sewer.
- All work must be inspected and approved by a D.P.I. inspector before backfilling.
- If this connection is to be part of a private service shared jointly with other building owners, attach copy of Recorded Joint Maintenance Agreement.
- Permits can be issued to Industrial and/or Commercial Applicants only upon receipt and approval by the Commissioner of Public Infrastructure of required plans and supplemental information.
- In addition, a City-issued Industrial User Discharge Permit and/or a Sewer Extension/Connection Permit issued by the Commonwealth of Massachusetts D.E.P. shall be required by the City for Industrial Discharge into the sewer system.

Industrial User Discharge Permit No. Date

Comm. Mass. Sewer Conn./Ext. Permit No. Date

A Filing and Inspection Fee of \$150, plus an Entrance Fee of \$, where applicable, must accompany this application.

Bank# Citizen's Bank Check# 4012 Date 5/3/04 Receipt# 4875

Other requirements: Insp. Only - "Storm drainage Only" to be connected thru sewer stub easement into abutting Lot #47. Sewer to connect to it's own service.

Connection made to Sewer Storm Drain Easement Plan to be submitted to this department Part of jointly-shared private line YES NO

Applicant agrees to abide by the above terms, as well as all pertinent ordinances of the City of New Bedford, and such other special rules as the Commissioner of Public Infrastructure and/or City Engineer may deem necessary


Duarte M. Andrade (MS)  
City Engineer

[Signature]  
Signature of Property Owner or Representative

INSPECTOR'S REPORT

INSPECTED BY: [Signature]  
DATE: 7/22/04  
COMMENTS:



APPROVED [Signature] DISAP  
SIGNATURE

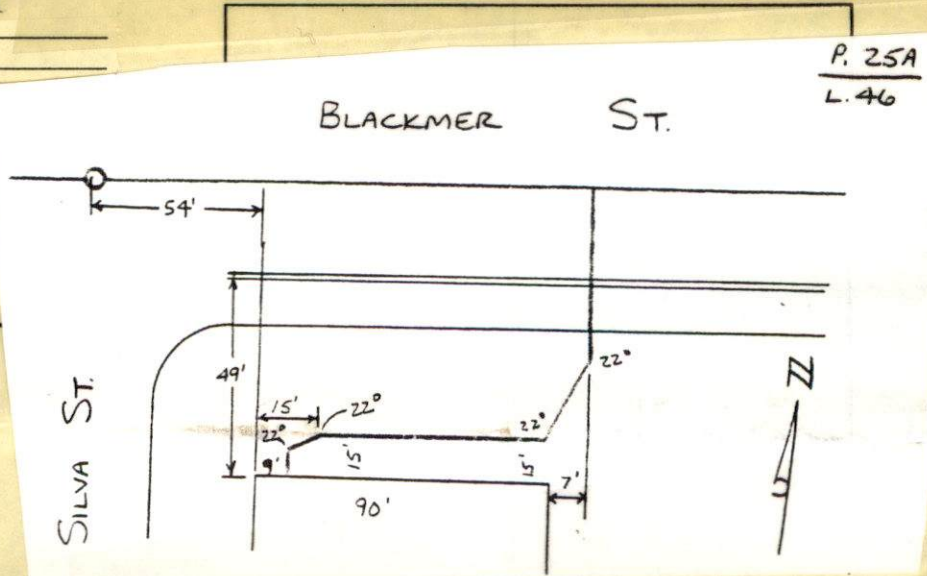



DRAIN NO. \_\_\_\_\_ OWNER \_\_\_\_\_

- ① MEASURE FRONT OF HOUSE, DISTANCE TO LOT LINE.
- ② MEASURE FROM COR. OF HOUSE TO DRAIN, DISTANCE WHERE DRAIN CROSSES PROPERTY LINE, ENTERS SEWER.
- ③ LENGTH OF DRAIN FROM FRONT PROP. LINE TO HOUSE
- ④ SHOW NORTH ARROW.
- ⑤ MEASURE FROM DRAIN TO NEAREST INTERSECTION

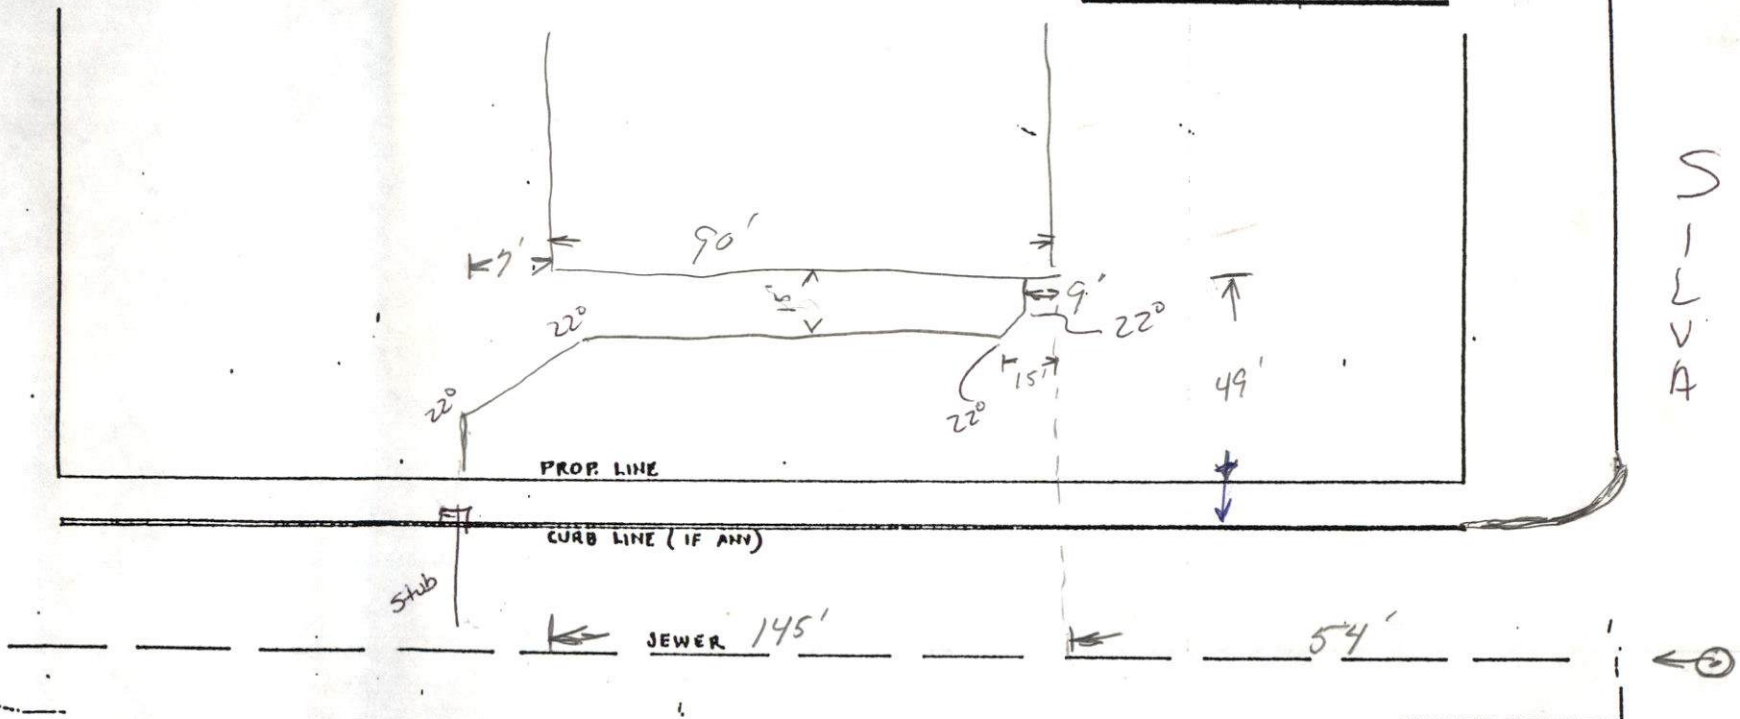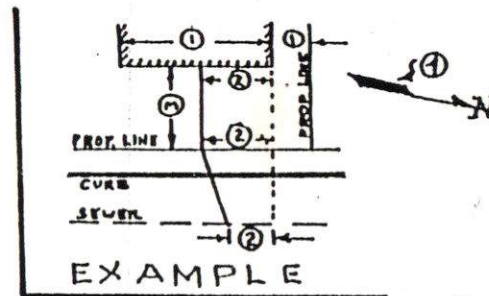

BLACKMER





PERMIT NO.

23547

CITY OF NEW BEDFORD  
SEWER AND/OR STORM DRAIN PERMIT

DATE 5/3/2004

EXP. 5/3/2005

This certifies that permission is granted to

MICHAEL A. TRAZZERA 41 ANTONIO COSTA BLVD. NB, MA 508-993-3060  
Property Owner Address Tel.

To connect a sewer and/or storm drain located at BLACKMER ST. (SE) CORN. OF SILVA ST.

Assessor's Plot 25A Lot 46, to the sewer and/or storm drain in BLACKMER ST. Street

To be laid in accordance with the conditions in this application and the City of New Bedford ordinances.

TYPE OF USE: RESIDENTIAL COMMERCIAL INDUSTRIAL OTHER

If applicant other than actual property owner, attach Letter of Authorization from Property Owner.

Name ROBERT MARTIN Tel. 508-954-3106

Mailing Address PO Box 50010 New Bedford, MA

The Bonded Contractor/Drain Layer authorized to perform this work is:

FRANK CORP. 615 Tarkenton Hill Rd. NB, MA 02745 508-995-9997

Name Address Tel.

Type of Pipe Required: PVC - SDR-35

PERMIT EXPIRES ONE YEAR AFTER DATE OF ISSUE

- Requires separate connections for sewage and storm drain where applicable. Storm water cannot be discharged to a sanitary sewer.
- All work must be inspected and approved by a D.P.I. inspector before backfilling.
- If this connection is to be part of a private service shared jointly with other building owners, attach copy of Recorded Joint Maintenance Agreement.
- Permits can be issued to Industrial and/or Commercial Applicants only upon receipt and approval by the Commissioner of Public Infrastructure of required plans and supplemental information.
- In addition, a City-issued Industrial User Discharge Permit and/or a Sewer Extension/Connection Permit issued by the Commonwealth of Massachusetts D.E.P. shall be required by the City for Industrial Discharge into the sewer system.

Industrial User Discharge Permit No. Date

Comm. Mass. Sewer Conn./Ext. Permit No. Date

A Filing and Inspection Fee of \$150, plus an Entrance Fee of \$, where applicable, must accompany this application.

Bank# Citizen's Bank Check# 4012 Date 5/3/04 Receipt# 4875

Other requirements: Insp. Only - "Storm drainage Only" to be connected thru sewer stub easement into abutting Lot #47. Sewer to connect to it's own service.

Connection made to Sewer Easement Plan to be submitted to this department  
Storm Drain Part of jointly-shared private line YES NO  
storm sewer drain

Applicant agrees to abide by the above terms, as well as all pertinent ordinances of the City of New Bedford, and such other special rules as the Commissioner of Public Infrastructure and/or City Engineer may deem necessary

Duarte M. Andrade (ms)  
Acting City Engineer

Robert Martin  
Signature of Property Owner or Representative

INSPECTOR'S REPORT

INSPECTED BY:

DATE:

COMMENTS:

APPROVED

DISAPPROVED

SIGNATURE

SKETCH PLAN





CITY OF NEW BEDFORD  
MASSACHUSETTS

DEPT. OF PUBLIC WORKS

133 WILLIAM STREET

LAWRENCE D. WORDEN  
COMMISSIONER

To Whom It May Concern:

I, MICHAEL A TRAZZERA 41 ANTONIO COSTA BLVD  
SEA GOLD SEAFOOD PRODUCTS INC NEW BEDFORD MA, being  
Name (Print) Mailing Address

owner of property located at LOT 5 PLOT 25A BLACKMEER ST

Plot 25A, Lot 5, hereby agree to allow ROBERT D MARTIN  
Name

P O BOX 50010 NEW BEDFORD MA to act on my behalf,  
Mailing Address

including affixing my signature, in securing permits for:

- ☒ Sewer/Drain Service Permits
- ☒ Water Service Permits
- ☒ Driveway Installation Permits
- ☒ Sidewalk Installation Permits

I further agree to conform to, and abide by, all City rules and regulations applicable to the permits(s) being applied for.

Name

(Signature)

48 ANTONIO COSTA BLVD NB  
Address

4-17-04  
Date

TEL: 508 993 3066

*Lawrence D. Worden*  
Commission Expires 10/05/05


QUITCLAIM DEED

I, Lars Vinjerud, II of 4 Windward Way, Fairhaven, Bristol County,  
Massachusetts, for consideration paid, and in full consideration  
of One hundred and Sixty-four thousand Dollars  
grant to Absecon Company, LLC a duly formed Massachusetts  
~~limited liability company~~  
~~corporation~~ having a usual place of business at 48 Antonio Costa Boulevard,  
New Bedford, Massachusetts with quitclaim covenants  
~~and as tenants in common,~~  
the land in New Bedford, Bristol County, Massachusetts, bounded and described as  
follows:

For description and easements see attached Schedule "A".

Being a portion of the premises deeded to this grantor by New Bedford  
Redevelopment Authority dated July 12, 2001 recorded in Bristol County Registry  
of Deeds in Book 5067, Page 164. Also subject to all conditions and restrictions as  
set forth in the aforementioned deed.

Witness my hand and seal this 27<sup>th</sup> day of January of 2004.

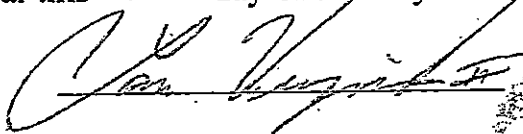

The Commonwealth of Massachusetts

Bristol, ss.

January 27, 2004


Then personally appeared the above-named Lars Vinjerud, II and  
acknowledged the foregoing instrument to be his free act and deed, before me

REG. OF DEEDS  
REG. #07  
BRISTOL S

01/28/04 12:44PM  
000000 08599

FEE \$747.84

CASH \$747.84

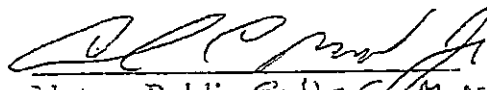

Notary Public Emile E. Morad Jr.  
My commission expires: 3/5/10

SCHEDULE "A"

A certain parcel of land located in New Bedford, Bristol County, Commonwealth of Massachusetts and shown as Parcel "A" on a plan of land entitled "Approval Not Required Plan of Land Blackmer and Silva Streets, New Bedford, Massachusetts, prepared for Lars Vinjerud II" Scale 1" = 30', September 23, 2003 prepared by Kenneth R. Ferreira Engineering, Inc., which Plan is duly recorded in the Bristol (S.D.) Registry of Deeds in Plan Book 152 at Plan 66, is further identified as follows:

**Beginning**, at a point on the southerly sideline of Blackmer Street, said point being the northwest corner of Parcel B on the above referenced plan and the northeast corner of the parcel being described;

**Thence**, by said Parcel "B" South 13° 19' 07" East, Two Hundred Seventy-seven and 30/100 (277.30) feet to a corner and land now or formerly owned by the New Bedford Redevelopment Authority;

**Thence**, by said Authority South 78° 11' 49" West, Ninety-six and 74/100 (96.74) feet to a corner on the terminus of Silva Street;

**Thence**, by said terminus of Silva Street by a curve deflecting to the left having a radius of Seventy-five and 00/100 (75.00) feet and an arc length of One Hundred Seven and 18/100 (107.18) feet to a point of reverse curvature;

**Thence**, by a curve deflecting to the right having a radius of Thirty and 00/100 (30.00) feet and an arc length of Thirty and 58/100 (30.58) feet to a point of tangency;

**Thence**, continuing by said easterly sideline of Silva Street North 13° 19' 07" West, One hundred twenty-five and 43/100 (125.43) feet to a point of curvature;

**Thence**, by a curve deflecting to the right having a radius of Thirty and 00/100 (30.00) feet and an arc length of Forty-seven and 12/100 (47.12) feet to a point of tangency;

**Thence**, by said southerly line of Blackmer Street North 76° 40' 53" East, One Hundred Ten and 50/100 (110.50) feet to the point of beginning;

Containing 34, 467 square feet more or less.

Said parcel is subject to an existing water main easement for the benefit of the City of New Bedford as shown on the plan.

The Grantor retains the benefit of an easement to erect and maintain a sign for the benefit of the remaining land of the Grantor. The burdened portion of the granted parcel is that portion of the

parcel at the intersection of Blackmer and Silva Street beginning at the point of curvature at the intersection of said street deflecting to the right having a radius of Thirty and 00/100 (30.00) feet, and arc of Forty-seven and 12/100 (47.12) to a point of tangency; thence, South 31° 40' 53" West Forty-two and 43/100 (42.43) feet to the point of beginning, said sign location is further subject to the City of New Bedford Zoning Code Sec. 2740 Vision Clearance on Corner Lots. The forgoing notwithstanding, so long as there is erected in the easement area a common sign, the Grantor's right shall be limited to the right to use two-thirds ( $\frac{2}{3}$ ) of the sign area. Grantor agrees to share proportionately in the maintenance and lighting of said sign.

Included in this conveyance is an easement to enter upon Parcel B. and maintain drainage facilities as heretofore approved by the New Bedford Conservation Commission, a plan setting forth such drainage structures is to be recorded hereafter. Except in cases of emergency grantee shall provide record owner with 48-business hour prior written notice.

Parcel A is granted the right to connect to the drainage infrastructure on Parcel B. Furthermore, neither Parcel A or B will create any diversion or regrading which will alter the drainage patterns designed on the Site Plan prepared for Fleet Fisheries, Inc. and Sea Gold Seafood Products, Inc. submitted to the City of New Bedford Planning Board for approval dated January 16, 2004.

For title, see deed from New Bedford Redevelopment Authority, to Lars Vinjerud, II, recorded in Book 5067, page 164 on July 12, 2001 in the Bristol County (S.D.) Registry of Deeds.