



PERMIT NO.

23570

NO

SKETCH

(AS-BUILT
STUB)CITY OF NEW BEDFORD
SEWER AND/OR STORM DRAIN PERMIT

DATE 6/16/04

This certifies that permission is granted to

Robert + Christine Long 158 Chas. Melombo Blvd. N.B. 508-995-3275
Property Owner Address Tel.

To connect a sewer and/or storm drain located at 4.7 Lauren Dr

Assessor's Plot 132f Lot 84, to the sewer and/or storm drain in Lauren Dr Street

To be laid in accordance with the conditions in this application and the City of New Bedford ordinances.

TYPE OF USE: RESIDENTIAL COMMERCIAL INDUSTRIAL OTHER

330 gpd

If applicant other than actual property owner, attach Letter of Authorization from Property Owner.

Name Ralph Mulford Tel. 508-995-3275

Mailing Address 158 Chas. Melombo Blvd. N.B. Ma. 02745

The Bonded Contractor/Drain Layer authorized to perform this work is:

D. W. White Constr. Inc. 867 Middle Rd. Acushnet 508-763-8868

Name Address Tel.

Type of Pipe Required: pvc sch. 35

PERMIT EXPIRES ONE YEAR AFTER DATE OF ISSUE

- Requires separate connections for sewage and storm drain where applicable. Storm water cannot be discharged to a sanitary sewer.
- All work must be inspected and approved by a D.P.I. inspector before backfilling.
- If this connection is to be part of a private service shared jointly with other building owners, attach copy of Recorded Joint Maintenance Agreement.
- Permits can be issued to Industrial and/or Commercial Applicants only upon receipt and approval by the Commissioner of Public Infrastructure of required plans and supplemental information.
- In addition, a City-issued Industrial User Discharge Permit and/or a Sewer Extension/Connection Permit issued by the Commonwealth of Massachusetts D.E.P. shall be required by the City for Industrial Discharge into the sewer system.

Industrial User Discharge Permit No. Date.

Comm. Mass. Sewer Conn./Ext. Permit No. Date.

A Filing and Inspection Fee of \$150.00 plus an Entrance Fee of \$ where applicable, must accompany this application.

Bank# BCP Bank Check# 1795 Date 6/16/04 Receipt# 4925

Other requirements: 24 hr. inspection notice, 10" sewer main, 12" storm drain

Connection made to Sewer Part of jointly-shared private line YES NO
Storm Drain

Applicant agrees to abide by the above terms, as well as all pertinent ordinances of the City of New Bedford, and such other special rules as the Commissioner of Public Infrastructure and/or City Engineer may deem necessary

Quante M. Anderson
Acting City Engineer

Signature of Property Owner or Representative


INSPECTOR'S REPORT

INSPECTED BY: _____
DATE: _____
COMMENTS: _____

APPROVED

DISAP

SIGNATURE

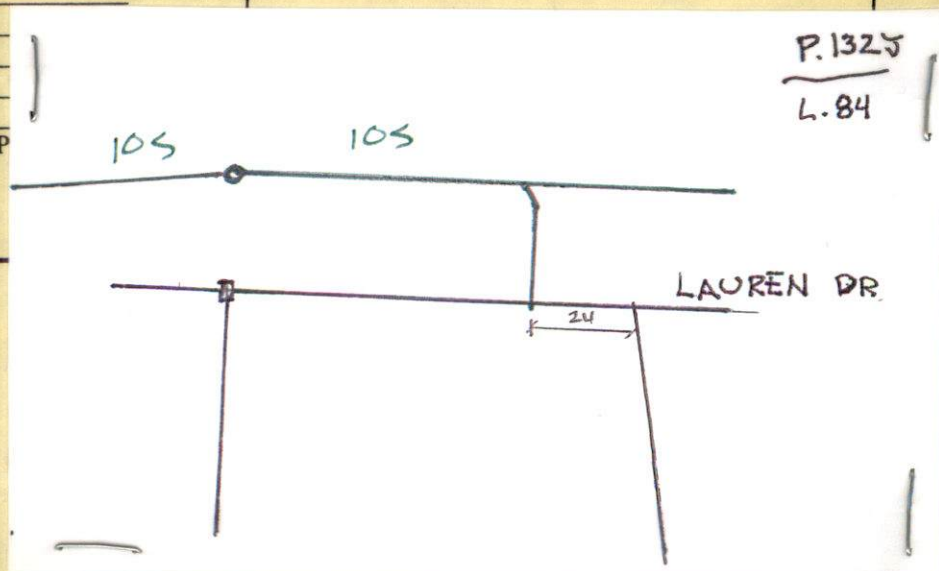



PERMIT NO.

23570

CITY OF NEW BEDFORD
SEWER AND/OR STORM DRAIN PERMIT

DATE 6/16/04

This certifies that permission is granted to

Robert & Christine Long 158 Chas. McLombas Blvd N.B. 508-995-3275
Property Owner Address Tel.

To connect a sewer and/or storm drain located at 47 Lauren Dr

Assessor's Plot 132 Lot 84, to the sewer and/or storm drain in Lauren Dr Street

To be laid in accordance with the conditions in this application and the City of New Bedford ordinances.

TYPE OF USE: RESIDENTIAL COMMERCIAL INDUSTRIAL OTHER

330 gpd

If applicant other than actual property owner, attach Letter of Authorization from Property Owner.

Name Ralph Mulford Tel 508-995-3275

Mailing Address 158 Chas. McLombas Blvd N.B. Ma 02745

The Bonded Contractor/Drain Layer authorized to perform this work is:

D. W. White Constr. Inc. 867 Middle Rd. Acushnet 508-763-8868

Name Address Tel.

Type of Pipe Required: pvc sdr 3.5

PERMIT EXPIRES ONE YEAR AFTER DATE OF ISSUE

- Requires separate connections for sewage and storm drain where applicable. Storm water cannot be discharged to a sanitary sewer.
- All work must be inspected and approved by a D.P.I. inspector before backfilling.
- If this connection is to be part of a private service shared jointly with other building owners, attach copy of Recorded Joint Maintenance Agreement.
- Permits can be issued to Industrial and/or Commercial Applicants only upon receipt and approval by the Commissioner of Public Infrastructure of required plans and supplemental information.
- In addition, a City-issued Industrial User Discharge Permit and/or a Sewer Extension/Connection Permit issued by the Commonwealth of Massachusetts D.E.P. shall be required by the City for Industrial Discharge into the sewer system.

Industrial User Discharge Permit No. Date

Comm. Mass. Sewer Conn./Ext. Permit No. Date

A Filing and Inspection Fee of \$150.00 plus an Entrance Fee of \$ where applicable, must accompany this application.

Bank# BCP Bank Check# 1795 Date 6/16/04 Receipt# 4925

Other requirements: 24 hr. inspection notice, 10" sewer main, 12" storm drain

Connection made to Sewer Part of jointly-shared private line YES NO
Storm Drain

Applicant agrees to abide by the above terms, as well as all pertinent ordinances of the City of New Bedford, and such other special rules as the Commissioner of Public Infrastructure and/or City Engineer may deem necessary

Duarte M. Andrade
Acting City Engineer mn

Signature of Property Owner or Representative

INSPECTOR'S REPORT

INSPECTED BY: _____

DATE: _____

COMMENTS: _____

APPROVED

DISAPPROVED

SIGNATURE

SKETCH PLAN



"Long" on Quality

A Division of Long Realty Inc.

(508) 995-8240 158 CHARLES MCCOMBS BOULEVARD, NEW BEDFORD, MA 02745

FAX: (508) 995-3275

July 14, 2003

Mr. Duarte Andrade
Acting Chief Engineer
Engineering Department
City of New Bedford
133 William Street
New Bedford, MA 02740

Re: Authorization of Agent

Dear Mr. Andrade:

This letter will confirm that Chip Mulford, Long Realty Inc./Long Built Homes' Corporate Attorney, is authorized to act on the Corporation's behalf, including affixing its Corporate signature, when applying for and securing permits from your Department, including but not limited to the following:


1. Sewer/Drain Service Permits;
2. Water Service Permits;
3. Driveway Installation Permits; and
4. Sidewalk Installation Permits.

Long Realty Inc./Long Built Homes, acting through Mr. Mulford, its Agent, agrees to conform to and abide by all City rules and regulations applicable to any permits being applied for.

Thank you in advance for your cooperation.

Sincerely,

Long Realty Inc./Long Built Homes

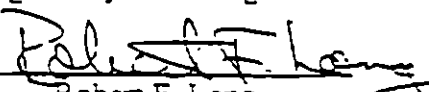By: 
Robert F. Long
President & Treasurer

158 Charles McCombs Boulevard
New Bedford, MA 02745
(508) 995-8240



CITY OF NEW BEDFORD

13820

NO. **106104**

LICENSE NO. _____

DATE

6/1020 04

LDING PERMIT

.14 — Any permit issued shall be deemed abandoned and invalid unless the work
by it shall have been commenced within six (6) months after its issuance.

LONG BUILT HOMES, owner/contractor

28' x 62'
AUREN DRIVE

Accepting this permit shall in every respect conform to the terms of the application therefore on
provisions of the statute of the Commonwealth and to the by-laws of the City of New Bedford
erection, enlarging, altering, raising, moving, repairing, or tearing down of a building.

THIS IS TO
BE CONSIDERED
A FOUNDATION
PERMIT → NOT
BUILDING
USE THIS #
WHEN
CALLING
FOR
FOUNDATION
INSPECTION

CITY DEPARTMENT/COMMISSION COMMENTS

The following department/commission has expressed concern about the issuance
of this permit. You are advised to contact that agency to resolve this matter.

Department/Commission:
Comments:

BUILDING DEPARTMENT COMMENTS

R & C Long

#47
1325 Lot 84

Foundation

YOUR AREA INSPECTOR IS: Tom Welch

Tel. 979-1540 Between 8:00 AM — 9:00 AM

NOTICE: NOTIFY INSPECTOR 48 HOURS
IN ADVANCE OF APPLYING
SHEATHING OR LATHING

OCCUPANCY PERMIT REQUIRED BEFORE OCCUPANCY

No Building or Structure shall be used or occupied until the Certificate of Use and
Occupancy shall have been issued by the Building Commissioner — MSBC, Sect.
120.1 —

THIS CARD MUST BE DISPLAYED IN A CONSPICUOUS PLACE ON THE PREMISES
AND NOT TORN DOWN OR REMOVED UNTIL COMPLETION OF WORK

SUBJECT TO MASSACHUSETTS STATE
BUILDING CODE REQUIREMENTS