

PERMIT NO.

23579



CITY OF NEW BEDFORD
SEWER AND/OR STORM DRAIN PERMIT

DATE 7/15/04

This certifies that permission is granted to

Town of Acushnet for

Dawn + Joseph Rogers 520 Bartlett St. Acushnet

Property Owner

Address

Tel.

110' - 120' north of sewer manhole in

To connect a sewer and/or storm drain located at Bartlett St. opposite Stratford St.

Assessor's Plot n-a Lot 24 40R, to the sewer and/or storm drain in 8" Bartlett St. Street

To be laid in accordance with the conditions in this application and the City of New Bedford ordinances.

TYPE OF USE: ☒ RESIDENTIAL ☐ COMMERCIAL ☐ INDUSTRIAL ☐ OTHER

330 gpd

If applicant other than actual property owner, attach Letter of Authorization from Property Owner.

Name n/a Tel.

Mailing Address

The Bonded Contractor/Drain Layer authorized to perform this work is:

R. J. Canessa Exc. P.O. Box 51643 N.B. 508-763-4827

Name

Address

Tel.

Type of Pipe Required: S.D.R. 35 P.V.C.

PERMIT EXPIRES ONE YEAR AFTER DATE OF ISSUE

- Requires separate connections for sewage and storm drain where applicable. Storm water cannot be discharged to a sanitary sewer.
 - All work must be inspected and approved by a D.P.I. inspector before backfilling.
 - If this connection is to be part of a private service shared jointly with other building owners, attach copy of Recorded Joint Maintenance Agreement.
 - Permits can be issued to Industrial and/or Commercial Applicants only upon receipt and approval by the Commissioner of Public Infrastructure of required plans and supplemental information.
 - In addition, a City-issued Industrial User Discharge Permit and/or a Sewer Extension/Connection Permit issued by the Commonwealth of Massachusetts D.E.P. shall be required by the City for Industrial Discharge into the sewer system.
- Industrial User Discharge Permit No. Date

Comm. Mass. Sewer Conn./Ext. Permit No. Date

A Filing and Inspection Fee of \$150.00 plus an Entrance Fee of \$ where applicable, must accompany this application.

Bank# NB Credit Union Check# 421 Date 6/24/04 Receipt# 4941

Other requirements: 24 hr. inspection notice 508-979-1527

Street disturbance & obstruction permits are required

Connection made to ☒ Sewer ☐ Storm Drain Part of jointly-shared private line YES ☒ NO

Applicant agrees to abide by the above terms, as well as all pertinent ordinances of the City of New Bedford, and such other special rules as the Commissioner of Public Infrastructure and/or City Engineer may deem necessary.

Quante, Mr. Andradey.
Acting City Engineer mn

Paul J. ...
Signature of Property Owner or Representative
Acushnet's Rep. D. P. W.


INSPECTOR'S REPORT

INSPECTED BY: _____
DATE: _____
COMMENTS: _____

APPROVED

DISAPPROVED

SIGNATURE

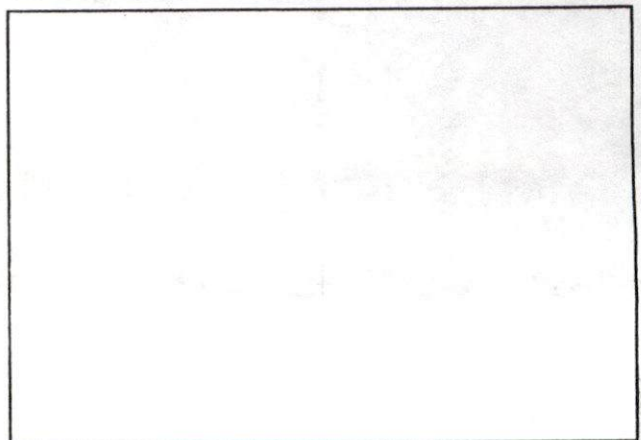

SKETCH PLAN

PERMIT NO.

1068



TOWN OF ACUSHNET
WATER, SEWER AND/OR STORM DRAIN PERMIT

DATE July 9, 2004

This certifies that permission is granted to

Joseph + Dawn Rogers 520 Boutlett St.
Property Owner Address Tel.

to connect a water/sewer located at 520 Boutlett St.

Assessor's Plot 24, Lot 40 Q, to the water/sewer in New Bedford/Boutlett Street
to be laid in accordance with the conditions in this application and the Town of Acushnet rules and regulations.

TYPE OF USE: ☒ RESIDENTIAL ☐ COMMERCIAL ☐ INDUSTRIAL ☐ OTHER

If applicant other than actual property owner, attach Letter of Authorization from Property Owner.

Name _____ Tel. _____

Mailing Address _____

The Bonded Contractor/Drain Layer authorized to perform this work is:

R. J. Canessa ?
Name Address Tel.

Type of Pipe Required: (See attached) See attached

PERMIT EXPIRES ONE YEAR AFTER DATE OF ISSUE

- * Requires separate connections for sewage and storm drain where applicable. Storm water cannot be discharged to a sanitary sewer.
- * All work must be inspected and approved by a D.P.W. inspector before backfilling.
- * If this connection is to be part of a private service shared jointly with other building owners, attach copy of Recorded Joint Maintenance Agreement.
- * Permits can be issued to Industrial and/or Commercial Applicants only upon receipt and approval by the Superintendent of Public Works of required plans and supplemental information.
- * In addition, a Industrial User Discharge Permit and/or a Sewer Extension/Connection Permit issued by the Commonwealth of Massachusetts D.E.P. shall be required for Industrial Discharge into the sewer system.

Industrial User Discharge Permit No. N/A Date _____

Comm. Mass. Sewer Conn./Ext. Permit No. City of N.B. # 150.00 Date 7/9/04

A Filing and Inspection Fee of \$ 600.00, plus an Entrance Fee of \$ 75.00 where applicable, must accompany this application. Acushnet's fee

Bank # New Bedford Co. Un. Check # 118445 Date: 7/9/04 Receipt # 93149

Other requirements: City of New Bedford approval

Connection made to ☒ Sewer ☐ Water ☐ Storm Drain
Part of jointly-shared private line ☐ Yes ☒ No

FOR INSPECTION ONLY, A 24 HOUR NOTICE IS REQUIRED AND THE CONTRACTOR/APPLICANT IS REQUIRED TO NOTIFY THE DEPARTMENT AT 508-998-0230

Applicant agrees to abide by the above terms, as well as all pertinent regulations of the Town of Acushnet, and such other special rules as the Superintendent of Public Works may deem necessary

[Signature] Superintendent of Public Works [Signature] Signature of Property Owner or Representative

INSPECTOR'S REPORT

 
INSPECTED BY: _____

DATE: _____

COMMENTS: _____

☐ APPROVED ☐ DISAPPROVED

SIGNATURE




SKETCH PLAN

THURSDAY (17) 8-26-04 SUNNY 80°

520 BARTLETT ST - ACUSHNET
SEWER INSPECTION

PERMIT # 23579

CONTRACTOR R.J. KAMESA
508-763-4827

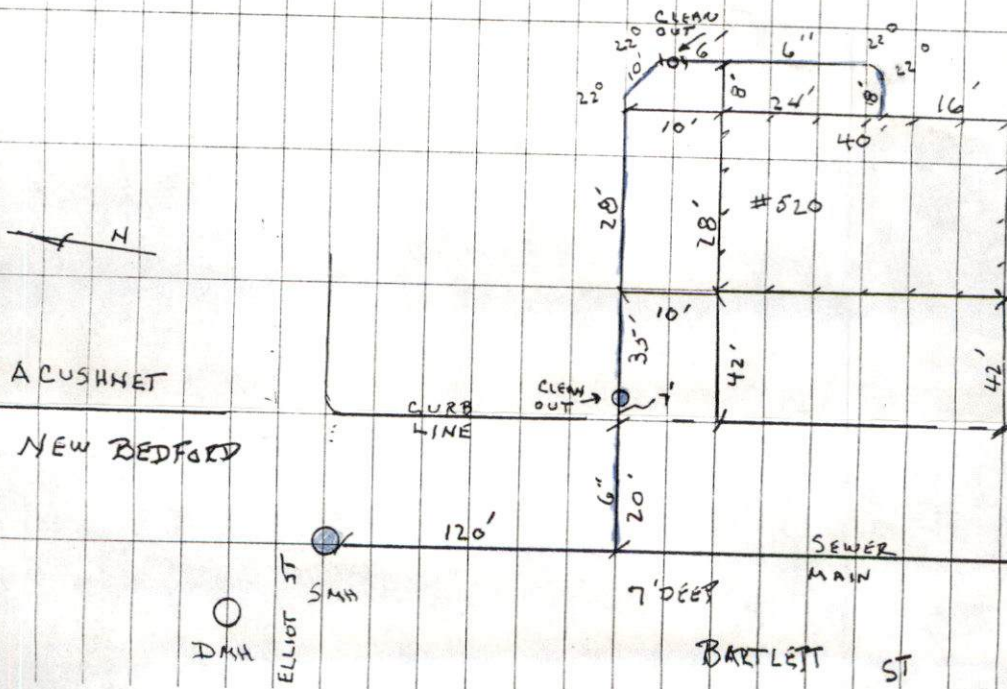

CLIENT'S
COPY


500 99799 76

RE: Town of Acushnet Sewer and Drain Permits Connecting Directly into
New Bedford System

Procedure to issue Sewer & Drain Permits:

1. Applicant files with the Town of Acushnet for Sewer Tie-In Permit.
2. Town of Acushnet submits plans for Engineering Department Review & Approval
3. When approval is received, Town of Acushnet Official must file and sign Sewer & Drain Permit application, and submit a check from applicant payable to the "City of New Bedford" for \$150.00
4. All work within New Bedford to be done by a bonded contractor approved by the Engineering Department.
5. Street Disturbance and Street Obstruction Permits to be acquired by Bonded Contractor.
6. A 24 hour notice is required for inspection of the work prior to backfilling the trenches.

Cc: Town of Acushnet, D.P.W.

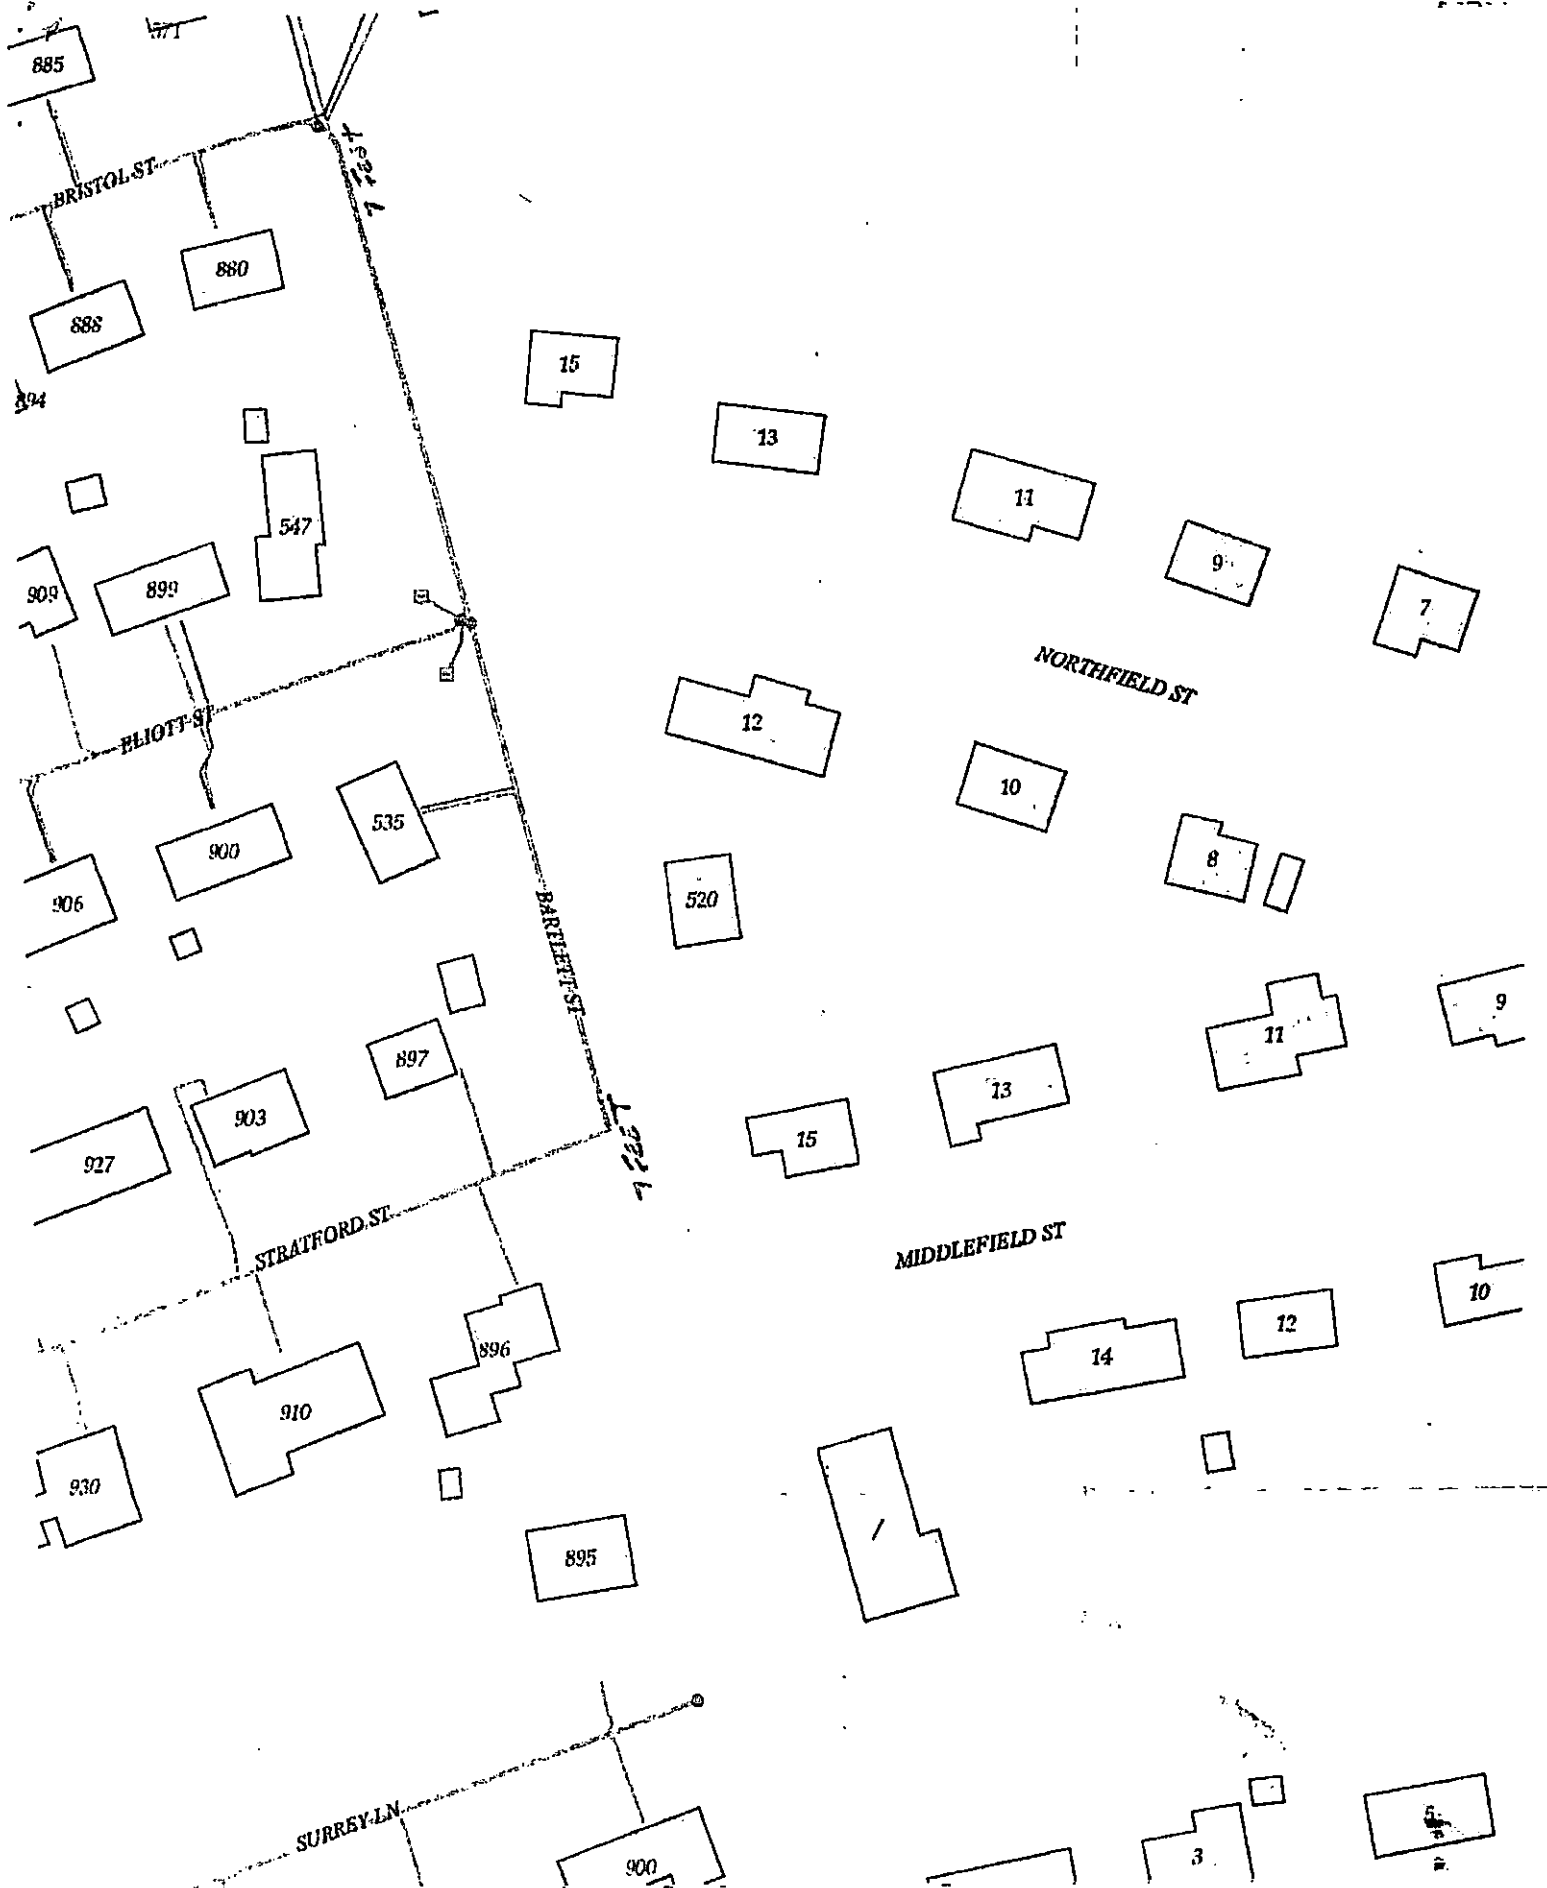


percolation test: 12"-9" in 24 mins.
 9"-6" in 33 Mins! perc. hole 14"x38"
 perc Rate per 1" in 10 Mins: 40 seconds.
 Soil tested Oct 28, 1969.



105 NO. 12 NORTH ST.
 New Bedford and
 Acushnet town line
 Meadow Acres
 Acushnet, Mass.

Construction Builder
 John Deterre Constr. Co.
 146 Milford St.
 New Bedford, Mass.

profile of leaching Bed 500' sqm.
 finished grade 4"-6" of loam
 per stone as over cover 6"
 0.13 perforated pipe 4-22' length
 up to 4" above level
 24"-15" crushed stone
 24" Run of Bank gravel Bolder clay neg

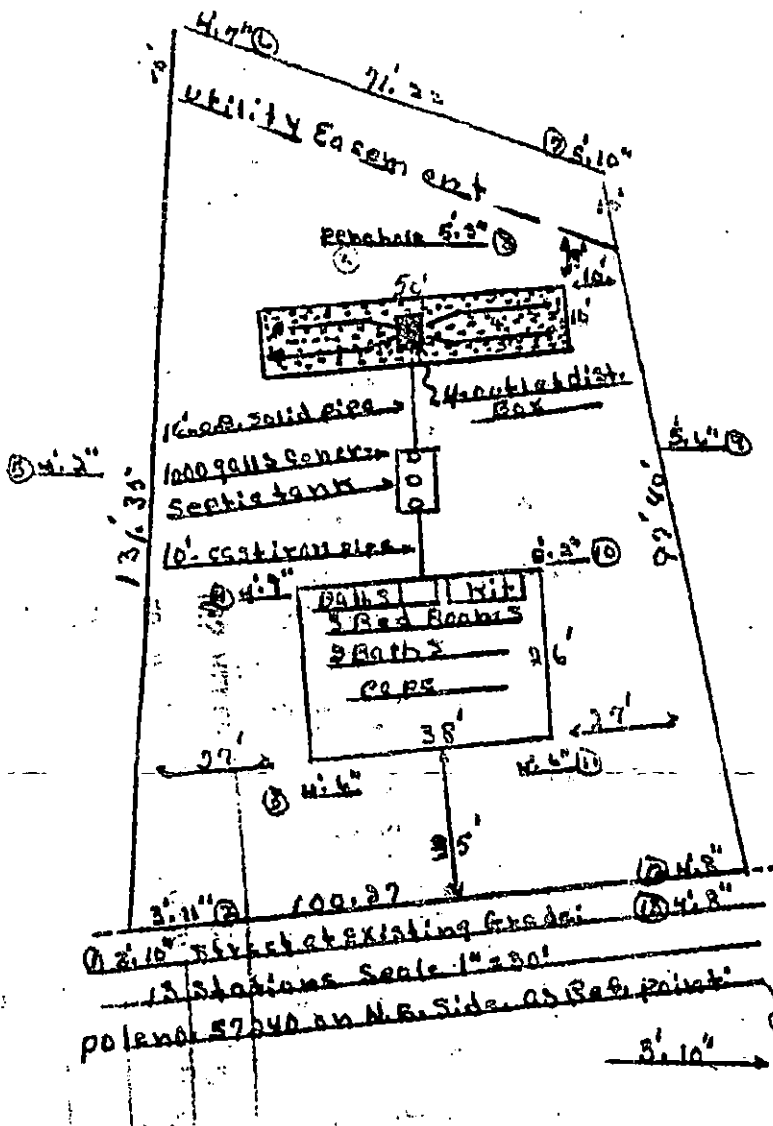

Permit # 105 1969

REGISTERED
 MASS. REG. #406
 SANITARIAN
 MANUEL RAPOSA, JR.

M. Raposa P.E.S.
Oct. 29, 1969.

top of house foundation
to set 24" above street
level

#520

lot 40