



PERMIT NO.
23595

CITY OF NEW BEDFORD
SEWER AND/OR STORM DRAIN PERMIT

DATE 8/27/04
EXP. 8/27/05

This certifies that permission is granted to

Property Owner Orlando Mendes Address 209 Dawson St. NB MA 02745 Tel. 508-995-3167

To connect a sewer and/or storm drain located at Dawson St. NE corner of Conduit St.

Assessor's Plot 118 Lot 338, to the sewer and/or storm drain in Dawson St. Street

To be laid in accordance with the conditions in this application and the City of New Bedford ordinances.

TYPE OF USE: RESIDENTIAL COMMERCIAL INDUSTRIAL OTHER 220 GPD

If applicant other than actual property owner, attach Letter of Authorization from Property Owner.

Name..... Tel.....

Mailing Address.....

The Bonded Contractor/Drain Layer authorized to perform this work is:

Cordosa Contracting, Inc. 12 White St. Acushnet Ave. 998-5115

Name..... Address..... Tel.....

Type of Pipe Required: PVC SDR-35

PERMIT EXPIRES ONE YEAR AFTER DATE OF ISSUE

- Requires separate connections for sewage and storm drain where applicable. Storm water cannot be discharged to a sanitary sewer.
- All work must be inspected and approved by a D.P.I. inspector before backfilling.
- If this connection is to be part of a private service shared jointly with other building owners, attach copy of Recorded Joint Maintenance Agreement.
- Permits can be issued to Industrial and/or Commercial Applicants only upon receipt and approval by the Commissioner of Public Infrastructure of required plans and supplemental information.
- In addition, a City-issued Industrial User Discharge Permit and/or a Sewer Extension/Connection Permit issued by the Commonwealth of Massachusetts D.E.P. shall be required by the City for Industrial Discharge into the sewer system.

Industrial User Discharge Permit No..... Date.....

Comm. Mass. Sewer Conn./Ext. Permit No..... Date.....

A Filing and Inspection Fee of \$ 150, plus an Entrance Fee of \$..... where applicable, must accompany this application.

Bank# Fleet Check# 626 Date 8/27/04 Receipt# 4984

Other requirements: Insp Only - Connect to 18" Sewer + 36" Storm Drainage
Variance Granted #3507 (8/1/03)

Connection made to Sewer Part of jointly-shared private line YES NO
Storm Drain

Applicant agrees to abide by the above terms, as well as all pertinent ordinances of the City of New Bedford, and such other special rules as the Commissioner of Public Infrastructure and/or City Engineer may deem necessary

Quarte M. Andrade
Acting City Engineer

Orlando Mendes
Signature of Property Owner or Representative

INSPECTOR'S REPORT


INSPECTED BY: _____

DATE: _____

COMMENTS: _____

APPROVED _____ DIS. _____

SIGNATURE

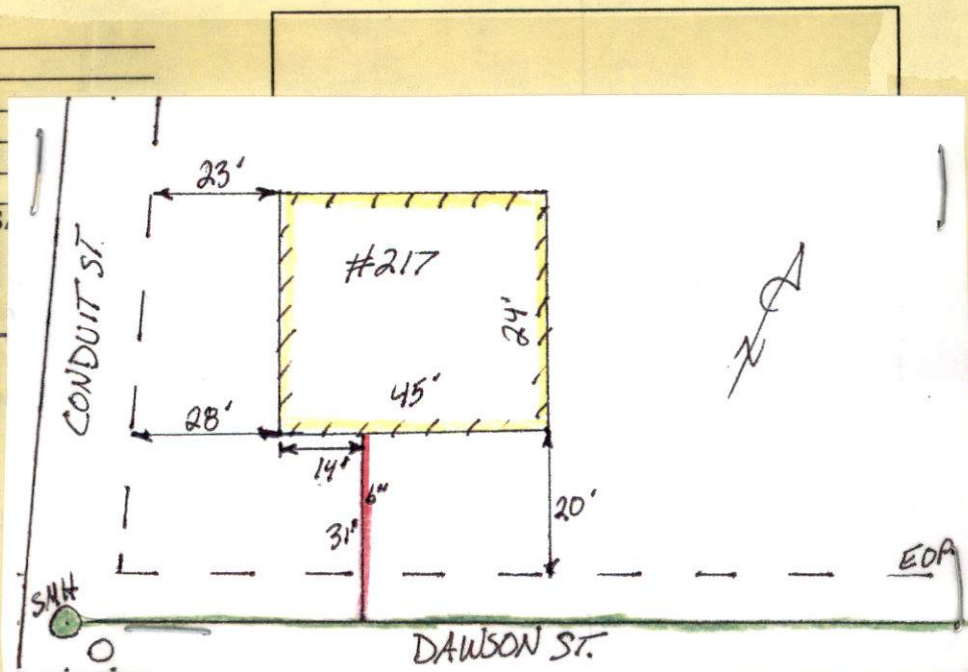



PERMIT NO.

23595

CITY OF NEW BEDFORD
SEWER AND/OR STORM DRAIN PERMIT

DATE 8/27/04
EXP. 8/27/05

This certifies that permission is granted to

Orlando Mendes 209 Dawson St. NB. MA 02745 508-995-3167
Property Owner Address Tel.

To connect a sewer and/or storm drain located at Dawson St. NE corner of Conduit St.

Assessor's Plot 118 Lot 338, to the sewer and/or storm drain in Dawson St. Street

To be laid in accordance with the conditions in this application and the City of New Bedford ordinances.

TYPE OF USE: RESIDENTIAL COMMERCIAL INDUSTRIAL OTHER 220 GPD

If applicant other than actual property owner, attach Letter of Authorization from Property Owner.

Name..... Tel.....

Mailing Address.....

The Bonded Contractor/Drain Layer authorized to perform this work is:

Cardoso Contracting, Inc. 12 White St. Acushnet, Ave. 998-5115

Name Address Tel.

Type of Pipe Required: PVC SDR-35

PERMIT EXPIRES ONE YEAR AFTER DATE OF ISSUE

- Requires separate connections for sewage and storm drain where applicable. Storm water cannot be discharged to a sanitary sewer.
 - All work must be inspected and approved by a D.P.I. inspector before backfilling.
 - If this connection is to be part of a private service shared jointly with other building owners, attach copy of Recorded Joint Maintenance Agreement.
 - Permits can be issued to Industrial and/or Commercial Applicants only upon receipt and approval by the Commissioner of Public Infrastructure of required plans and supplemental information.
 - In addition, a City-issued Industrial User Discharge Permit and/or a Sewer Extension/Connection Permit issued by the Commonwealth of Massachusetts D.E.P. shall be required by the City for Industrial Discharge into the sewer system.
- Industrial User Discharge Permit No..... Date.....

Comm. Mass. Sewer Conn./Ext. Permit No..... Date.....

A Filing and Inspection Fee of \$150, plus an Entrance Fee of \$..... where applicable, must accompany this application.

Bank# Fleet Check# 626 Date 8/27/04 Receipt# 4984

Other requirements: Insp. Only - Connect to 18" Sewer + 36" Storm Drainage
Variance Granted #3507 (8/15/03)

Connection made to Sewer Storm Drain Part of jointly-shared private line YES NO

Applicant agrees to abide by the above terms, as well as all pertinent ordinances of the City of New Bedford, and such other special rules as the Commissioner of Public Infrastructure and/or City Engineer may deem necessary

Quarte M. Andrade Acting City Engineer

Orlando Mendes Signature of Property Owner or Representative

INSPECTOR'S REPORT


INSPECTED BY: _____

DATE: _____


COMMENTS: _____

APPROVED DISAPPROVED


SIGNATURE

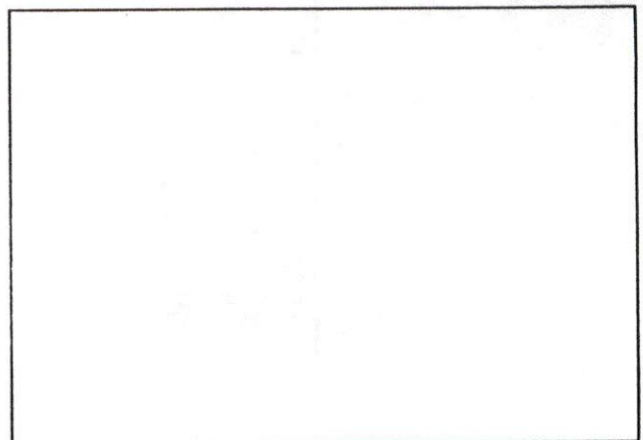

SKETCH PLAN

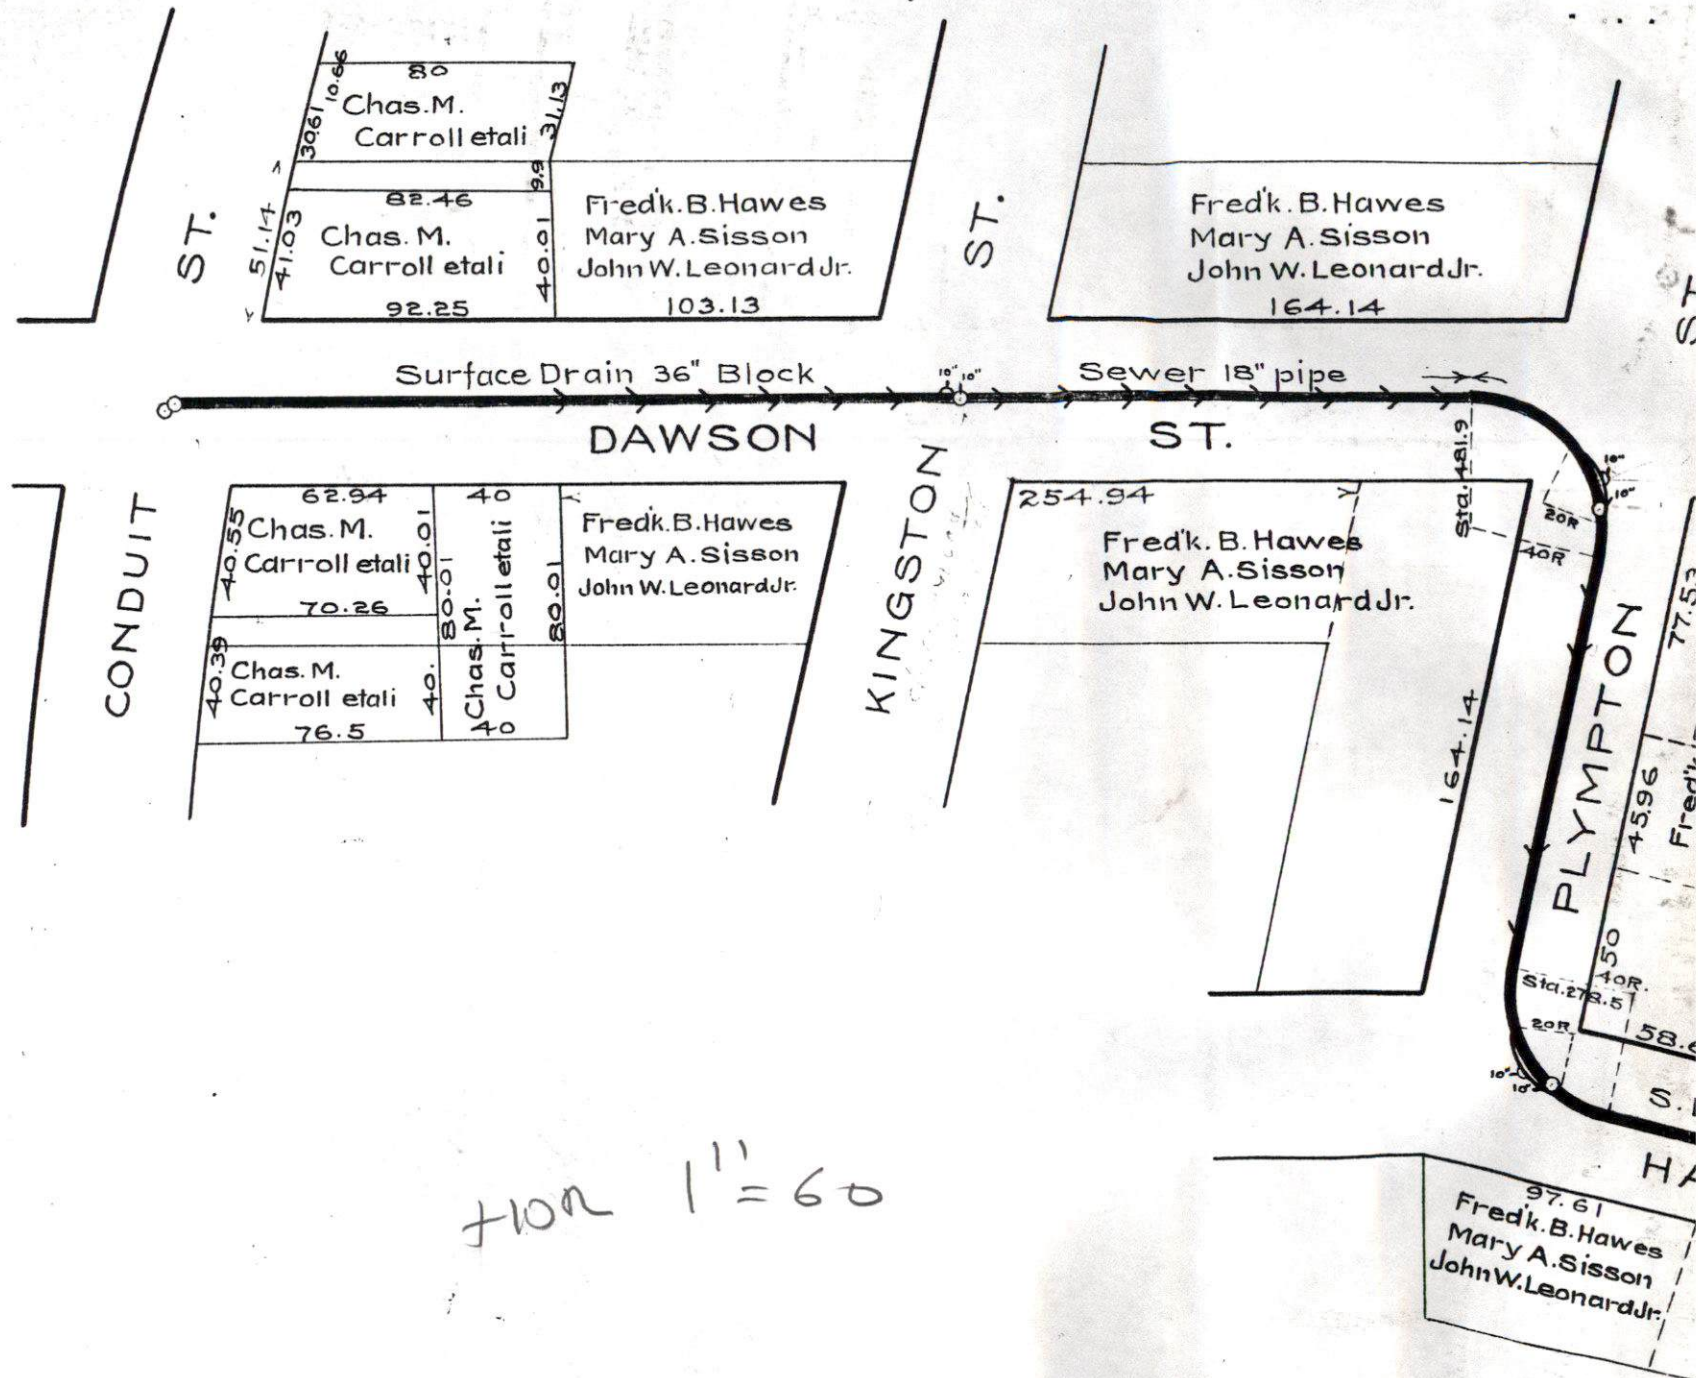

VCAT 1" = 6'

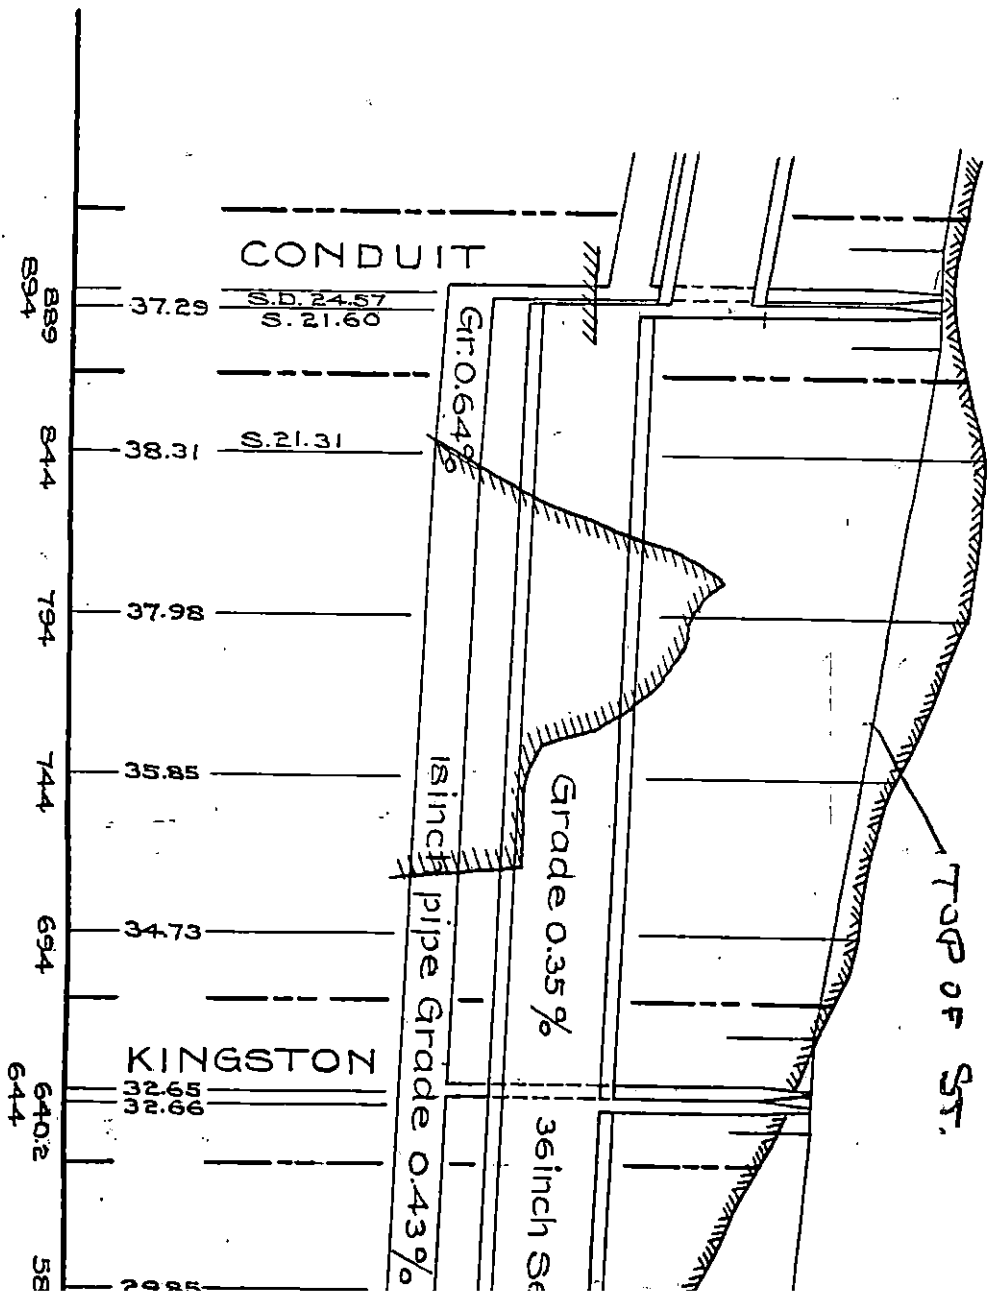

6/7/05 - 217 DAWSON ST. - NEC OF CONDUIT ST. CARDOSO CONTR - SANITARY ONLY

