



PERMIT NO.  
**23616**

CITY OF NEW BEDFORD  
SEWER AND/OR STORM DRAIN PERMIT

DATE 10/22/04  
EXP. 10/22/05

This certifies that permission is granted to

Lucia Bizarro 10 Nye St New Bedford MA 508-999-0295  
Property Owner Address Tel.

To connect a sewer and/or storm drain located at Nye St. SW corner of Belleville Ave.

Assessor's Plot 99 Lot 76, to the sewer and/or storm drain in 15" Sewer in Nye St. Street

To be laid in accordance with the conditions in this application and the City of New Bedford ordinances.

TYPE OF USE: RESIDENTIAL COMMERCIAL INDUSTRIAL OTHER 110 GPD

If applicant other than actual property owner, attach Letter of Authorization from Property Owner.

Name..... Tel.....

Mailing Address.....

The Bonded Contractor/Drain Layer authorized to perform this work is:

RJ Canessa PO Box 51643 New Bedford, MA 508-963-4827

Name Address Tel.

Type of Pipe Required: PVC SDR-35

PERMIT EXPIRES ONE YEAR AFTER DATE OF ISSUE

- Requires separate connections for sewage and storm drain where applicable. Storm water cannot be discharged to a sanitary sewer.
- All work must be inspected and approved by a D.P.I. inspector before backfilling.
- If this connection is to be part of a private service shared jointly with other building owners, attach copy of Recorded Joint Maintenance Agreement.
- Permits can be issued to Industrial and/or Commercial Applicants only upon receipt and approval by the Commissioner of Public Infrastructure of required plans and supplemental information.
- In addition, a City-issued Industrial User Discharge Permit and/or a Sewer Extension/Connection Permit issued by the Commonwealth of Massachusetts D.E.P. shall be required by the City for Industrial Discharge into the sewer system.

Industrial User Discharge Permit No..... Date.....

Comm. Mass. Sewer Conn./Ext. Permit No..... Date.....

A Filing and Inspection Fee of \$150....., plus an Entrance Fee of \$..... where applicable, must accompany this application.

Bank# Sovereign Check# 504 Date 10/22/04 Receipt# 5051

Other requirements: Insp. Only - Connect to 15" Sewer Main in Nye St.  
(Water + Sewer Services must be 10 feet apart)

Connection made to Sewer Part of jointly-shared private line YES NO  
Storm Drain

Applicant agrees to abide by the above terms, as well as all pertinent ordinances of the City of New Bedford, and such other special rules as the Commissioner of Public Infrastructure and/or City Engineer may deem necessary

Duarte M. Andrade  
Acting City Engineer


Lucia Bizarro  
Signature of Property Owner or Representative

INSPECTOR'S REPORT

INSPECTED BY: KEN REBELLO  
DATE: 11/18/04  
COMMENTS:

APPROVED DISAPPR

Ken Rebello  
SIGNATURE

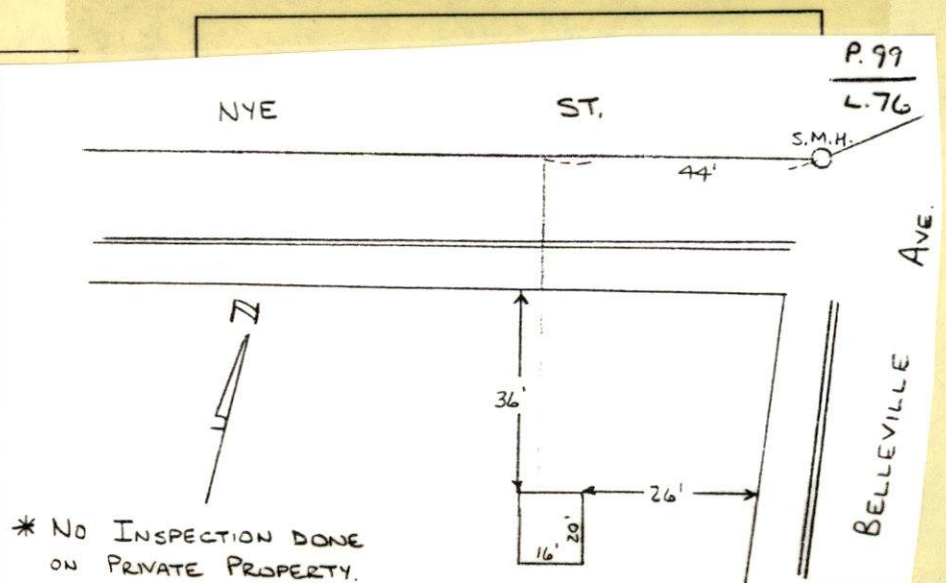





PERMIT NO.  
- 23616

CITY OF NEW BEDFORD  
SEWER AND/OR STORM DRAIN PERMIT

DATE 10/22/04  
Exp. 10/22/05

This certifies that permission is granted to

Lucia Bizarro 10 Nye St New Bedford MA 508-999-0095  
Property Owner Address Tel.

To connect a sewer and/or storm drain located at Nye St SW corner of Belleville Ave.

Assessor's Plot 99 Lot 76, to the sewer and/or storm drain in 15" Sewer in Nye St Street

To be laid in accordance with the conditions in this application and the City of New Bedford ordinances.

TYPE OF USE: RESIDENTIAL COMMERCIAL INDUSTRIAL OTHER 110 GPD

If applicant other than actual property owner, attach Letter of Authorization from Property Owner.

Name Tel.

Mailing Address

The Bonded Contractor/Drain Layer authorized to perform this work is:

RJ Canessa P.O. Box 51643 New Bedford, MA 508-963-4827

Name Address Tel.

Type of Pipe Required: PVC SDR-35

PERMIT EXPIRES ONE YEAR AFTER DATE OF ISSUE

- Requires separate connections for sewage and storm drain where applicable. Storm water cannot be discharged to a sanitary sewer.
- All work must be inspected and approved by a D.P.I. inspector before backfilling.
- If this connection is to be part of a private service shared jointly with other building owners, attach copy of Recorded Joint Maintenance Agreement.
- Permits can be issued to Industrial and/or Commercial Applicants only upon receipt and approval by the Commissioner of Public Infrastructure of required plans and supplemental information.
- In addition, a City-issued Industrial User Discharge Permit and/or a Sewer Extension/Connection Permit issued by the Commonwealth of Massachusetts D.E.P. shall be required by the City for Industrial Discharge into the sewer system.

Industrial User Discharge Permit No. Date.

Comm. Mass. Sewer Conn./Ext. Permit No. Date.

A Filing and Inspection Fee of \$150, plus an Entrance Fee of \$ where applicable, must accompany this application.

Bank# Sovereign Check# 504 Date 10/22/04 Receipt# 5051

Other requirements: Insp. Only - Connect to 15" Sewer Main in Nye St.  
(Water + Sewer Services must be 10 feet apart)

Connection made to Sewer Part of jointly-shared private line YES NO  
Storm Drain

Applicant agrees to abide by the above terms, as well as all pertinent ordinances of the City of New Bedford, and such other special rules as the Commissioner of Public Infrastructure and/or City Engineer may deem necessary

Quinto M. Andrade Acting City Engineer Signature of Property Owner or Representative

INSPECTOR'S REPORT


INSPECTED BY:

DATE:

COMMENTS:

APPROVED DISAPPROVED



SIGNATURE

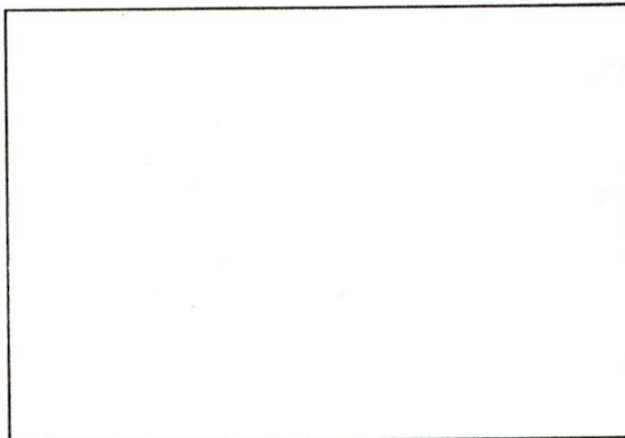

SKETCH PLAN

BELLEVILLE 2/1/11

11/18/04 KJ Canessa 6" San 10 NYE ST.

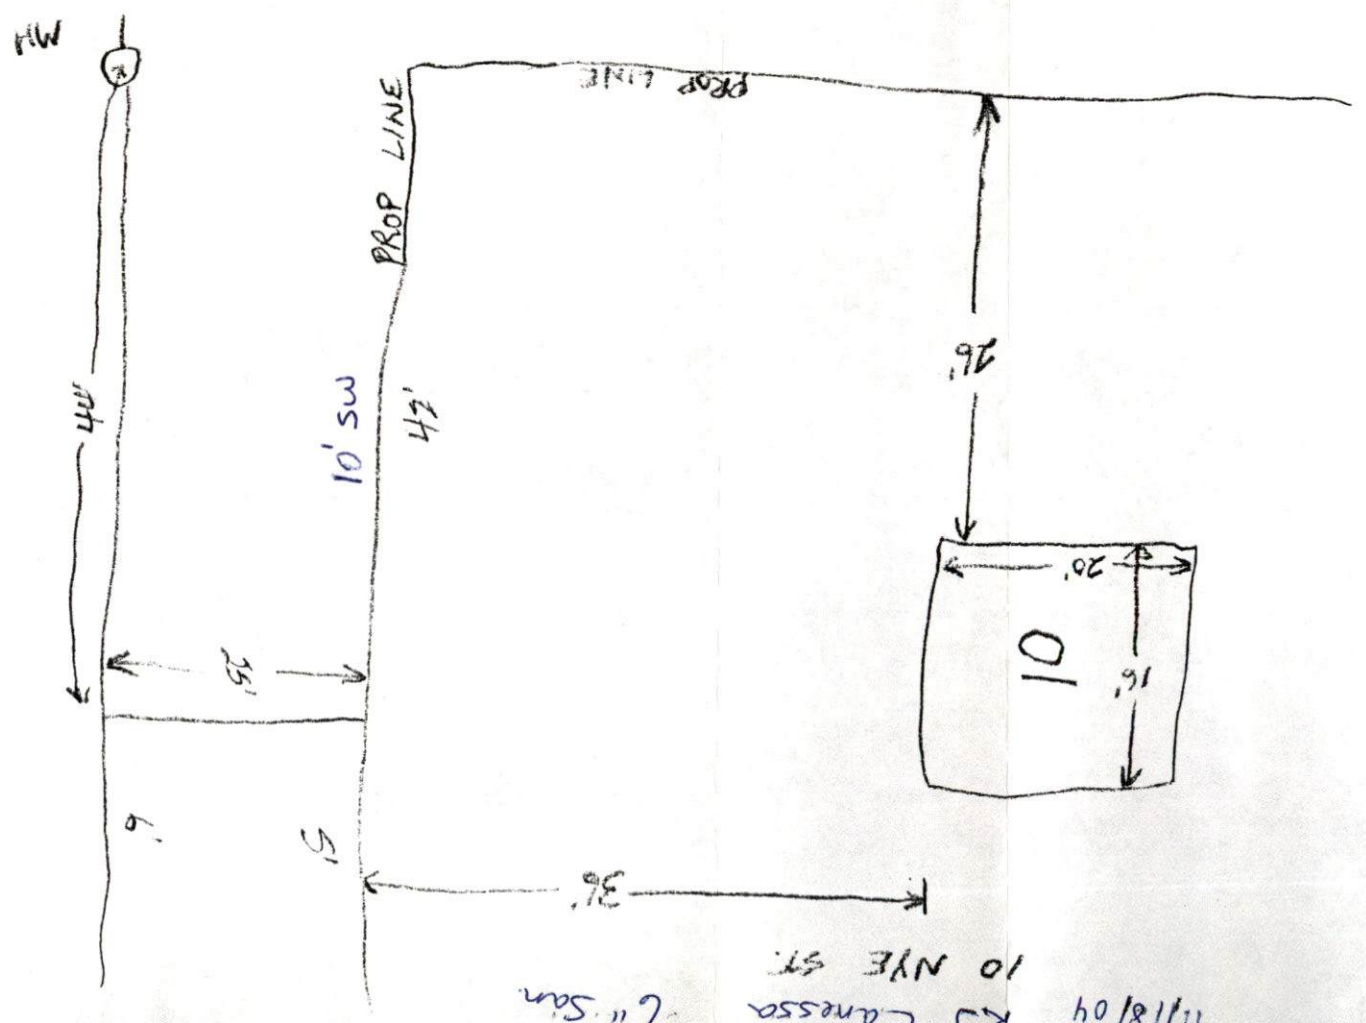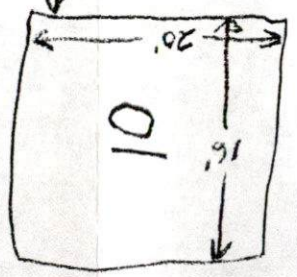

NNE ST.

MW

~~Kevin Cornell did from Prop Line to Bldg.~~  
clips  
Kevin did not do this inspection.

N