



PERMIT NO.

23642

CITY OF NEW BEDFORD  
SEWER AND/OR STORM DRAIN PERMIT

DATE 12/2/04

This certifies that permission is granted to

Property Owner: Carlos Antao  
Address: 315 Collette St. NB  
Tel. 508 990 3626 machine  
508 525 9332

To connect a sewer and/or storm drain located at Gisele's Way then to Acushnet Ave.

Assessor's Plot 134 Lot 432, to the sewer and/or storm drain in Gisele's Way Street

To be laid in accordance with the conditions in this application and the City of New Bedford ordinances.

TYPE OF USE: ☒ RESIDENTIAL ☐ COMMERCIAL ☐ INDUSTRIAL ☐ OTHER

3309 p.d.

If applicant other than actual property owner, attach Letter of Authorization from Property Owner.

Name..... Tel.....

Mailing Address.....

The Bonded Contractor/Drain Layer authorized to perform this work is:

Name: Menard Bros. Address: 307 County Rd. W Wareham, MA 02576 Tel. 508-995-4022

Type of Pipe Required: SDR 35 PVC

## PERMIT EXPIRES ONE YEAR AFTER DATE OF ISSUE

Foundation # 3932-04

- Requires separate connections for sewage and storm drain where applicable. Storm water cannot be discharged to a sanitary sewer.
  - All work must be inspected and approved by a D.P.I. inspector before backfilling.
  - If this connection is to be part of a private service shared jointly with other building owners, attach copy of Recorded Joint Maintenance Agreement.
  - Permits can be issued to Industrial and/or Commercial Applicants only upon receipt and approval by the Commissioner of Public Infrastructure of required plans and supplemental information.
  - In addition, a City-issued Industrial User Discharge Permit and/or a Sewer Extension/Connection Permit issued by the Commonwealth of Massachusetts D.E.P. shall be required by the City for Industrial Discharge into the sewer system.
- Industrial User Discharge Permit No. .... Date .....

Comm. Mass. Sewer Conn./Ext. Permit No. .... Date .....

A Filing and Inspection Fee of \$150.00, plus an Entrance Fee of \$1125.00 where applicable, must accompany this application.

Bank# First Citizens Check# 253 Date 11/7/04 Receipt# 5092

Other requirements: 24 hr. inspection notice at 508-979-1527,

2" force main to be connected to exist. slab at prop. line of 3503 Acushnet Ave.

Connection made to ☒ Sewer ☐ Storm Drain  
Part of jointly-shared private line YES ☐ NO


Applicant agrees to abide by the above terms, as well as all pertinent ordinances of the City of New Bedford, and such other special rules as the Commissioner of Public Infrastructure and/or City Engineer may deem necessary

Duarte M. Andrade (ms)  
Acting City Engineer

Signature of Property Owner or Representative

INSPECTED BY: Kevin S. Connel  
DATE: 11-08-05  
COMMENTS:

APPROVED DISAPPROVED

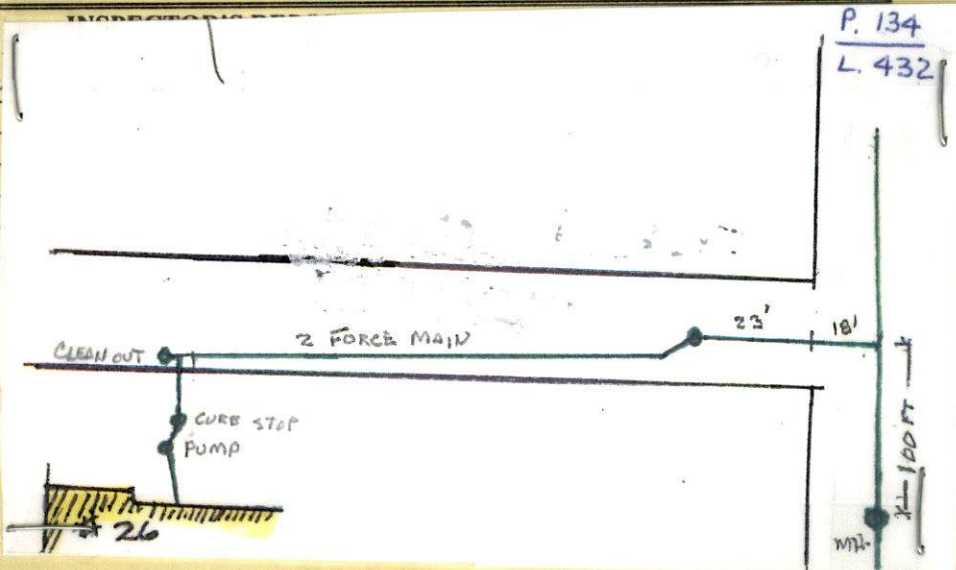Kevin S. Connel  
SIGNATURE





PERMIT NO.

CITY OF NEW BEDFORD  
SEWER AND/OR STORM DRAIN PERMIT

DATE 12/2/04

**23642**

This certifies that permission is granted to

Carlos Antao 315 Collette St. NB 508 990 3626 machine  
Property Owner Address Tel. 508 525 9332

To connect a sewer and/or storm drain located at Gisele's Way then to Acushnet Ave.

Assessor's Plot 134 Lot 432, to the sewer and/or storm drain in Gisele's Way Street

To be laid in accordance with the conditions in this application and the City of New Bedford ordinances.

TYPE OF USE: ☒ RESIDENTIAL ☐ COMMERCIAL ☐ INDUSTRIAL ☐ OTHER

3309 P.d.

If applicant other than actual property owner, attach Letter of Authorization from Property Owner.

Name..... Tel.....

Mailing Address.....

The Bonded Contractor/Drain Layer authorized to perform this work is:

Menard Bros 307 County Rd. W Wareham, MA 02576 508-995-4022  
Name Address Tel.

Type of Pipe Required: SDR 35 PVC

PERMIT EXPIRES ONE YEAR AFTER DATE OF ISSUE

foundation # 3932-04

- Requires separate connections for sewage and storm drain where applicable. Storm water cannot be discharged to a sanitary sewer.
- All work must be inspected and approved by a D.P.I. inspector before backfilling.
- If this connection is to be part of a private service shared jointly with other building owners, attach copy of Recorded Joint Maintenance Agreement.
- Permits can be issued to Industrial and/or Commercial Applicants only upon receipt and approval by the Commissioner of Public Infrastructure of required plans and supplemental information.
- In addition, a City-issued Industrial User Discharge Permit and/or a Sewer Extension/Connection Permit issued by the Commonwealth of Massachusetts D.E.P. shall be required by the City for Industrial Discharge into the sewer system.

Industrial User Discharge Permit No..... Date.....

Comm. Mass. Sewer Conn./Ext. Permit No..... Date.....

A Filing and Inspection Fee of \$150.00 plus an Entrance Fee of \$1125.00 where applicable, must accompany this application.

Bank# First Citizens Check# 253 Date 11/7/04 Receipt# 5092

Other requirements: 24 hr. inspection notice at 508-979-1527,

2" force main to be connected to exist. stub at prop. line of 3503 Acushnet Ave.

Connection made to Sewer Part of jointly-shared private line YES ☒ NO  
Storm Drain

Applicant agrees to abide by the above terms, as well as all pertinent ordinances of the City of New Bedford, and such other special rules as the Commissioner of Public Infrastructure and/or City Engineer may deem necessary

Duarte M. Andrade (ms)  
Acting City Engineer

[Signature]  
Signature of Property Owner or Representative

INSPECTOR'S REPORT

INSPECTED BY: \_\_\_\_\_


DATE: \_\_\_\_\_

COMMENTS: \_\_\_\_\_

\_\_\_\_\_

APPROVED \_\_\_\_\_ DISAPPROVED \_\_\_\_\_

SIGNATURE

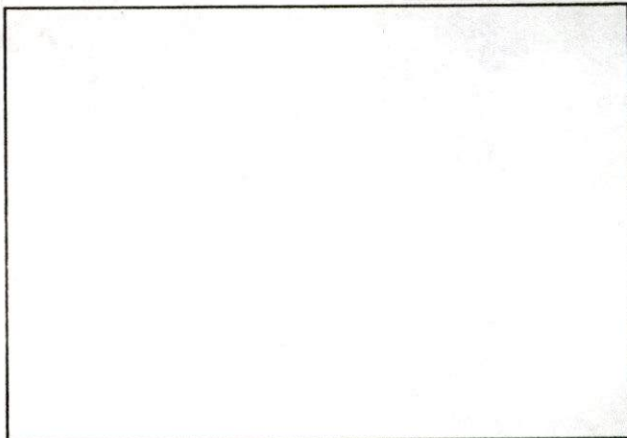

SKETCH PLAN

Permit Cost \$150.00

Main 250' @ \$2/LF 500.00

Stub 25' @ \$25/LF 625.00

for 3503

Total 1,275.00



5/9/97

ACUSHNET AVE

LA BONNE BEACH

2 DYNA HOES

2 LAZERS

2 DUMPS

2 UTILITY TRUCKS

1 BORCAT

2 SPREADERS


2 LAZERS

2 POLE DETAILS

WEL WORTH

BIL PANSKY

BROWN #3573 & 3501

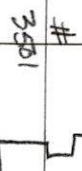

30' LOIN  
9' DEEP




115' LOIN TOTAL

(100)


210' LOIN  
10' DEEP

WOODED LOT  
ACCESS FROM #3472  
C. 280

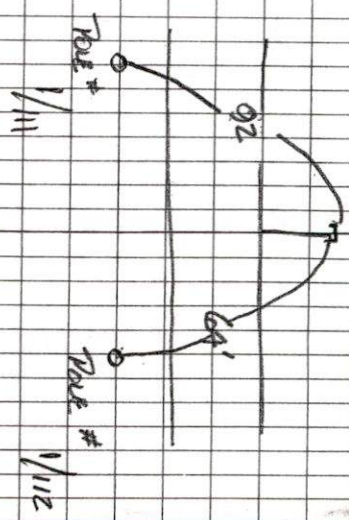


210' LOIN  
9' DEEP


WOODED LOT ACCESS FROM #3472

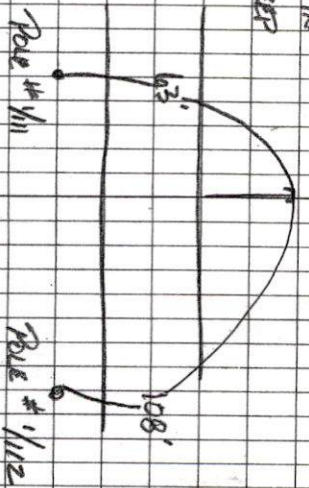

33' LOIN  
8.5' DEEP

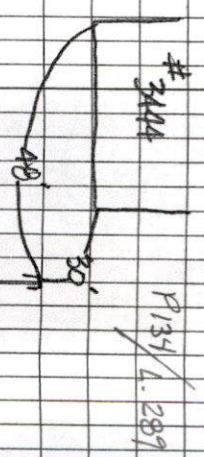

(107)

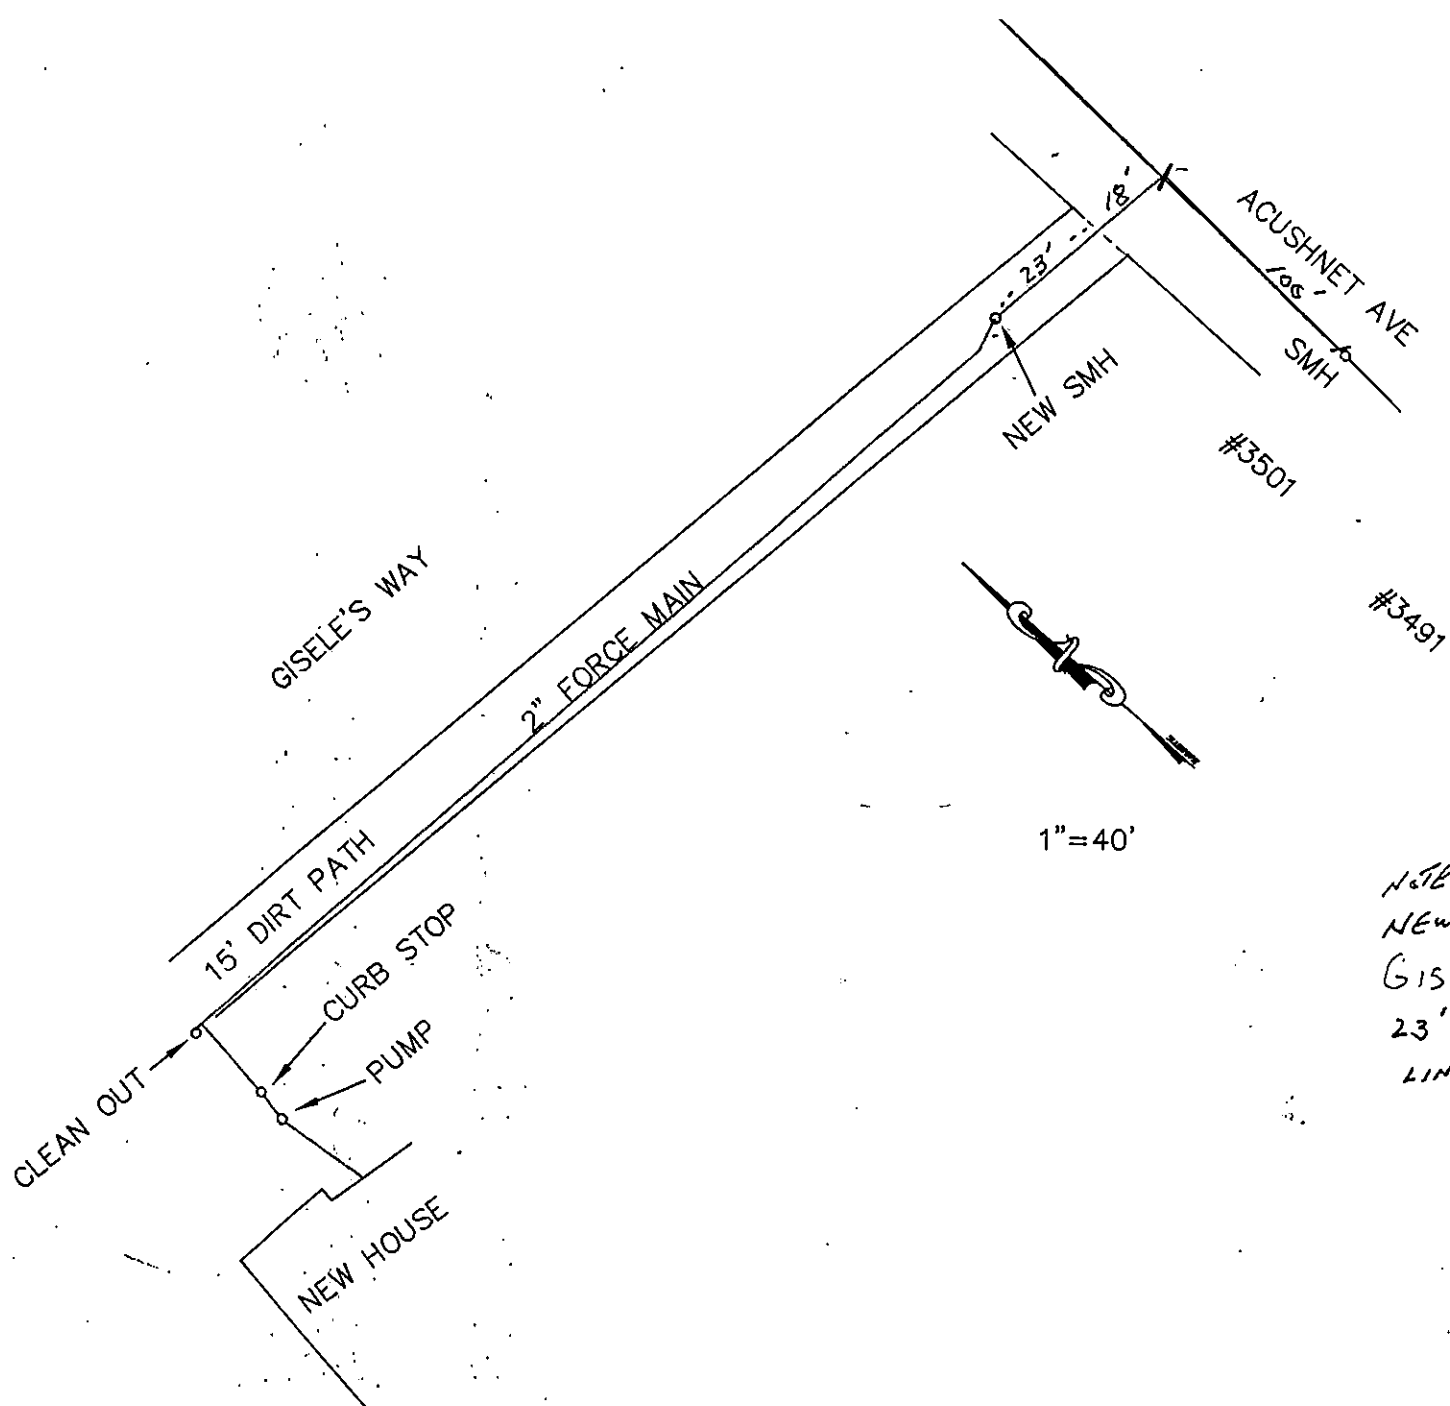

NOTE:  
NEW SMH ON  
GISELE'S WAY IS  
23'± WEST OF PROPERTY  
LINE