



PERMIT NO.

23666

CITY OF NEW BEDFORD
SEWER AND/OR STORM DRAIN PERMITDATE 3/22/05
EXP. 3/22/06

This certifies that permission is granted to

Property Owner Walden Land Co. Address 15 Hamilton St. New Bedford Ma Tel. (508) 993-1776To connect a sewer and/or storm drain located at #102 Nellie Rd. #402Assessor's Plot 121 Lot 192, to the sewer and/or storm drain in Nellie Rd. Street

To be laid in accordance with the conditions in this application and the City of New Bedford ordinances.

TYPE OF USE: RESIDENTIAL COMMERCIAL INDUSTRIAL OTHER 330 GPD

If applicant other than actual property owner, attach Letter of Authorization from Property Owner.

Name Richard Bailey Tel. (508) 990-8726Mailing Address 568 Canterbury LaneThe Bonded Contractor/Drain Layer authorized to perform this work is: Reis Asphalt (508) 996-0735Name PVC Address SDR-35 Tel.

Type of Pipe Required:

PERMIT EXPIRES ONE YEAR AFTER DATE OF ISSUE

- Requires separate connections for sewage and storm drain where applicable. Storm water cannot be discharged to a sanitary sewer.
 - All work must be inspected and approved by a D.P.I. inspector before backfilling.
 - If this connection is to be part of a private service shared jointly with other building owners, attach copy of Recorded Joint Maintenance Agreement.
 - Permits can be issued to Industrial and/or Commercial Applicants only upon receipt and approval by the Commissioner of Public Infrastructure of required plans and supplemental information.
 - In addition, a City-issued Industrial User Discharge Permit and/or a Sewer Extension/Connection Permit issued by the Commonwealth of Massachusetts D.E.P. shall be required by the City for Industrial Discharge into the sewer system.
- Industrial User Discharge Permit No. Date

Comm. Mass. Sewer Conn./Ext. Permit No. Date

A Filing and Inspection Fee of \$ 150.00 plus an Entrance Fee of \$ --- where applicable, must accompany this application.Bank# First Fed. Check# 2476 Date 3/22/05 Receipt# 5127Other requirements: Imp Only - connect to 8" sewer & 6" storm drain
24 hrs notice for all inspectionsConnection made to Sewer Part of jointly-shared private line YES NO
Storm Drain


Applicant agrees to abide by the above terms, as well as all pertinent ordinances of the City of New Bedford, and such other special rules as the Commissioner of Public Infrastructure and/or City Engineer may deem necessary

Duarte M. Andrade MHS
Acting City Engineer[Signature]
Signature of Property Owner or Representative

INSPECTOR'S REPORT

INSPECTED BY: Kevin J. Corbett
DATE: 4-29-05
COMMENTS:

APPROVED DIS

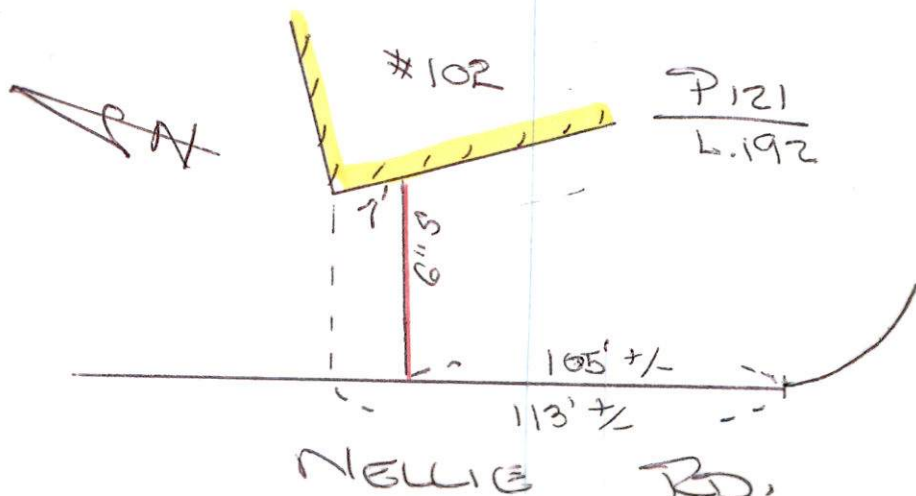Kevin J Corbett
SIGNATURE



PERMIT NO.

23666

CITY OF NEW BEDFORD
SEWER AND/OR STORM DRAIN PERMIT

DATE 3/22/05
EXP. 3/22/06

This certifies that permission is granted to

Walden Land Co. 15 Hamilton St. New Bedford Ma (508) 993-1776
Property Owner Address Tel.

To connect a sewer and/or storm drain located at Nellie Rd. #102

Assessor's Plot 121 Lot 192, to the sewer and/or storm drain in Nellie Rd. Street

To be laid in accordance with the conditions in this application and the City of New Bedford ordinances.

TYPE OF USE: RESIDENTIAL COMMERCIAL INDUSTRIAL OTHER 330 GPD

If applicant other than actual property owner, attach Letter of Authorization from Property Owner.

Name Richard Bailey Tel. (508) 990-8726

Mailing Address 568 Antlers Lane

The Bonded Contractor/Drain Layer authorized to perform this work is:

Reis Asphalt (508) 996-0735
Name Address Tel.

Type of Pipe Required: PVC SDR-35

PERMIT EXPIRES ONE YEAR AFTER DATE OF ISSUE

- Requires separate connections for sewage and storm drain where applicable. Storm water cannot be discharged to a sanitary sewer.
- All work must be inspected and approved by a D.P.I. inspector before backfilling.
- If this connection is to be part of a private service shared jointly with other building owners, attach copy of Recorded Joint Maintenance Agreement.
- Permits can be issued to Industrial and/or Commercial Applicants only upon receipt and approval by the Commissioner of Public Infrastructure of required plans and supplemental information.
- In addition, a City-issued Industrial User Discharge Permit and/or a Sewer Extension/Connection Permit issued by the Commonwealth of Massachusetts D.E.P. shall be required by the City for Industrial Discharge into the sewer system.

Industrial User Discharge Permit No. Date

Comm. Mass. Sewer Conn./Ext. Permit No. Date

A Filing and Inspection Fee of \$150.00 plus an Entrance Fee of \$ where applicable, must accompany this application.

Bank# First Fed. Check# 2476 Date 3/22/05 Receipt# 5127

Other requirements: Insp Only - connect to 8" Sewer & 6" Storm Drain
24 hrs notice for all inspections

Connection made to Sewer Part of jointly-shared private line YES NO
Storm Drain

Applicant agrees to abide by the above terms, as well as all pertinent ordinances of the City of New Bedford, and such other special rules as the Commissioner of Public Infrastructure and/or City Engineer may deem necessary.

Quarte M. Andrade MHS
Acting City Engineer


Signature of Property Owner or Representative

INSPECTOR'S REPORT

INSPECTED BY: _____
DATE: _____
COMMENTS: _____

APPROVED DISAPPROVED

SIGNATURE

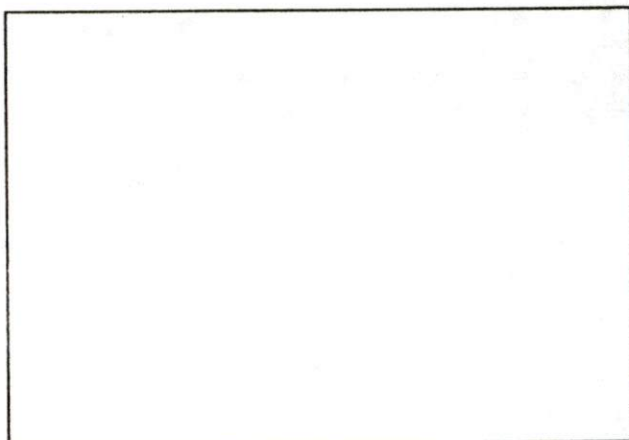

SKETCH PLAN



**CITY OF NEW BEDFORD
MASSACHUSETTS**

Engineering Department, Rm. 303

133 William Street

New Bedford, Ma. 02740

Tel: 508-979-1527

Fax: 508-961-3043

**Duarte M. Andrade,
Acting City Engineer**

To Whom It May Concern:

I MARTIN LIPMAN 15 HAMILTON ST NEW, being
(Name) (Mailing Address)

Owner of property located at NEWMORTON FARMS.

Plot 121, Lots in Zuckerman Farms, hereby agree to allow SEYMOUR BRIDLEY
(Name)

LIPMAN LANE NW to act on my behalf including affixing my
(Mailing Address)

signature in securing permit for:

☒ Sewer/Drain Service Permits
☐ Water Service Permits
☒ Driveway Installation Permits
☒ Sidewalk Installation Permits

I further agree to conform to, and abide by, All City rules and ask regulations applicable to the permit (s) being applied for:

Name Martin Lipman
Signature

15 HAMILTON ST NEW BEDFORD
Address

10/21/04 508 993-1776
Date Telephone number

