



PERMIT NO.
23684

CITY OF NEW BEDFORD
SEWER AND/OR STORM DRAIN PERMIT

DATE 5/4/05
EXP. 5/4/06

This certifies that permission is granted to

Property Owner KEVIN MEDEIROS Address 286 UNION ST. NEW BEDFORD, MA Tel. 508-991-4040

To connect a sewer and/or storm drain located at MEDEIROS CT. (OFF WEST SIDE OF ACUSHNET AVE)

Assessor's Plot 136 Lot MAINS, to the sewer and/or storm drain in ACUSHNET AVE Street

To be laid in accordance with the conditions in this application and the City of New Bedford ordinances.

TYPE OF USE: RESIDENTIAL COMMERCIAL INDUSTRIAL OTHER SEWER + STORM DRAINAGE MAINS

If applicant other than actual property owner, attach Letter of Authorization from Property Owner.

Name..... Tel.....

Mailing Address.....

The Bonded Contractor/Drain Layer authorized to perform this work is:

Name W.C. Smith Address 58 Ridgewood Rd. New Bedford, MA Tel. 508-995-1449

Type of Pipe Required: PVC SDR-35

PERMIT EXPIRES ONE YEAR AFTER DATE OF ISSUE

- Requires separate connections for sewage and storm drain where applicable. Storm water cannot be discharged to a sanitary sewer.
 - All work must be inspected and approved by a D.P.I. inspector before backfilling.
 - If this connection is to be part of a private service shared jointly with other building owners, attach copy of Recorded Joint Maintenance Agreement.
 - Permits can be issued to Industrial and/or Commercial Applicants only upon receipt and approval by the Commissioner of Public Infrastructure of required plans and supplemental information.
 - In addition, a City-issued Industrial User Discharge Permit and/or a Sewer Extension/Connection Permit issued by the Commonwealth of Massachusetts D.E.P. shall be required by the City for Industrial Discharge into the sewer system.
- Industrial User Discharge Permit No. Date.....

Comm. Mass. Sewer Conn./Ext. Permit No. Date.....
A Filing and Inspection Fee of \$150.00, plus an Entrance Fee of \$676.00 where applicable, must accompany this application.

Bank# Webster Bank Check# 1313 Date 5/4/05 Receipt# 5160

Other requirements: Insp Only to install 8" S+SD MAINS ONLY. Flowable Fill Required in Acushnet Ave. 24 hrs notice for all inspections.

Connection made to Sewer Part of jointly-shared private line YES NO
Storm Drain

Applicant agrees to abide by the above terms, as well as all pertinent ordinances of the City of New Bedford, and such other special rules as the Commissioner of Public Infrastructure and/or City Engineer may deem necessary

Duarte M. Andrade (ms)
Acting City Engineer


[Signature]
Signature of Property Owner or Representative

INSPECTOR'S REPORT

INSPECTED BY: _____
DATE: _____
COMMENTS: _____

APPROVED

SIGNATURE

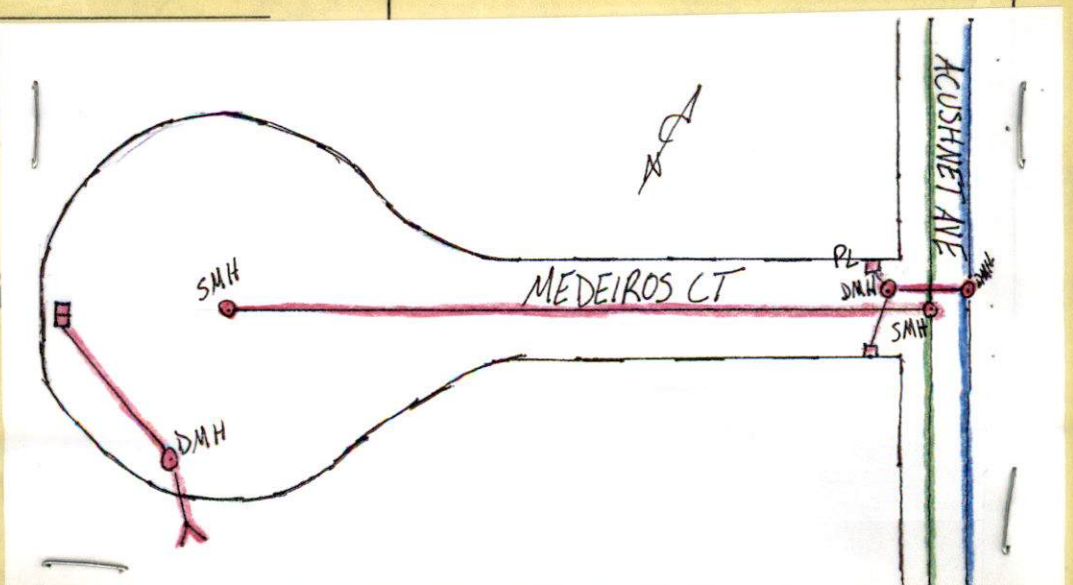



PERMIT NO.

23684

CITY OF NEW BEDFORD
SEWER AND/OR STORM DRAIN PERMIT

DATE 5/4/05
EXP. 5/4/06

This certifies that permission is granted to

KEVIN MEDEIROS 286 UNION ST. NEW BEDFORD, MA 508-991-4040
Property Owner Address Tel.

To connect a sewer and/or storm drain located at MEDEIROS CT (OFF WEST SIDE OF ACUSHNET AVE
930' Sx BRALEY RD

Assessor's Plot 136 Lot MAINS, to the sewer and/or storm drain in ACUSHNET AVE. Street

To be laid in accordance with the conditions in this application and the City of New Bedford ordinances.

TYPE OF USE: RESIDENTIAL COMMERCIAL INDUSTRIAL OTHER SEWER + STORM DRAINAGE MAINS

If applicant other than actual property owner, attach Letter of Authorization from Property Owner.

Name Tel.

Mailing Address

The Bonded Contractor/Drain Layer authorized to perform this work is:

W.C. Smith 58 Ridgewood Rd. New Bedford, MA 508-995-1449

Name Address Tel.

Type of Pipe Required: PVC SDR-35

PERMIT EXPIRES ONE YEAR AFTER DATE OF ISSUE

- Requires separate connections for sewage and storm drain where applicable. Storm water cannot be discharged to a sanitary sewer.
- All work must be inspected and approved by a D.P.I. inspector before backfilling.
- If this connection is to be part of a private service shared jointly with other building owners, attach copy of Recorded Joint Maintenance Agreement.
- Permits can be issued to Industrial and/or Commercial Applicants only upon receipt and approval by the Commissioner of Public Infrastructure of required plans and supplemental information.
- In addition, a City-issued Industrial User Discharge Permit and/or a Sewer Extension/Connection Permit issued by the Commonwealth of Massachusetts D.E.P. shall be required by the City for Industrial Discharge into the sewer system.

Industrial User Discharge Permit No. Date

Comm. Mass. Sewer Conn./Ext. Permit No. Date

A Filing and Inspection Fee of \$150.00, plus an Entrance Fee of \$676.00 where applicable, must accompany this application.

Bank# Webster Bank Check# 1313 Date 5/4/05 Receipt# 5160

Other requirements: Insp. Only to install 8" S+SD MAINS Only. Flowable Fill Required in Acushnet Ave. 24 hrs. notice for all inspections

Connection made to Sewer Storm Drain Part of jointly-shared private line YES NO

Applicant agrees to abide by the above terms, as well as all pertinent ordinances of the City of New Bedford, and such other special rules as the Commissioner of Public Infrastructure and/or City Engineer may deem necessary

Diante M. Andrade ms Acting City Engineer

Signature of Property Owner or Representative

INSPECTOR'S REPORT

INSPECTED BY:

DATE:

COMMENTS:

APPROVED

DISAPPROVED

SIGNATURE

SKETCH PLAN

SKETCH PLAN

5/18/05 - SD MH + 8' OF 12" RCP -

5/20/05 - SD - 25' OF 12" RCP

5/23/05 - PUT NEW MH ON SEWER IN ACUSHNET AVE -
26' OF 8" PVC ON MEDEIROS CT

5/26/05 - PUT SEWER TO NEW MH + 3 STUBS - KEVIN C. WITH GUN