



PERMIT NO.

23735

CITY OF NEW BEDFORD
SEWER AND/OR STORM DRAIN PERMIT

DATE 8/25/05

This certifies that permission is granted to

Kathleen Carvalho 3922 Acushnet Ave New Bedford, MA 508-995-6348
Property Owner Address Tel.To connect a sewer and/or storm drain located at 3924 Acushnet Ave
Assessor's Plot 136 Lot 264, to the sewer and/or storm drain in future connection will go to stub
Acushnet Ave Street

To be laid in accordance with the conditions in this application and the City of New Bedford ordinances.

TYPE OF USE: RESIDENTIAL COMMERCIAL INDUSTRIAL OTHER

Future Connection
only
660 GPD

If applicant other than actual property owner, attach Letter of Authorization from Property Owner.

Name Tel.

Mailing Address

The Bonded Contractor/Drain Layer authorized to perform this work is:

Name Address Tel.

Type of Pipe Required: PVC SDR-35

PERMIT EXPIRES ONE YEAR AFTER DATE OF ISSUE

- Requires separate connections for sewage and storm drain where applicable. Storm water cannot be discharged to a sanitary sewer.
 - All work must be inspected and approved by a D.P.I. inspector before backfilling.
 - If this connection is to be part of a private service shared jointly with other building owners, attach copy of Recorded Joint Maintenance Agreement.
 - Permits can be issued to Industrial and/or Commercial Applicants only upon receipt and approval by the Commissioner of Public Infrastructure of required plans and supplemental information.
 - In addition, a City-issued Industrial User Discharge Permit and/or a Sewer Extension/Connection Permit issued by the Commonwealth of Massachusetts D.E.P. shall be required by the City for Industrial Discharge into the sewer system.
- Industrial User Discharge Permit No. Date

Comm. Mass. Sewer Conn./Ext. Permit No. Date

A Filing and Inspection Fee of \$150.00, plus an Entrance Fee of \$ where applicable, must accompany this application.

Bank# First Citizens Federal Check# 201 Date 8/25/05 Receipt# 5279

Other requirements: Insp Only - Lay 6" Sewer Line on private property which will in the future be utilized + connected to manhole on private property purpose is to install sewer piping under new asphalt driveway. Sewer pipe to be 10' away from water sewer main. Call 508-979-1527 for inspection.

Connection made to Part of jointly-shared private line YES NO
Storm Drain

Applicant agrees to abide by the above terms, as well as all pertinent ordinances of the City of New Bedford, and such other special rules as the Commissioner of Public Infrastructure and/or City Engineer may deem necessary


Dimitri M. Andrade MS
Acting City EngineerKathleen Carvalho
Signature of Property Owner or Representative

INSPECTOR'S REPORT

INSPECTED BY:
DATE:
COMMENTS:

APPROVED DISAPPROVED

SIGNATURE

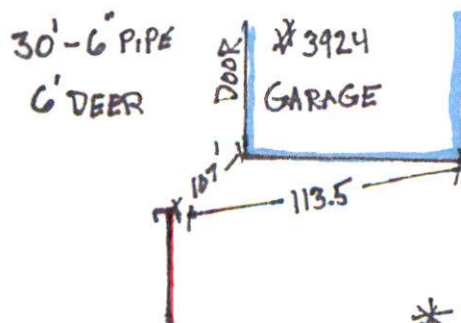

* TOTAL 121' - 6" PIPE

P. 136
L. 264



PERMIT NO.

23735

CITY OF NEW BEDFORD
SEWER AND/OR STORM DRAIN PERMIT

DATE 8/25/05

This certifies that permission is granted to

Kathleen Carvalho 3922 Acushnet Ave New Bedford, MA 508-995-6348
Property Owner Address Tel.To connect a sewer and/or storm drain located at 3924 Acushnet Ave.
Assessor's Plot 136 Lot 264, to the sewer and/or storm drain in future connection will go to stub in Acushnet Ave. Street

To be laid in accordance with the conditions in this application and the City of New Bedford ordinances.

TYPE OF USE: RESIDENTIAL COMMERCIAL INDUSTRIAL OTHER

Future Connection
only
660 GPD

If applicant other than actual property owner, attach Letter of Authorization from Property Owner.

Name Tel.

Mailing Address

The Bonded Contractor/Drain Layer authorized to perform this work is:

Name Address Tel.

Type of Pipe Required: PVC SDR-35

PERMIT EXPIRES ONE YEAR AFTER DATE OF ISSUE

- Requires separate connections for sewage and storm drain where applicable. Storm water cannot be discharged to a sanitary sewer.
 - All work must be inspected and approved by a D.P.I. inspector before backfilling.
 - If this connection is to be part of a private service shared jointly with other building owners, attach copy of Recorded Joint Maintenance Agreement.
 - Permits can be issued to Industrial and/or Commercial Applicants only upon receipt and approval by the Commissioner of Public Infrastructure of required plans and supplemental information.
 - In addition, a City-issued Industrial User Discharge Permit and/or a Sewer Extension/Connection Permit issued by the Commonwealth of Massachusetts D.E.P. shall be required by the City for Industrial Discharge into the sewer system.
- Industrial User Discharge Permit No. Date

Comm. Mass. Sewer Conn./Ext. Permit No. Date

A Filing and Inspection Fee of \$150.00, plus an Entrance Fee of \$ where applicable, must accompany this application.

Bank# First Citizens Federal Check# 201 Date 8/25/05 Receipt# 5279

Other requirements: Insp Only - Lay 6" Sewer Line on private property which will in the future be utilized + connected to Manhole on private property Purpose is to install sewer piping under new asphalt driveway. Sewer pipe to be 10' away from water sewer main Call 508-979-1527 for inspection.

Connection made to Part of jointly-shared private line YES NO
Storm Drain

Applicant agrees to abide by the above terms, as well as all pertinent ordinances of the City of New Bedford, and such other special rules as the Commissioner of Public Infrastructure and/or City Engineer may deem necessary

Duarte M. Andrade ms
Acting City EngineerKathleen Carvalho
Signature of Property Owner or Representative

INSPECTOR'S REPORT

INSPECTED BY:

DATE:

COMMENTS:

APPROVED

DISAPPROVED

SIGNATURE

SKETCH PLAN

Michele Avila-Silva

From: Sarah Porter
Sent: Thursday, September 01, 2005 1:58 PM
To: Donna Perry-ENG; Michele Avila-Silva
Cc: Scott Alfonse
Subject: sewer permits

the following permits/locations have been reviewed and found not to require wetland permitting

permit 23740 Map 29, Lot 174

permit 23739 Map 29, Lot 17

permit 23735 Map 136, Lot 264

permit 23741 Map 130A, Lot 410

& 116 Lawrence Street

Sarah

Do you need any paperwork returned to your office for your files?

PERMIT NO.

23735

CITY OF NEW BEDFORD
SEWER AND/OR STORM DRAIN PERMIT

DATE 8/25/05

This certifies that permission is granted to

Kathleen Carvalho 3922 Acushnet Ave. New Bedford, MA 508-995-6348
 Property Owner Address Tel.

To connect a sewer and/or storm drain located at 3922 Acushnet Ave.
 Assessor's Plot 13.6 Lot 249, to the sewer and/or storm drain in the Acushnet Ave. Street
 future connection will go to stub

To be laid in accordance with the conditions in this application and the City of New Bedford ordinances.
 TYPE OF USE: RESIDENTIAL COMMERCIAL INDUSTRIAL OTHER

Future Connection
 only
 660 GPD

If applicant other than actual property owner, attach Letter of Authorization from Property Owner.

Name..... Tel.....

Mailing Address.....

The Bonded Contractor/Drain Layer authorized to perform this work is:

Name..... Address..... Tel.....

Type of Pipe Required: PVC SDR-35

PERMIT EXPIRES ONE YEAR AFTER DATE OF ISSUE

- Requires separate connections for sewage and storm drain where applicable. Storm water cannot be discharged to a sanitary sewer.
- All work must be inspected and approved by a D.P.I. inspector before backfilling.
- If this connection is to be part of a private service shared jointly with other building owners, attach copy of Recorded Joint Maintenance Agreement.
- Permits can be issued to Industrial and/or Commercial Applicants only upon receipt and approval by the Commissioner of Public Infrastructure of required plans and supplemental information.
- In addition, a City-issued Industrial User Discharge Permit and/or a Sewer Extension/Connection Permit issued by the Commonwealth of Massachusetts D.E.P. shall be required by the City for Industrial Discharge into the sewer system.

Industrial User Discharge Permit No. Date.....

Comm. Mass. Sewer Conn./Ext. Permit No. Date.....

A Filing and Inspection Fee of \$150.00, plus an Entrance Fee of \$..... where applicable, must accompany this application.

Bank# First Citizens Federal Check# 201 Date 8/25/05 Receipt# 5279

Other requirements: Inst Only - Lay 6" Sewer Line on private property which will in the future be utilized + connected to Manhole on private property Purpose is to install sewer piping under new asphalt driveway. Sewer pipe to be 10' away from under sewer main. Call 508-977-1527 for inspection.
 Connection made to Storm Drain Part of jointly-shared private line YES NO

Applicant agrees to abide by the above terms, as well as all pertinent ordinances of the City of New Bedford, and such other special rules as the Commissioner of Public Infrastructure and/or City Engineer may deem necessary

Duarte M. Andrade (ms)
 Acting City Engineer

Kathleen Carvalho
 Signature of Property Owner or Representative

INSPECTOR'S REPORT

INSPECTED BY: _____
 DATE: _____
 COMMENTS: _____

APPROVED

DISAPPROVED

SIGNATURE

Inspection of
dry line sewer
10/18/05 - Tues
9:00 AM.
Norman Carvalho
508-977-7450

SKETCH PLAN