



PERMIT NO.

23762

CITY OF NEW BEDFORD
SEWER AND/OR STORM DRAIN PERMIT

DATE 10/25/05

This certifies that permission is granted to

Stephen Souza 915 Hathaway Rd. NB. 508 999 5069
Property Owner Address Tel.

To connect a sewer and/or storm drain located at Acushnet Ave. north of Parkwood Hospital

Assessor's Plot 137 Lot 283, to the sewer and/or storm drain in Acushnet Ave Street

To be laid in accordance with the conditions in this application and the City of New Bedford ordinances.

TYPE OF USE: ☒ RESIDENTIAL ☐ COMMERCIAL ☐ INDUSTRIAL ☐ OTHER

330 gpd.

If applicant other than actual property owner, attach Letter of Authorization from Property Owner.

Name..... Tel.....

Mailing Address.....

The Bonded Contractor/Drain Layer authorized to perform this work is:

Menard Bros. 307 County Rd. Wareham MA 508-995-4022

Name Address Tel.

Type of Pipe Required: SDR 35 PVC

PERMIT EXPIRES ONE YEAR AFTER DATE OF ISSUE

- Requires separate connections for sewage and storm drain where applicable. Storm water cannot be discharged to a sanitary sewer.
- All work must be inspected and approved by a D.P.I. inspector before backfilling.
- If this connection is to be part of a private service shared jointly with other building owners, attach copy of Recorded Joint Maintenance Agreement.
- Permits can be issued to Industrial and/or Commercial Applicants only upon receipt and approval by the Commissioner of Public Infrastructure of required plans and supplemental information.
- In addition, a City-issued Industrial User Discharge Permit and/or a Sewer Extension/Connection Permit issued by the Commonwealth of Massachusetts D.E.P. shall be required by the City for Industrial Discharge into the sewer system.

Industrial User Discharge Permit No..... Date.....

Comm. Mass. Sewer Conn./Ext. Permit No..... Date.....

A Filing and Inspection Fee of \$150.00, plus an Entrance Fee of \$..... where applicable, must accompany this application.

Bank# Acushnet Fed. C.U. Check# 552 Date 10/25/05 Receipt# 5535

Other requirements: Construct drainage according to attached plans

11" force main, relocate catch basin, install mh over

Connection made to ☒ Sewer ☐ Storm Drain Part of jointly-shared private line YES ☒ NO 2 clean outs

Applicant agrees to abide by the above terms, as well as all pertinent ordinances of the City of New Bedford, and such other special rules as the Commissioner of Public Infrastructure and/or City Engineer may deem necessary

Duarte M. Andrade Acting City Engineer Signature of Property Owner or Representative

INSPECTOR'S REPORT

INSPECTED BY: Kevin Cornell

DATE: 2-7-06

COMMENTS:

APPROVED ☒

DISAPPROVED

Kevin J. Cornell
SIGNATURErevised 11/17/05
no storm drain
connection neededSEE PLAN ATTACHED TO PERMIT,
STUB WAS formerly used by
4557 Acushnet Ave. (This
house was Raised + moved back)P. 137
L. 283



PERMIT NO.
23762

CITY OF NEW BEDFORD
SEWER AND/OR STORM DRAIN PERMIT

DATE 10/25/05

This certifies that permission is granted to

Stephen Souza 915 Hathaway Rd. N.B. 508.999.5069
Property Owner Address Tel.

To connect a sewer and/or storm drain located at Acushnet Ave. north of Parkwood Hospital

Assessor's Plot 137 Lot 283, to the sewer and/or storm drain in Acushnet Ave. Street

To be laid in accordance with the conditions in this application and the City of New Bedford ordinances.

TYPE OF USE: ☒ RESIDENTIAL ☐ COMMERCIAL ☐ INDUSTRIAL ☐ OTHER 330 gpd

If applicant other than actual property owner, attach Letter of Authorization from Property Owner.

Name..... Tel.....

Mailing Address.....

The Bonded Contractor/Drain Layer authorized to perform this work is:

McNard Bros. 307 County Rd. Wareham MA. 508-995-4022
Name Address Tel.

Type of Pipe Required: S.D.R. 35 PVC

PERMIT EXPIRES ONE YEAR AFTER DATE OF ISSUE

- Requires separate connections for sewage and storm drain where applicable. Storm water cannot be discharged to a sanitary sewer.
- All work must be inspected and approved by a D.P.I. inspector before backfilling.
- If this connection is to be part of a private service shared jointly with other building owners, attach copy of Recorded Joint Maintenance Agreement.
- Permits can be issued to Industrial and/or Commercial Applicants only upon receipt and approval by the Commissioner of Public Infrastructure of required plans and supplemental information.
- In addition, a City-issued Industrial User Discharge Permit and/or a Sewer Extension/Connection Permit issued by the Commonwealth of Massachusetts D.E.P. shall be required by the City for Industrial Discharge into the sewer system.

Industrial User Discharge Permit No. Date

Comm. Mass. Sewer Conn./Ext. Permit No. Date

A Filing and Inspection Fee of \$150., plus an Entrance Fee of \$..... where applicable, must accompany this application.

Bank# Acushnet Fed. C.U. Check# 552 Date 10/25/05 Receipt# 5535

Other requirements: Construct drainage according to attached plans,

flexible 11" force main, relocate catch basin, install m.b. over
existing service

Connection made to Sewer Part of jointly-shared private line YES ☒ NO 2 clean outs
Storm Drain

Applicant agrees to abide by the above terms, as well as all pertinent ordinances of the City of New Bedford, and such other special rules as the Commissioner of Public Infrastructure and/or City Engineer may deem necessary

Duarte M. Andrade
Acting City Engineer mn

[Signature]
Signature of Property Owner or Representative

INSPECTOR'S REPORT

INSPECTED BY: _____
DATE: _____
COMMENTS: _____

APPROVED _____ DISAPPROVED _____

SIGNATURE

revised 11/17/05
no storm drain
connection needed

SKETCH PLAN

ELAINE AVE

ACUSHNET AVE

SEWER MAIN
SURFACE DRAIN

NEW SMH
CURB STOP

SMF

SCALE: 1"=40'


DIRT ACCESS ROAD

CLEAN OUT

SMF


PUMP STATION

#4557
PERMIT # 23762

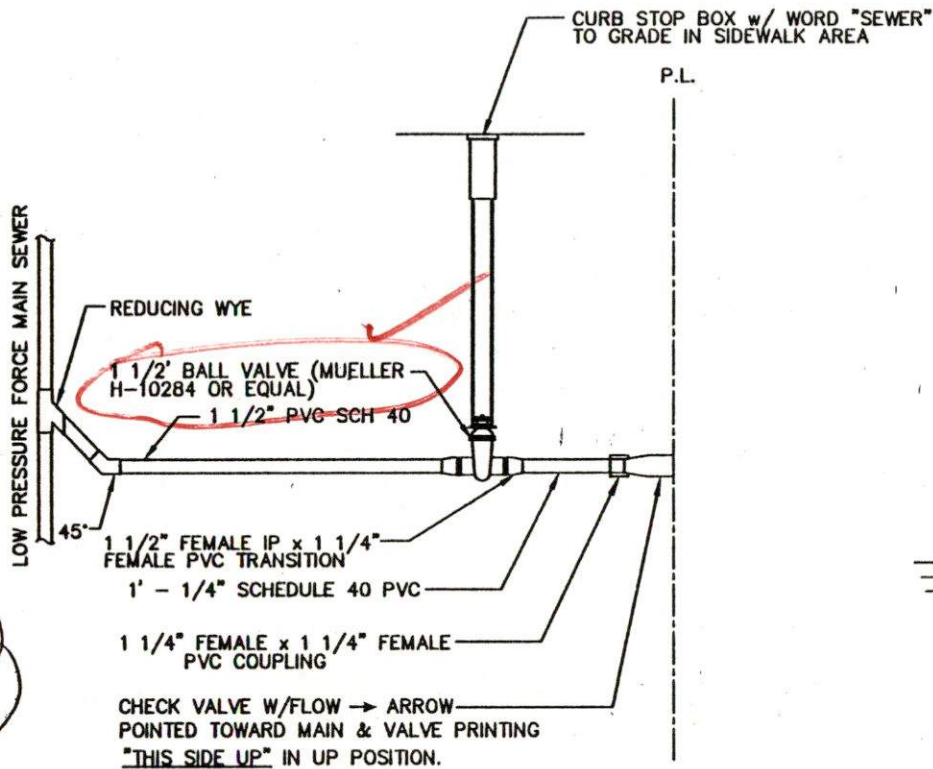

LOW PRESURE SEWER CURB STOP


NOT TO SCALE

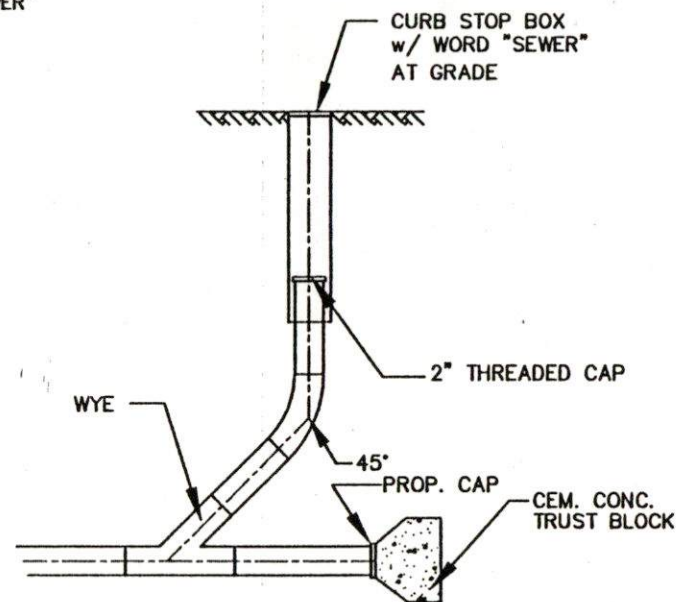

NOTE
ALL 4" SCHEDULE 40 PVC PIPE

SEWER CLEAN OUT

NOT TO SCALE

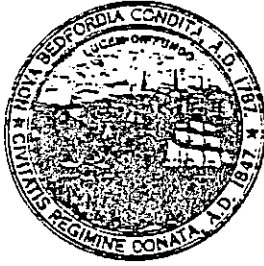

Duarte M. Andrade,
Acting City Engineer

CITY OF NEW BEDFORD MASSACHUSETTS

Engineering Department, Rm. 303

133 William Street

New Bedford, Ma. 02740

Tel: 508-979-1527

Fax: 508-961-3043

Stella

Sidewalk permit

INS.

To Whom It May Concern:

I TONY VIEIRA 4557 ACUSHNET AVE, being
(Name) (Mailing Address)

Owner of property located at 4557 ACUSHNET AVE

Plot 137, Lot 28+29, hereby agree to allow DAN MENARD (ASPHALT)
(Name)

307 WORTH RD W. VARESIAN, to act on my behalf including affixing my
(Mailing Address)

signature in securing permit for:

☒ Sewer/Drain Service Permits
☒ Water Service Permits
☐ Driveway Installation Permits
☐ Sidewalk Installation Permits

I further agree to conform to, and abide by, All City rules and ask regulations applicable to the permit (s) being applied for:

Name

Tony Vieira
Signature

SAVIE

Address

Date

10/25/05

Telephone number

508 9985957