



PERMIT NO.

23777

CITY OF NEW BEDFORD
SEWER AND/OR STORM DRAIN PERMIT

DATE 12-8-05

This certifies that permission is granted to

PATRICK DONNELLY 58^R ACUSHNET AVE 508-990-1990
Property Owner Address Tel.To connect a sewer and/or storm drain located at 58^R ACUSHNET AVE

Assessor's Plot 31 Lot 110/192, to the sewer and/or storm drain in 15" sewer in Acushnet Ave Street

To be laid in accordance with the conditions in this application and the City of New Bedford ordinances.

TYPE OF USE: RESIDENTIAL COMMERCIAL INDUSTRIAL OTHER

If applicant other than actual property owner, attach Letter of Authorization from Property Owner.

Name BAY STATE PIPING CO. INC. (WREG SCOT) Tel. 508-923-6022

Mailing Address 467 WAREHAM ST.

The Bonded Contractor/Drain Layer authorized to perform this work is:

BAY STATE PIPING CO. INC. 467 WAREHAM ST. MIDDLEBORO 508-923-6022

Name Address Tel.

Type of Pipe Required: SDR 35 PVC

PERMIT EXPIRES ONE YEAR AFTER DATE OF ISSUE

- Requires separate connections for sewage and storm drain where applicable. Storm water cannot be discharged to a sanitary sewer.
- All work must be inspected and approved by a D.P.I. inspector before backfilling.
- If this connection is to be part of a private service shared jointly with other building owners, attach copy of Recorded Joint Maintenance Agreement.
- Permits can be issued to Industrial and/or Commercial Applicants only upon receipt and approval by the Commissioner of Public Infrastructure of required plans and supplemental information.
- In addition, a City-issued Industrial User Discharge Permit and/or a Sewer Extension/Connection Permit issued by the Commonwealth of Massachusetts D.E.P. shall be required by the City for Industrial Discharge into the sewer system.

Industrial User Discharge Permit No. Date

Comm. Mass. Sewer Conn./Ext. Permit No. Date

A Filing and Inspection Fee of \$50.00 plus an Entrance Fee of \$ where applicable, must accompany this application.

Bank# Bank North Check# 43989 Date 12/8/05 Receipt# 5635

Other requirements: flowable fill, 24 hr. inspection notice

at 508-991-6151 sewer repair in street

Connection made to Sewer Part of jointly-shared private line YES NO
Storm Drain

Applicant agrees to abide by the above terms, as well as all pertinent ordinances of the City of New Bedford, and such other special rules as the Commissioner of Public Infrastructure and/or City Engineer may deem necessary

Dante M. Amodeo / mn Acting City Engineer Signature of Property Owner or Representative


INSPECTOR'S REPORT

INSPECTED BY: Kevin J. Connel

DATE: 12-14-05

COMMENTS:

APPROVED DISAP

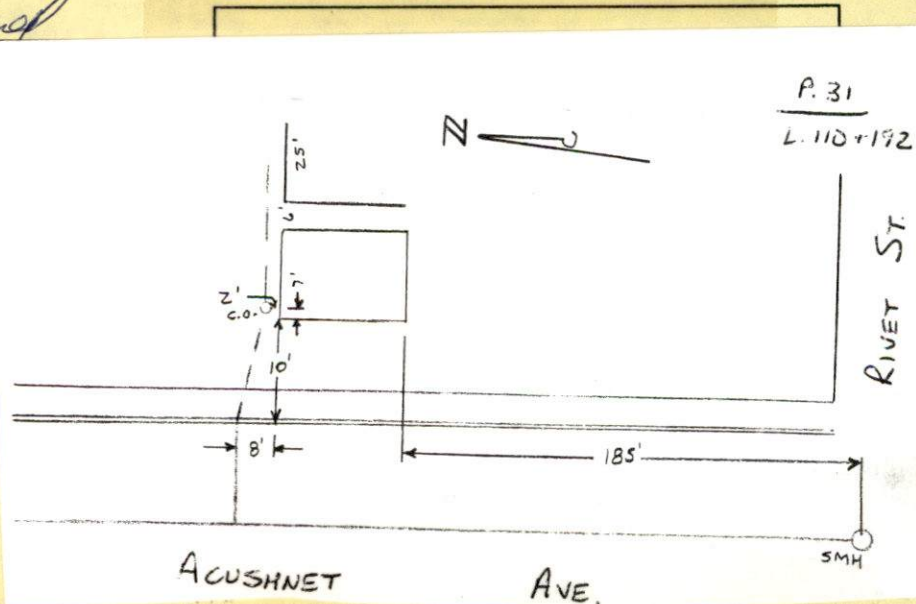Kevin J. Connel
SIGNATURE


2-14-06 Sunny 40°

#58 ACQUAINT AVE - SEWET REPAIR ONLY

Result # 23777

CONTRACTOR-BAY STATE PIPE
508-723-6022

NOTE: DID NOT DO INSPECTION
TODAY. SKETCHED HORSES &
UTILITIES ONLY. INSPECTION
DONE IN LATE 2005

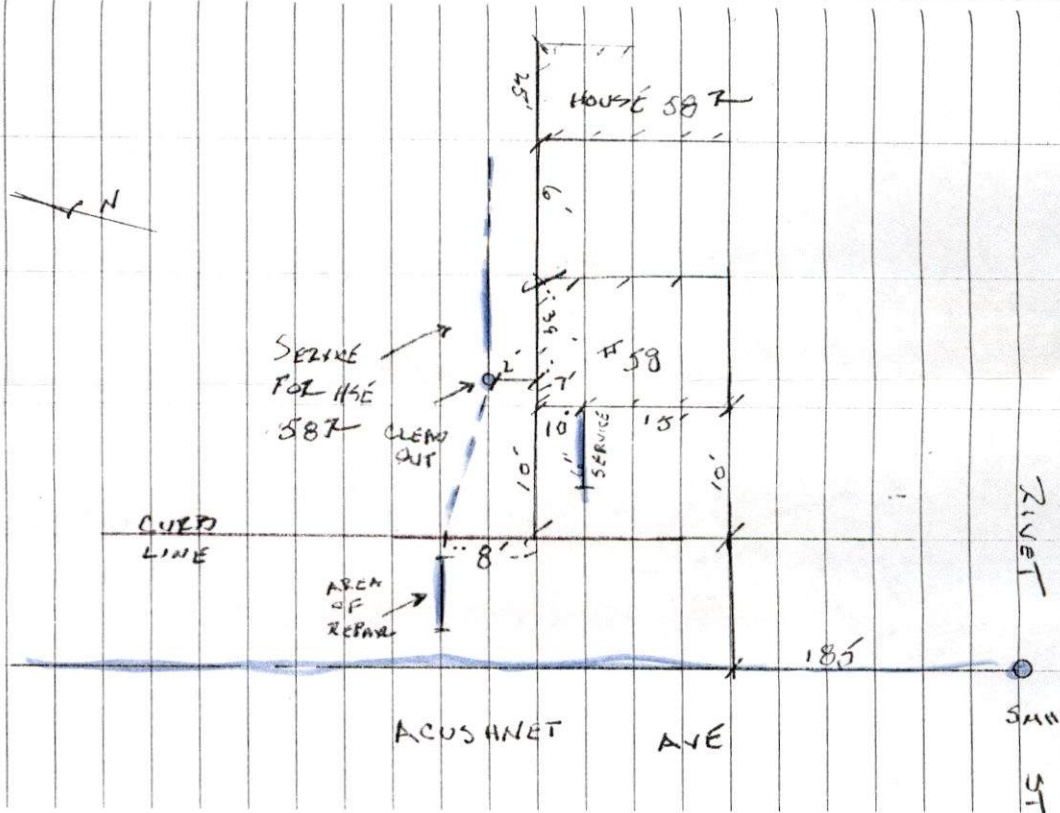



PERMIT NO.

23777

CITY OF NEW BEDFORD
SEWER AND/OR STORM DRAIN PERMIT

DATE 12-8-05

This certifies that permission is granted to

PATRICK DONNELLY 58^R ACUSHNET AVE. 508-990-1990
Property Owner Address Tel.To connect a sewer and/or storm drain located at 58^R ACUSHNET AVE.

Assessor's Plot 31 Lot 110/192, to the sewer and/or storm drain in 15" sewer in Acushnet Ave Street

To be laid in accordance with the conditions in this application and the City of New Bedford ordinances.

TYPE OF USE: RESIDENTIAL COMMERCIAL INDUSTRIAL OTHER

If applicant other than actual property owner, attach Letter of Authorization from Property Owner.

Name BAY STATE PIPING CO. INC. (WREG SCOT) Tel. 508-923-6022

Mailing Address 467 WAREHAM ST.

The Bonded Contractor/Drain Layer authorized to perform this work is:

BAY STATE PIPING CO., INC. 467 WAREHAM ST. MIDDLEBORO 508-923-6022

Name Address Tel.

Type of Pipe Required: SDR 35 PVC

PERMIT EXPIRES ONE YEAR AFTER DATE OF ISSUE

- Requires separate connections for sewage and storm drain where applicable. Storm water cannot be discharged to a sanitary sewer.
- All work must be inspected and approved by a D.P.I. inspector before backfilling.
- If this connection is to be part of a private service shared jointly with other building owners, attach copy of Recorded Joint Maintenance Agreement.
- Permits can be issued to Industrial and/or Commercial Applicants only upon receipt and approval by the Commissioner of Public Infrastructure of required plans and supplemental information.
- In addition, a City-issued Industrial User Discharge Permit and/or a Sewer Extension/Connection Permit issued by the Commonwealth of Massachusetts D.E.P. shall be required by the City for Industrial Discharge into the sewer system.

Industrial User Discharge Permit No. Date.

Comm. Mass. Sewer Conn./Ext. Permit No. Date.

A Filing and Inspection Fee of \$50.00 plus an Entrance Fee of \$ where applicable, must accompany this application.

Bank# Bank North Check# 43989 Date 12/8/05 Receipt# 5635

Other requirements: flowable fill, 24 hr. inspection notice

at 508-991-6151 sewer repair in street

Connection made to Sewer Part of jointly-shared private line YES NO
Storm Drain

Applicant agrees to abide by the above terms, as well as all pertinent ordinances of the City of New Bedford, and such other special rules as the Commissioner of Public Infrastructure and/or City Engineer may deem necessary

Duarte M. Andrade / mn
Acting City Engineer

Signature of Property Owner or Representative

INSPECTOR'S REPORT

INSPECTED BY: _____

DATE: _____

COMMENTS: _____

APPROVED

DISAPPROVED

SIGNATURE

SKETCH PLAN

ORIGINAL CHECK HAS A COLORED BACKGROUND PRINTED ON CHEMICAL REACTIVE PAPER - SEE BACK FOR DETAILS

BAY STATE PIPING COMPANY, INC.

467 WAREHAM STREET
MIDDLEBORO, MA 02346

BANKNORTH, NA

53-7054/2113

DATE	CHECK NUMBER
12/8/05	43989

PAY CITY OF NEW BEDFORD

TO THE
ORDER OF

ONE HUNDRED FIFTY AND 00/100 DOLLARS

\$ 150.00

Kaf

⑈043989⑈ ⑆211370545⑆010238501⑈

*Katelyn authorized
us to put today's
date.*

Pipeline Construction
Horizontal Drilling

Greg Scott
Project Manager

BAY STATE PIPING COMPANY, INC.

467 Wareham Street
Middleboro, MA 02346

(508) 923-6022 ext. 18
Fax: (508) 923-6023
Cell: (508) 922-6296



CITY OF NEW BEDFORD MASSACHUSETTS

D.P.I. -Engineering Division, Rm. 303

133 William Street

New Bedford, Ma. 02740

Ronald Labelle
Commissioner

Tel: 508-979-1527

Duarte M. Andrade,
Acting City Engineer

Fax: 508-961-3043

To Whom It May Concern:

I PATRICK DONNELLY 58R ACUSHNET AVE, being
(Name) (Mailing Address) 02740

Owner of property located at 58R ACUSHNET AVE NEW BEDFORD, MA

Plot 31, Lot 192, hereby agree to allow BAY STATE PIPING CO.
(Name)

467 WAREHAM ST MIDDLEBORO MA, to act on my behalf including affixing my
(Mailing Address)

signature in securing permit for:

☒ Sewer/Drain Service Permits
☐ Water Service Permits
☐ Driveway Installation Permits
☐ Sidewalk Installation Permits

I further agree to conform to, and abide by, All City rules and ask regulations applicable to the permit (s) being applied for:

Name

Signature

58R ACUSHNET AVE

Address

12-6-05

Date

508-990-1990

Telephone number