



PERMIT NO.
23780

CITY OF NEW BEDFORD
SEWER AND/OR STORM DRAIN PERMIT

DATE 12/20/05

This certifies that permission is granted to

John Costa 707 Hathaway Rd NB 508-965-9637
Property Owner Address Tel.

To connect a sewer and/or storm drain located at stub on Elmwood Road

Assessor's Plot 121 Lot 56, to the sewer and/or storm drain in Elmwood Road Street

To be laid in accordance with the conditions in this application and the City of New Bedford ordinances.

TYPE OF USE: RESIDENTIAL COMMERCIAL INDUSTRIAL OTHER 440 gpd

If applicant other than actual property owner, attach Letter of Authorization from Property Owner.

Name..... Tel.....
Mailing Address.....

The Bonded Contractor/Drain Layer authorized to perform this work is:

W. C. Smith + Sons 58 Ridgewood Rd NB 508-995-1449
Name Address Tel.
Type of Pipe Required: SDR PVC 35

PERMIT EXPIRES ONE YEAR AFTER DATE OF ISSUE

- Requires separate connections for sewage and storm drain where applicable. Storm water cannot be discharged to a sanitary sewer.
 - All work must be inspected and approved by a D.P.I. inspector before backfilling.
 - If this connection is to be part of a private service shared jointly with other building owners, attach copy of Recorded Joint Maintenance Agreement.
 - Permits can be issued to Industrial and/or Commercial Applicants only upon receipt and approval by the Commissioner of Public Infrastructure of required plans and supplemental information.
 - In addition, a City-issued Industrial User Discharge Permit and/or a Sewer Extension/Connection Permit issued by the Commonwealth of Massachusetts D.E.P. shall be required by the City for Industrial Discharge into the sewer system.
- Industrial User Discharge Permit No..... Date.....

Comm. Mass. Sewer Conn./Ext. Permit No..... Date.....
A Filing and Inspection Fee of \$1,500.00 plus an Entrance Fee of \$550.00 where applicable, must accompany this application.

Bank# Bank of America Check# 199 Date 12/20/05 Receipt# 5639

Other requirements: 24 hr. inspection notice at 508-991-6151

Connection made to Sewer Storm Drain Part of jointly-shared private line YES NO

Applicant agrees to abide by the above terms, as well as all pertinent ordinances of the City of New Bedford, and such other special rules as the Commissioner of Public Infrastructure and/or City Engineer may deem necessary

Quante M. Andrade Acting City Engineer


John Costa Signature of Property Owner or Representative


INSPECTOR'S REPORT

INSPECTED BY: KEVIN CORNELL
DATE: 1-04-06
COMMENTS:

APPROVED DISAPPROVED

Kevin J Cornell SIGNATURE

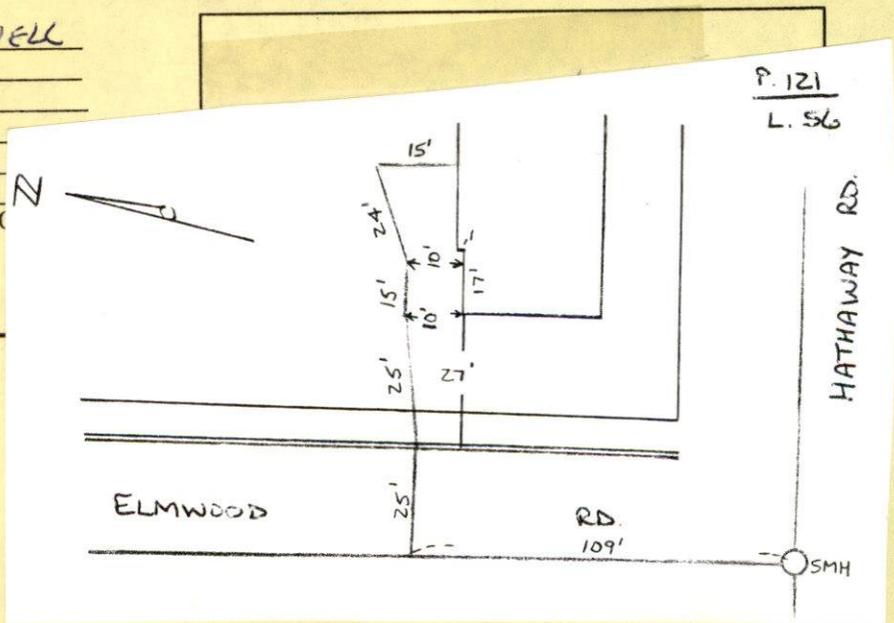

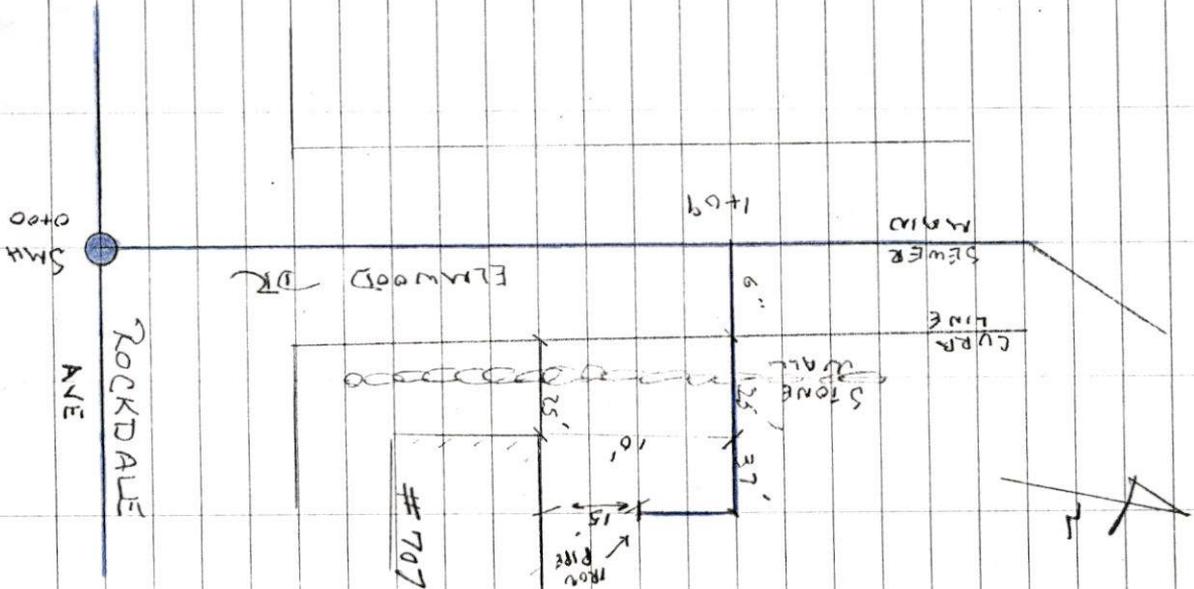

SMH
0400

ROCKDALE
AVE

ELMWOOD DR

1409

SEWER
MAIN

6"
SEWER
LINE

STONE
WALL


25'

10'

37'

MAN
HOLE

#707

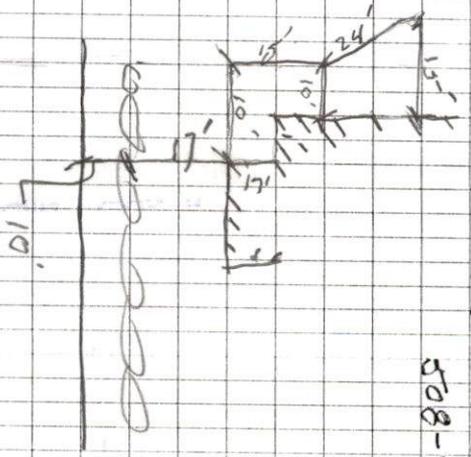

CONTRACTOR - W.C. SMITH
508-995-1449

PERMIT # 23780

#707 HATHAWAY ROAD - SEWER
INSPECTION

1-04-06 WEDNESDAY
CLOUDY 30°



PERMIT NO.
23780

CITY OF NEW BEDFORD
SEWER AND/OR STORM DRAIN PERMIT

DATE 12/20/05

This certifies that permission is granted to

John Costa.....707 Hathaway Rd.....N.B......508-965-9637
Property Owner Address Tel.

To connect a sewer and/or storm drain located at stub on Elmwood Road

Assessor's Plot 121.....Lot 56....., to the sewer and/or storm drain in Elmwood Road.....Street

To be laid in accordance with the conditions in this application and the City of New Bedford ordinances.

TYPE OF USE: RESIDENTIAL COMMERCIAL INDUSTRIAL OTHER 440 gpd

If applicant other than actual property owner, attach Letter of Authorization from Property Owner.

Name.....Tel.....
Mailing Address.....

The Bonded Contractor/Drain Layer authorized to perform this work is:

W. C. Smith + Sons.....58 Ridgewood Rd.....N.B......508-995-1449
Name Address Tel.

Type of Pipe Required:.....SDR PVC 35.....

PERMIT EXPIRES ONE YEAR AFTER DATE OF ISSUE

- Requires separate connections for sewage and storm drain where applicable. Storm water cannot be discharged to a sanitary sewer.
 - All work must be inspected and approved by a D.P.I. inspector before backfilling.
 - If this connection is to be part of a private service shared jointly with other building owners, attach copy of Recorded Joint Maintenance Agreement.
 - Permits can be issued to Industrial and/or Commercial Applicants only upon receipt and approval by the Commissioner of Public Infrastructure of required plans and supplemental information.
 - In addition, a City-issued Industrial User Discharge Permit and/or a Sewer Extension/Connection Permit issued by the Commonwealth of Massachusetts D.E.P. shall be required by the City for Industrial Discharge into the sewer system.
- Industrial User Discharge Permit No.....Date.....

Comm. Mass. Sewer Conn./Ext. Permit No.....Date.....
A Filing and Inspection Fee of \$1,500.00 plus an Entrance Fee of \$550.00 where applicable, must accompany this application.

Bank# Bank of America Check# 199 Date 12/20/05 Receipt# 5639

Other requirements: 24 hr. inspection notice at 508-991-6151

Connection made to Sewer Part of jointly-shared private line YES NO
Storm Drain

Applicant agrees to abide by the above terms, as well as all pertinent ordinances of the City of New Bedford, and such other special rules as the Commissioner of Public Infrastructure and/or City Engineer may deem necessary

Quante M. Andrus
Acting City Engineer mn


John Costa
Signature of Property Owner or Representative

INSPECTOR'S REPORT

INSPECTED BY: _____
DATE: _____
COMMENTS: _____

APPROVED _____ DISAPPROVED _____

SIGNATURE

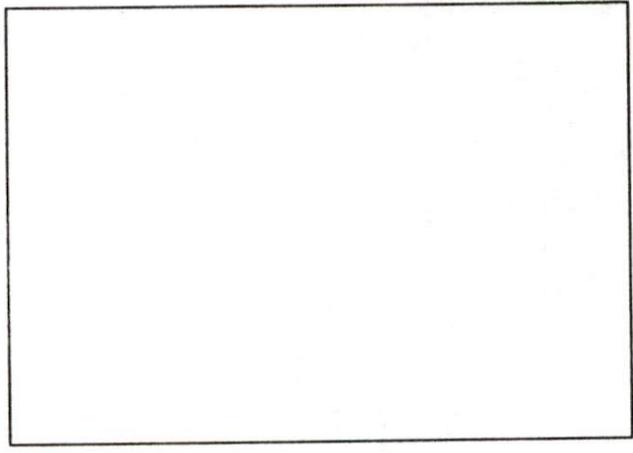

SKETCH PLAN

Mary T. Neves

From: Sarah Porter
Sent: Tuesday, December 27, 2005 10:36 AM
To: Mary T. Neves
Subject: RE: Connection to sewer

Mary
You are all set to issue this permit - no wetland issues

-----Original Message-----

From: Mary T. Neves
Sent: Thursday, December 22, 2005 9:32 AM
To: Sarah Porter
Subject: FW: Connection to sewer

Hi Sarah,

The property owner called me today asking the status of his permit. Have you had a chance to review it?
Thank you

Mary

-----Original Message-----

From: Mary T. Neves
Sent: Monday, December 19, 2005 9:45 AM
To: Sarah Porter
Subject: Connection to sewer

Hi Sarah,

The new property owner of 707 Hathaway Road (n.e.c. of Elmwood Road) wants to connect to the sewer system. The City installed a betterment sewer in this neighborhood in 2001 so a stub exists to the property line.

Their connection will be on the Elmwood Road side.

May I issue this permit?

Thank you for your assistance.
Mary