



PERMIT NO.
23847

CITY OF NEW BEDFORD
SEWER AND/OR STORM DRAIN PERMIT

DATE 6/19/06

This certifies that permission is granted to

Ralph Mulford, 158 Chas. McCombs Blvd, NB, MA
Property Owner Address Tel. 508 945 8355

To connect a sewer and/or storm drain located at 24 Mate Dr.

Assessor's Plot 132H Lot 269, to the sewer and/or storm drain in Mate Dr. Street

To be laid in accordance with the conditions in this application and the City of New Bedford ordinances.

TYPE OF USE: RESIDENTIAL COMMERCIAL INDUSTRIAL OTHER

330 gpd

If applicant other than actual property owner, attach Letter of Authorization from Property Owner.

Name..... Tel.....
Mailing Address.....

The Bonded Contractor/Drain Layer authorized to perform this work is:

D.W. White Cons., 867 Middle Rd, Acushnet, MA 508 763 8868
Name Address Tel.

Type of Pipe Required: SRR 3.5 PVC

PERMIT EXPIRES ONE YEAR AFTER DATE OF ISSUE

- Requires separate connections for sewage and storm drain where applicable. Storm water cannot be discharged to a sanitary sewer.
- All work must be inspected and approved by a D.P.I. inspector before backfilling.
- If this connection is to be part of a private service shared jointly with other building owners, attach copy of Recorded Joint Maintenance Agreement.
- Permits can be issued to Industrial and/or Commercial Applicants only upon receipt and approval by the Commissioner of Public Infrastructure of required plans and supplemental information.
- In addition, a City-issued Industrial User Discharge Permit and/or a Sewer Extension/Connection Permit issued by the Commonwealth of Massachusetts D.E.P. shall be required by the City for Industrial Discharge into the sewer system.

Comm. Mass. Sewer Conn./Ext. Permit No..... Date.....
A Filing and Inspection Fee of \$1,500.00, plus an Entrance Fee of \$..... where applicable, must accompany this application.

Bank# BCP Check# 13103 Date 6/19/06 Receipt# 6356

Other requirements: 24 hr inspection 508 979 1527

Connection made to Sewer Storm Drain Part of jointly-shared private line YES NO

Applicant agrees to abide by the above terms, as well as all pertinent ordinances of the City of New Bedford, and such other special rules as the Commissioner of Public Infrastructure and/or City Engineer may deem necessary


Duarte M. Andrade
Acting City Engineer

[Signature]
Signature of Property Owner or Representative

INSPECTOR'S REPORT

INSPECTED BY: SEE WHITE SHEET
DATE: DATE ONLY
COMMENTS:

APPROVED _____ DIS _____
SIGNATURE

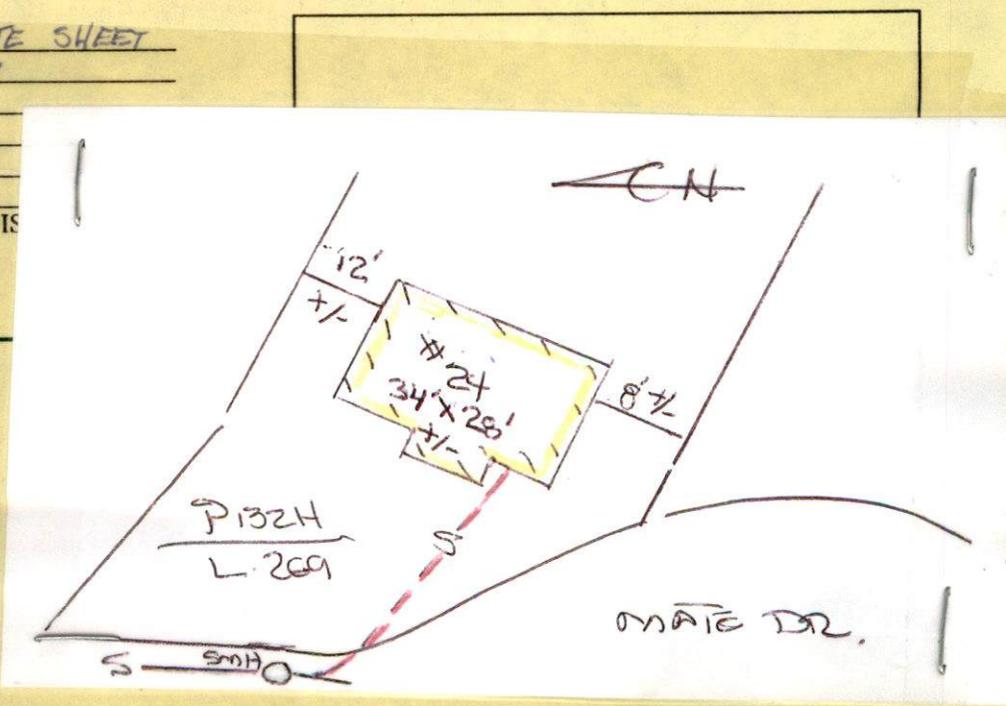



PERMIT NO.

- 23847

CITY OF NEW BEDFORD
SEWER AND/OR STORM DRAIN PERMIT

DATE 6/19/06

This certifies that permission is granted to

Ralph Mulford 158 Chas. McCombs Blvd NB MA
Property Owner Address Tel. 508 965 8355

To connect a sewer and/or storm drain located at 24 Mate Dr

Assessor's Plot 1306 Lot 269, to the sewer and/or storm drain in Mate Dr Street

To be laid in accordance with the conditions in this application and the City of New Bedford ordinances.

TYPE OF USE: RESIDENTIAL COMMERCIAL INDUSTRIAL OTHER

330 gpd

If applicant other than actual property owner, attach Letter of Authorization from Property Owner.

Name Tel.
Mailing Address

The Bonded Contractor/Drain Layer authorized to perform this work is:

D. W. White Cons. 867 Middle Rd Acushnet MA 508 763 8868

Name Address Tel.

Type of Pipe Required: S.R.R. 3.5 PVC

PERMIT EXPIRES ONE YEAR AFTER DATE OF ISSUE

- Requires separate connections for sewage and storm drain where applicable. Storm water cannot be discharged to a sanitary sewer.
- All work must be inspected and approved by a D.P.I. inspector before backfilling.
- If this connection is to be part of a private service shared jointly with other building owners, attach copy of Recorded Joint Maintenance Agreement.
- Permits can be issued to Industrial and/or Commercial Applicants only upon receipt and approval by the Commissioner of Public Infrastructure of required plans and supplemental information.
- In addition, a City-issued Industrial User Discharge Permit and/or a Sewer Extension/Connection Permit issued by the Commonwealth of Massachusetts D.E.P. shall be required by the City for Industrial Discharge into the sewer system.

Industrial User Discharge Permit No. Date

Comm. Mass. Sewer Conn./Ext. Permit No. Date

A Filing and Inspection Fee of \$1500.00, plus an Entrance Fee of \$..... where applicable, must accompany this application.

Bank# BCP Check# 13103 Date 6/19/06 Receipt# 6356

Other requirements: 24 hr inspection 508.979.1527

Connection made to Sewer Storm Drain Part of jointly-shared private line YES NO

Applicant agrees to abide by the above terms, as well as all pertinent ordinances of the City of New Bedford, and such other special rules as the Commissioner of Public Infrastructure and/or City Engineer may deem necessary

Dwaine M. Andrade Acting City Engineer

Ralph Mulford Signature of Property Owner or Representative

INSPECTOR'S REPORT


INSPECTED BY: _____

DATE: _____

COMMENTS: _____

APPROVED DISAPPROVED

SIGNATURE

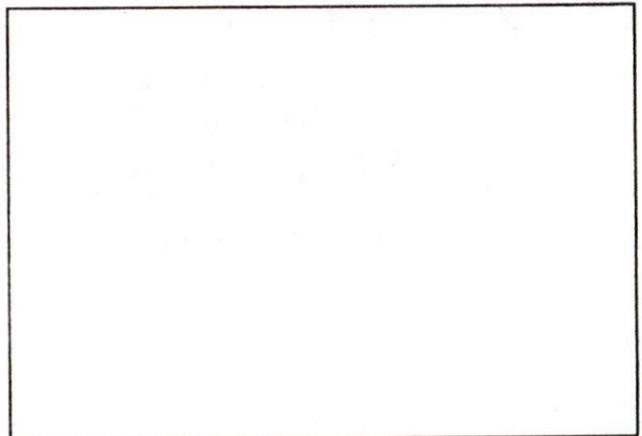

SKETCH PLAN

Inspector's Copy



PERMIT NO.
23847

CITY OF NEW BEDFORD
SEWER AND/OR STORM DRAIN PERMIT

DATE 6/19/06

This certifies that permission is granted to

Ralph Mulford 158 Chas. McCombs Blvd NB MA
Property Owner Address Tel. 508 965 8355

To connect a sewer and/or storm drain located at 24 Mate Dr

Assessor's Plot 132A Lot 269, to the sewer and/or storm drain in Mate Dr Street

To be laid in accordance with the conditions in this application and the City of New Bedford ordinances.

TYPE OF USE: J RESIDENTIAL COMMERCIAL INDUSTRIAL OTHER 3309 P

If applicant other than actual property owner, attach Letter of Authorization from Property Owner.

Name Mailing Address Tel

The Bonded Contractor/Drain Layer authorized to perform this work is:

D.W. White Cons 867 Middle Rd Acushnet MA 508 763 8868
Name Address Tel

Type of Pipe Required: S.R.R. 3.5 PVC

PERMIT EXPIRES ONE YEAR AFTER DATE OF ISSUE

- Requires separate connections for sewage and storm drain where applicable. Storm water cannot be discharged to a sanitary sewer.
- All work must be inspected and approved by a D.P.I. inspector before backfilling.
- If this connection is to be part of a private service shared jointly with other building owners, attach copy of Recorded Joint Maintenance Agreement.
- Permits can be issued to Industrial and/or Commercial Applicants only upon receipt and approval by the Commissioner of Public Infrastructure of required plans and supplemental information.
- In addition, a City-issued Industrial User Discharge Permit and/or a Sewer Extension/Connection Permit issued by the Commonwealth of Massachusetts D.E.P. shall be required by the City for Industrial Discharge into the sewer system.

Industrial User Discharge Permit No. Date
Comm. Mass. Sewer Conn./Ext. Permit No. Date
A Filing and Inspection Fee of \$1500.00 plus an Entrance Fee of \$... where applicable, must accompany this application.

Bank# BCP Check# 13103 Date 6/19/06 Receipt# 6356

Other requirements: 24 hr inspection 508 979 1527

Connection made to Sewer Storm Drain Part of jointly-shared private line YES NO

Applicant agrees to abide by the above terms, as well as all pertinent ordinances of the City of New Bedford, and such other special rules as the Commissioner of Public Infrastructure and/or City Engineer may deem necessary

Duarte M. Andrade
Acting City Engineer

Ralph Mulford
Signature of Property Owner or Representative

INSPECTOR'S REPORT

INSPECTED BY: _____
DATE: 8/8/07
COMMENTS: _____
APPROVED _____ DISAPPROVED _____

Inspection for 8/8/07 -
Friday @ 3:00 P.M
Wednesday

SIGNATURE

SKETCH PLAN

1088



23847

CITY OF NEW BEDFORD

NO. 108806

LICENSE NO. _____

DATE 6/15 2006

FOUNDATION PERMIT

MSBC Sect. 111.8 – Any permit issued shall be deemed abandoned and invalid unless the work authorized by it shall have been commenced within six (6) months after its issuance.

This certifies that Louy Built Homes, owner contractor
has permission to install foundation 36x28
on 24 Mate St. lot 269

providing that the person accepting this permit shall in every respect conform to the terms of the application therefor on file in this office; to the provisions of the Statute of the Commonwealth and to the By-Laws of the City of New Bedford relating to the Inspection, Erection, Enlarging, Altering, Raising, Moving, Repairing or Tearing Down of a Building.

WIRING INSPECTOR

PLUMBING INSPECTOR

BUILDING INSPECTOR

ROUGH FINISH

YOUR AREA INSPECTOR IS: _____

- Tel. 979-1540 Between 8:00 AM – 9:00 AM

NOTICE: NOTIFY INSPECTOR 48 HOURS
IN ADVANCE OF APPLYING
SHEATING OR LATHING

OCCUPANCY PERMIT REQUIRED BEFORE OCCUPANCY
No Building or Structure shall be used or occupied until the Certificate of Use and Occupancy shall have been issued by the Building Commissioner – MSBC. Sect. 120.1 – N.B. Zoning Ord. Sect. 9-269

THIS CARD MUST BE DISPLAYED IN A CONSPICUOUS PLACE ON THE PREMISES
AND NOT TORN DOWN OR REMOVED UNTIL COMPLETION OF WORK

SUBJECT TO MASSACHUSETTS STATE
BUILDING CODE REQUIREMENTS

[Signature]
BUILDING INSPECTOR