



PERMIT NO.  
23852

CITY OF NEW BEDFORD  
SEWER AND/OR STORM DRAIN PERMIT

DATE 6/28/06

This certifies that permission is granted to

N.B. Jewish Convalescent Home 414 County St. NB MA 508-997-9314  
Property Owner Address Tel.

To connect a sewer and/or storm drain located at 200 Hawthorn St.

Assessor's Plot 40 Lot 1, to the sewer and/or storm drain in Hawthorn St. Street

To be laid in accordance with the conditions in this application and the City of New Bedford ordinances.

TYPE OF USE: RESIDENTIAL COMMERCIAL INDUSTRIAL OTHER Nursing Home

If applicant other than actual property owner, attach Letter of Authorization from Property Owner.

Name Michael Backsteer Tel. 508-989-2176  
Mailing Address 1289 Reed St. N. Dartmouth, MA  
The Bonded Contractor/Drain Layer authorized to perform this work is:  
W.C. Smith & Son 58 Ridgewood Rd. NB MA 508-995-1449  
Name Address Tel.  
Type of Pipe Required: PVC SDR-35

PERMIT EXPIRES ONE YEAR AFTER DATE OF ISSUE

- Requires separate connections for sewage and storm drain where applicable. Storm water cannot be discharged to a sanitary sewer.
  - All work must be inspected and approved by a D.P.I. inspector before backfilling.
  - If this connection is to be part of a private service shared jointly with other building owners, attach copy of Recorded Joint Maintenance Agreement.
  - Permits can be issued to Industrial and/or Commercial Applicants only upon receipt and approval by the Commissioner of Public Infrastructure of required plans and supplemental information.
  - In addition, a City-issued Industrial User Discharge Permit and/or a Sewer Extension/Connection Permit issued by the Commonwealth of Massachusetts D.E.P. shall be required by the City for Industrial Discharge into the sewer system.
- Industrial User Discharge Permit No. Date

Comm. Mass. Sewer Conn./Ext. Permit No. Date

A Filing and Inspection Fee of \$150, plus an Entrance Fee of \$, where applicable, must accompany this application.

Bank# Bank Five Check# 2483 Date 6/27/06 Receipt# 6391

Other requirements: Insp. Only - Connect S.D. from Catch Basin in Private Property to Storm Drain Main. Flowable Fill Required. 24 hrs notice for all inspections.

Connection made to Sewer Part of jointly-shared private line YES NO  
Storm Drain

Applicant agrees to abide by the above terms, as well as all pertinent ordinances of the City of New Bedford, and such other special rules as the Commissioner of Public Infrastructure and/or City Engineer may deem necessary

Duart M. Andrade (ms)  
Acting City Engineer


Signature of Property Owner or Representative

INSPECTOR'S REPORT

INSPECTED BY: Bob Baker  
DATE: 7/6/06  
COMMENTS:

APPROVED DISAPPROVED

SIGNATURE

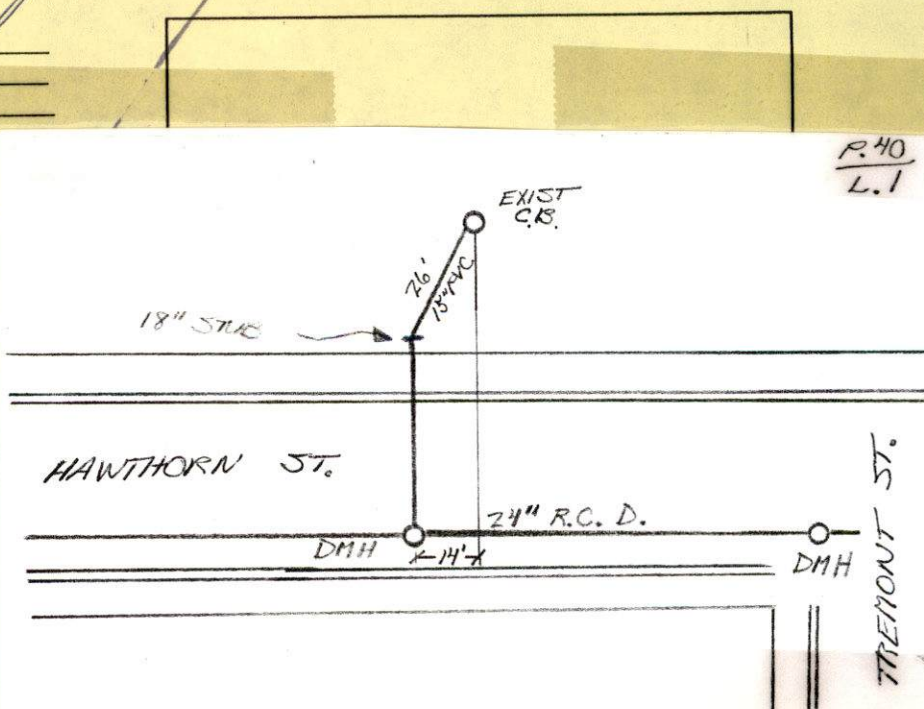





PERMIT NO.  
23852

CITY OF NEW BEDFORD  
SEWER AND/OR STORM DRAIN PERMIT

DATE 6/28/06

This certifies that permission is granted to

N.B. Jewish Convalescent Home 414 County St. NB, MA 508-997-93  
Property Owner Address Tel.

To connect a sewer and/or storm drain located at 200 Hawthorn St.

Assessor's Plot 40 Lot 1, to the sewer and/or storm drain in Hawthorn St. Street

To be laid in accordance with the conditions in this application and the City of New Bedford ordinances.

TYPE OF USE: RESIDENTIAL COMMERCIAL INDUSTRIAL OTHER

Nursing Home

If applicant other than actual property owner, attach Letter of Authorization from Property Owner.

Name Michael Bachstein Tel. 508-989-2176

Mailing Address 1289 Reed St. N. Dartmouth, Ma.

The Bonded Contractor/Drain Layer authorized to perform this work is:

W.C. Smith & Son 58 Ridgewood Rd. NB, MA 508-995-1449

Name Address Tel.

Type of Pipe Required: PVC SDR-35

PERMIT EXPIRES ONE YEAR AFTER DATE OF ISSUE

- Requires separate connections for sewage and storm drain where applicable. Storm water cannot be discharged to a sanitary sewer.
- All work must be inspected and approved by a D.P.I. inspector before backfilling.
- If this connection is to be part of a private service shared jointly with other building owners, attach copy of Recorded Joint Maintenance Agreement.
- Permits can be issued to Industrial and/or Commercial Applicants only upon receipt and approval by the Commissioner of Public Infrastructure of required plans and supplemental information.
- In addition, a City-issued Industrial User Discharge Permit and/or a Sewer Extension/Connection Permit issued by the Commonwealth of Massachusetts D.E.P. shall be required by the City for Industrial Discharge into the sewer system.

Industrial User Discharge Permit No. Date

Comm. Mass. Sewer Conn./Ext. Permit No. Date

A Filing and Inspection Fee of \$150, plus an Entrance Fee of \$ where applicable, must accompany this application.

Bank# Bank Five Check# 2483 Date 6/27/06 Receipt# 6391

Other requirements: Insp. Only - Connect S.D. from Catch Basin in Private Property  
to Storm Drain Main. Flowable Fill Required, 24 hrs notice for all inspection

Connection made to Storm Drain Part of jointly-shared private line YES NO

Applicant agrees to abide by the above terms, as well as all pertinent ordinances of the City of New Bedford, and such other special rules as the Commissioner of Public Infrastructure and/or City Engineer may deem necessary

Duarte M. Andrade (ms)  
Acting City Engineer

[Signature]  
Signature of Property Owner or Representative

INSPECTOR'S REPORT

INSPECTED BY: Bob Bichel  
DATE: 7/6/06  
COMMENTS:

APPROVED

DISAPPROVED

[Signature]  
SIGNATURE

6/29/06 Sewer - "Drain clasp"  
for Thursday 7/6/06  
11 Am.

SKETCH PLAN





PERMIT NO.  
**23852**

CITY OF NEW BEDFORD  
SEWER AND/OR STORM DRAIN PERMIT

DATE 6/28/06

This certifies that permission is granted to

N.B. Jewish Convalescent Home 414 County St. NB, MA 508-997-9314  
Property Owner Address Tel.

To connect a sewer and/or storm drain located at 200 Hawthorn St.

Assessor's Plot 40 Lot 1, to the sewer and/or storm drain in Hawthorn St. Street

To be laid in accordance with the conditions in this application and the City of New Bedford ordinances.

TYPE OF USE: RESIDENTIAL COMMERCIAL INDUSTRIAL OTHER Nursing Home

If applicant other than actual property owner, attach Letter of Authorization from Property Owner.

Name Michael Backstein Tel. 508-989-2176

Mailing Address 1289 Reed St. N. Dartmouth, Ma.

The Bonded Contractor/Drain Layer authorized to perform this work is:

W.C. Smith & Son 58 Ridgewood Rd. NB, MA 508-995-1449

Name Address Tel.

Type of Pipe Required: PVC SDR-35

PERMIT EXPIRES ONE YEAR AFTER DATE OF ISSUE

- Requires separate connections for sewage and storm drain where applicable. Storm water cannot be discharged to a sanitary sewer.
- All work must be inspected and approved by a D.P.I. inspector before backfilling.
- If this connection is to be part of a private service shared jointly with other building owners, attach copy of Recorded Joint Maintenance Agreement.
- Permits can be issued to Industrial and/or Commercial Applicants only upon receipt and approval by the Commissioner of Public Infrastructure of required plans and supplemental information.
- In addition, a City-issued Industrial User Discharge Permit and/or a Sewer Extension/Connection Permit issued by the Commonwealth of Massachusetts D.E.P. shall be required by the City for Industrial Discharge into the sewer system.

Industrial User Discharge Permit No. Date

Comm. Mass. Sewer Conn./Ext. Permit No. Date

A Filing and Inspection Fee of \$150, plus an Entrance Fee of \$ where applicable, must accompany this application.

Bank# Bank Five Check# 2483 Date 6/27/06 Receipt# 6391

Other requirements: Insp. Only - Connect S.D. from Catch Basin in Private Property  
to Storm Drain Main. Flowable Fill Required, 24 hrs notice for all inspections

Connection made to Storm Drain Part of jointly-shared private line YES NO

Applicant agrees to abide by the above terms, as well as all pertinent ordinances of the City of New Bedford, and such other special rules as the Commissioner of Public Infrastructure and/or City Engineer may deem necessary

Duarte M. Andrade (ms)  
Acting City Engineer

[Signature]  
Signature of Property Owner or Representative

INSPECTOR'S REPORT

INSPECTED BY: \_\_\_\_\_  
DATE: \_\_\_\_\_  
COMMENTS: \_\_\_\_\_

APPROVED \_\_\_\_\_ DISAPPROVED \_\_\_\_\_

[Signature]  
SIGNATURE

SKETCH PLAN

NEW BEDFORD  
*NBJCH*  
*Jewish Convalescent Home, Inc.*

---

June 28, 2006

City of New Bedford  
Department of InfraStructure  
Shawmut Avenue  
New Bedford, MA 02746

To Whom It May Concern,

The New Bedford Jewish Convalescent Home requests a tie in with the cities storm water. Michael Bachstein will act as the Home's representative.

Sincerely,

*Carol A. Trudeau*

Carol A. Trudeau  
Administrator

*Michael B. Bachstein*

*508-989-2176 mobile -*

BANK FIVE  
FALL RIVER, MA 02722

2483

53-7064/2113

**MICHAEL R. BACHSTEIN, ARCHITECT**

1289 REED ROAD  
NORTH DARTMOUTH, MA 02747  
508-989-2176

6/27/00

PAY TO THE  
ORDER OF

*City of New Bedford*

\$ 150.00

*One Hundred Fifty and 00/100*

DOLLARS

6001-439-44201-000

MEMO


*N. B. T. C. H. STORMWATER PERMIT*

*MB*

⑈002483⑈ ⑆211370642⑆900437345⑈

6/25/04

200 HAWTHORNE ST.

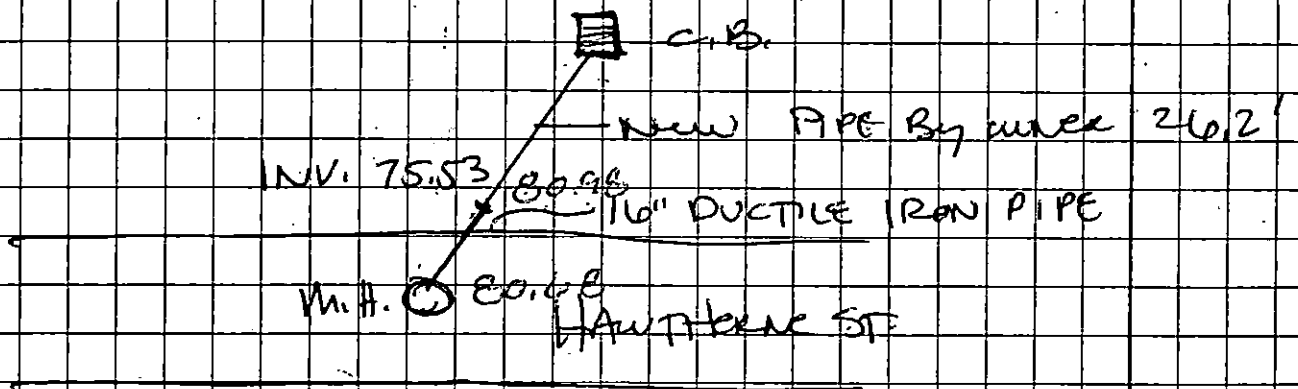New Bedford Jewish Community Center Home

**Michele Avila-Silva**

---

**From:** Sarah Porter  
**Sent:** Thursday, June 29, 2006 6:43 PM  
**To:** Michele Avila-Silva  
**Subject:** RE:

OK for them to tie in the catch basins  
Thank you

-----Original Message-----

**From:** Michele Avila-Silva  
**Sent:** Thursday, June 29, 2006 8:16 AM  
**To:** Sarah Porter  
**Subject:**

Hi Sarah,

Could you please let me know if there are any wetlands or conservation issues at the Jewish Convalescent Home at 200 Hawthorn Street? They are looking to tie in their catchbasins to a new storm drain main that was installed in Hawthorn Street.

Thanks,  
Michele