



PERMIT NO.
23868

CITY OF NEW BEDFORD
SEWER AND/OR STORM DRAIN PERMIT

DATE 7/26/06
EXP. 7/26/07

This certifies that permission is granted to

Clarinda Mello 472 West Clinton St NB, MA 508-996-2772
Property Owner Address Tel.

To connect a sewer and/or storm drain located at 24 Seventh St

Assessor's Plot 46 Lot 60, to the sewer and/or storm drain in School St Street

To be laid in accordance with the conditions in this application and the City of New Bedford ordinances.

TYPE OF USE: RESIDENTIAL COMMERCIAL INDUSTRIAL OTHER 220 GPD

If applicant other than actual property owner, attach Letter of Authorization from Property Owner.

Name.....Tel.....

Mailing Address.....

The Bonded Contractor/Drain Layer authorized to perform this work is:

Franklin Bros 4393 Aushnet Ave NB 508-998-8270

Name Address Tel.

Type of Pipe Required: PVC SDR-35

PERMIT EXPIRES ONE YEAR AFTER DATE OF ISSUE

- Requires separate connections for sewage and storm drain where applicable. Storm water cannot be discharged to a sanitary sewer.
 - All work must be inspected and approved by a D.P.I. inspector before backfilling.
 - If this connection is to be part of a private service shared jointly with other building owners, attach copy of Recorded Joint Maintenance Agreement.
 - Permits can be issued to Industrial and/or Commercial Applicants only upon receipt and approval by the Commissioner of Public Infrastructure of required plans and supplemental information.
 - In addition, a City-issued Industrial User Discharge Permit and/or a Sewer Extension/Connection Permit issued by the Commonwealth of Massachusetts D.E.P. shall be required by the City for Industrial Discharge into the sewer system.
- Industrial User Discharge Permit No.....Date.....

Comm. Mass. Sewer Conn./Ext. Permit No.....Date.....

A Filing and Inspection Fee of \$.150, plus an Entrance Fee of \$..... where applicable, must accompany this application.

Bank# First Citizens Check# 5611 Date 7/26/06 Receipt# 6475

Other requirements: Connect to 20" Brick Sewer in School St, Insp Only,
Service thru Easement @ 26 Seventh St, Cleanout to be installed

Connection made to Sewer Part of jointly-shared private line YES NO
Storm Drain

Applicant agrees to abide by the above terms, as well as all pertinent ordinances of the City of New Bedford, and such other special rules as the Commissioner of Public Infrastructure and/or City Engineer may deem necessary

Duarte M. Andrade MS
Acting City Engineer

Signature of Property Owner or Representative


INSPECTOR'S REPORT

INSPECTED BY: Bob Bichel
DATE: 8/8/06
COMMENTS:

APPROVED

DISAP

Bob Bichel MS
SIGNATURE

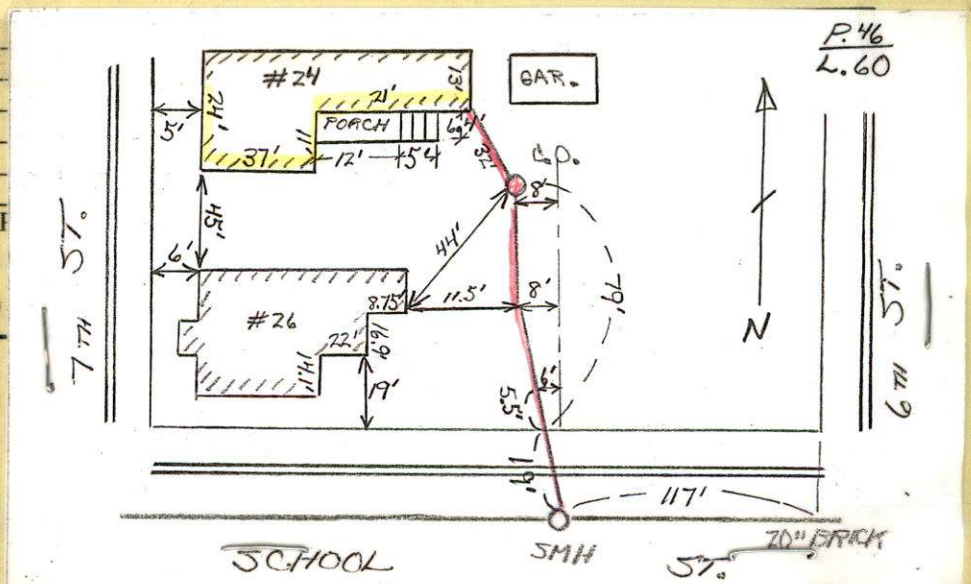

6/26/06 OK with Sam



PERMIT NO.

23868

CITY OF NEW BEDFORD
SEWER AND/OR STORM DRAIN PERMIT

DATE 7/26/06
EXP. 7/26/07

This certifies that permission is granted to

Clarinda Mello 472 West Clinton St. NB, MA 508-996-2772
Property Owner Address Tel.

To connect a sewer and/or storm drain located at 24 Seventh St

Assessor's Plot 46 Lot 60, to the sewer and/or storm drain in School St Street

To be laid in accordance with the conditions in this application and the City of New Bedford ordinances.

TYPE OF USE: RESIDENTIAL COMMERCIAL INDUSTRIAL OTHER 220 GPD

If applicant other than actual property owner, attach Letter of Authorization from Property Owner.

Name Mailing Address Tel.

The Bonded Contractor/Drain Layer authorized to perform this work is:

Franklin Bros 4393 Awshnet Ave NB 508-998-8270

Name Address Tel.

Type of Pipe Required: PVC SDR-35

PERMIT EXPIRES ONE YEAR AFTER DATE OF ISSUE

- Requires separate connections for sewage and storm drain where applicable. Storm water cannot be discharged to a sanitary sewer.
- All work must be inspected and approved by a D.P.I. inspector before backfilling.
- If this connection is to be part of a private service shared jointly with other building owners, attach copy of Recorded Joint Maintenance Agreement.
- Permits can be issued to Industrial and/or Commercial Applicants only upon receipt and approval by the Commissioner of Public Infrastructure of required plans and supplemental information.
- In addition, a City-issued Industrial User Discharge Permit and/or a Sewer Extension/Connection Permit issued by the Commonwealth of Massachusetts D.E.P. shall be required by the City for Industrial Discharge into the sewer system.

Industrial User Discharge Permit No. Date

Comm. Mass. Sewer Conn./Ext. Permit No. Date

A Filing and Inspection Fee of \$150, plus an Entrance Fee of \$ where applicable, must accompany this application.

Bank# First Citizens Check# 5611 Date 7/26/06 Receipt# 6475

Other requirements: Connect to 20" Brick Sewer in School St, Insp Only,
Service thru Easement @ 26 Seventh St, Cleanout to be installed.

Connection made to Sewer Part of jointly-shared private line YES NO
Storm Drain

Applicant agrees to abide by the above terms, as well as all pertinent ordinances of the City of New Bedford, and such other special rules as the Commissioner of Public Infrastructure and/or City Engineer may deem necessary

Duarte M. Andrade MS
Acting City Engineer

Signature of Property Owner or Representative

INSPECTOR'S REPORT

INSPECTED BY: _____
DATE: _____
COMMENTS: _____

APPROVED DISAPPROVED

SIGNATURE

SKETCH PLAN

6/26/06 OK with Sara

SEWER EASEMENT

John A. Tierney (Grantor), owner of the real estate located at 26 Seventh Street, New Bedford, MA, hereby grants to Clarinda M. Mello and Joseph G. Mello, owners of property located at 24 Seventh Street, New Bedford, MA, the perpetual right and easement to use the land along the easterly boundary line of the Grantor's land to School Street for a width of 10 feet, for the purpose of installing, maintaining, replacing, removing and using a sewer line and related equipment for the benefit of Grantee's property.


If in connection with the installation of the sewer line or otherwise any excavations are made in the easement the party making such excavation shall restore said land and surfaces to their prior condition.

Each party shall indemnify and save the other harmless from and against any loss, damage or liability arising out of the exercise of said rights and easements.

The forgoing right and easement shall be exercisable only by the Grantor and the Grantee and their respective successors and assigns and other to whom said right and easement may be specifically assigned.

For title of John A. Tierney see deed recorded at the Bristol County Southern District Registry of Deeds at Book 2498 Page 318; and for title of Clarinda M. Mello and Joseph G. Mello see deed recorded at said Registry at Book 8127 Page 75.


Signed as a sealed instrument this 24th day of July, 2006.

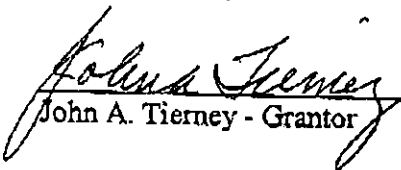
John A. Tierney - Grantor

Commonwealth of Massachusetts

Bristol, SS

On this 24th day of July, 2006, before me the undersigned notary public, personally appeared the above named John A. Tierney, proved to me by satisfactory evidence which were drivers licenses, and he all acknowledged he executed the foregoing as his free act and deed for its stated purpose.

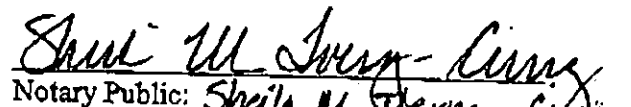
Notary Public: Sheila M. Tierney-Cibola
Commission Expires: 8/22/08

return: Law office of Paul M. Akred
61 E. Main St.
Norton, MA 02766




গোৱাৰী

2" TOP of PIPE (6" 502 PVC)
• END POINT of 20" STAIR
(DOGHOUSE ON TOP of
20" BRICK BOWER)

1982/2

✓✓✓✓✓

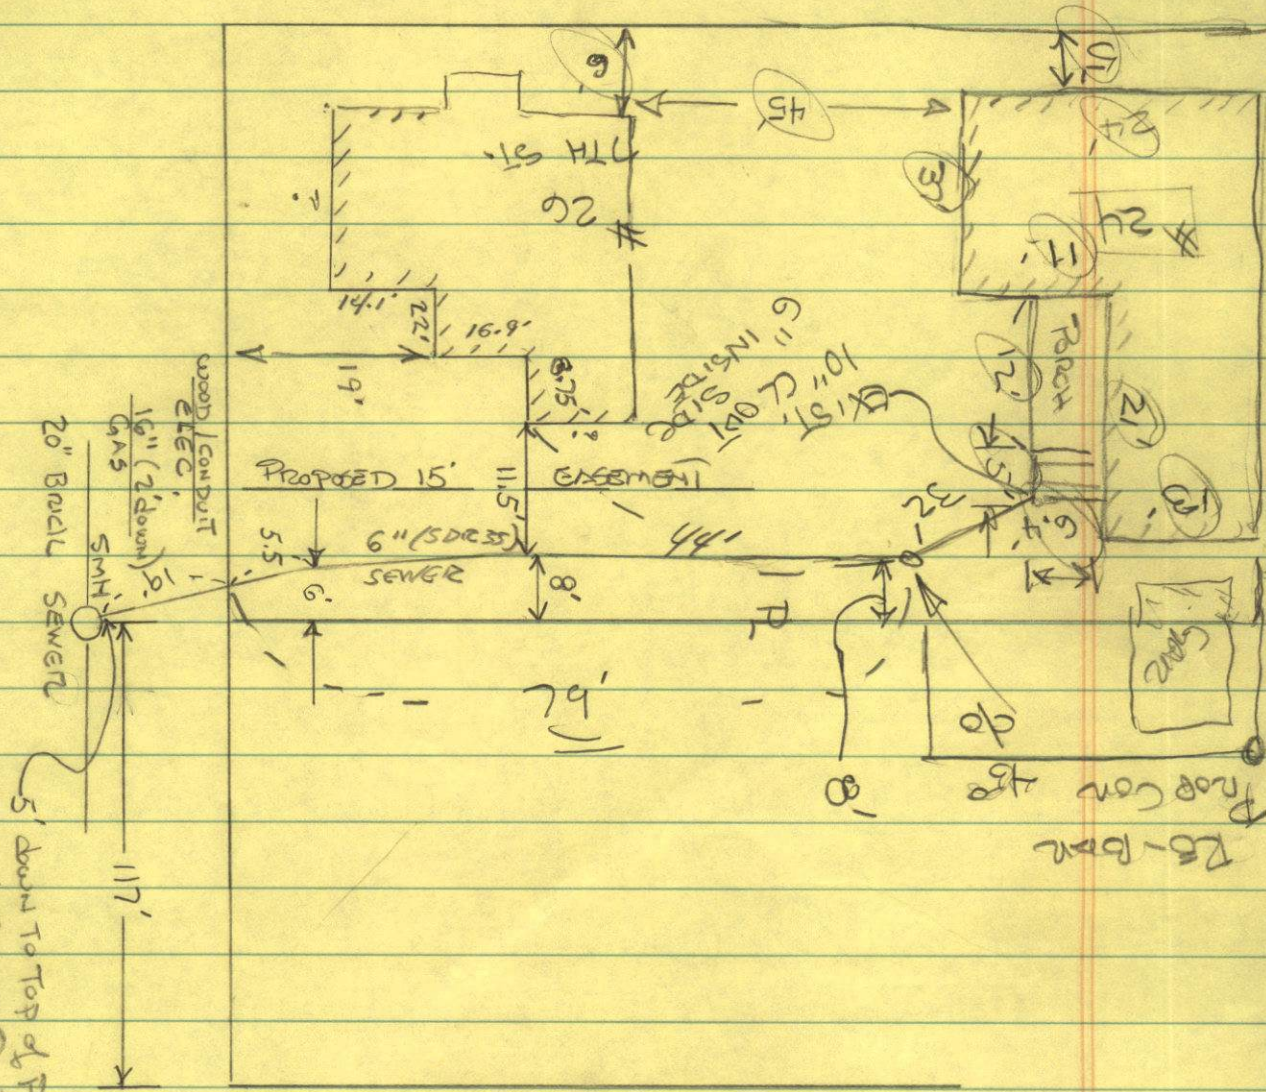

James Hill

