



PERMIT NO.

23885

CITY OF NEW BEDFORD  
SEWER AND/OR STORM DRAIN PERMIT

DATE 9/5/06

This certifies that permission is granted to

Stephen Gendron P.O. 428 Somerset, MA.  
Property Owner Address Tel.

To connect a sewer and/or storm drain located at Hathaway Rd. 36" R.C.P.

Assessor's Plot 96 Lot 41, to the sewer and/or storm drain in Hathaway Rd. Street

To be laid in accordance with the conditions in this application and the City of New Bedford ordinances.

TYPE OF USE: RESIDENTIAL ☒ COMMERCIAL INDUSTRIAL OTHER

If applicant other than actual property owner, attach Letter of Authorization from Property Owner.

Name Steve Rezendes Tel. 508 984 1668  
Mailing Address 21 East River Dr. Dartmouth

The Bonded Contractor/Drain Layer authorized to perform this work is:

J.B. Langan Co. Inc. 21 East River Drive Dartmouth 984-1668  
Name Address Tel.

Type of Pipe Required: 18" R.C.P.

## PERMIT EXPIRES ONE YEAR AFTER DATE OF ISSUE

- Requires separate connections for sewage and storm drain where applicable. Storm water cannot be discharged to a sanitary sewer.
  - All work must be inspected and approved by a D.P.I. inspector before backfilling.
  - If this connection is to be part of a private service shared jointly with other building owners, attach copy of Recorded Joint Maintenance Agreement.
  - Permits can be issued to Industrial and/or Commercial Applicants only upon receipt and approval by the Commissioner of Public Infrastructure of required plans and supplemental information.
  - In addition, a City-issued Industrial User Discharge Permit and/or a Sewer Extension/Connection Permit issued by the Commonwealth of Massachusetts D.E.P. shall be required by the City for Industrial Discharge into the sewer system.
- Industrial User Discharge Permit No. Date

Comm. Mass. Sewer Conn./Ext. Permit No. Date

A Filing and Inspection Fee of \$150.00 plus an Entrance Fee of \$ where applicable, must accompany this application.

Bank# Sovereign Check# 16777 Date 9/5/06 Receipt# 6613

Other requirements: 24 hr. inspection at 508-979-1527

flowable fill

Sewer  
Connection made to Storm Drain Part of jointly-shared private line YES NO


Applicant agrees to abide by the above terms, as well as all pertinent ordinances of the City of New Bedford, and such other special rules as the Commissioner of Public Infrastructure and/or City Engineer may deem necessary

Duarte M. Andrade  
Acting City Engineer  
Signature of Property Owner or Representative


## INSPECTOR'S REPORT

INSPECTED BY: KEVIN CORNELL  
DATE: 9-15-06  
COMMENTS:

APPROVED DISAPPROVED

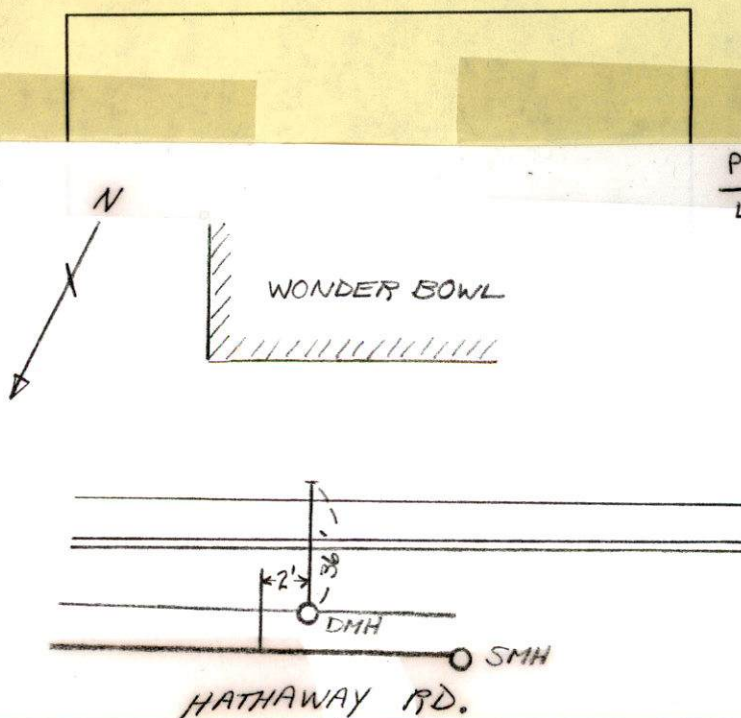Kevin S. Cornell  
SIGNATUREP. 96  
L. 41



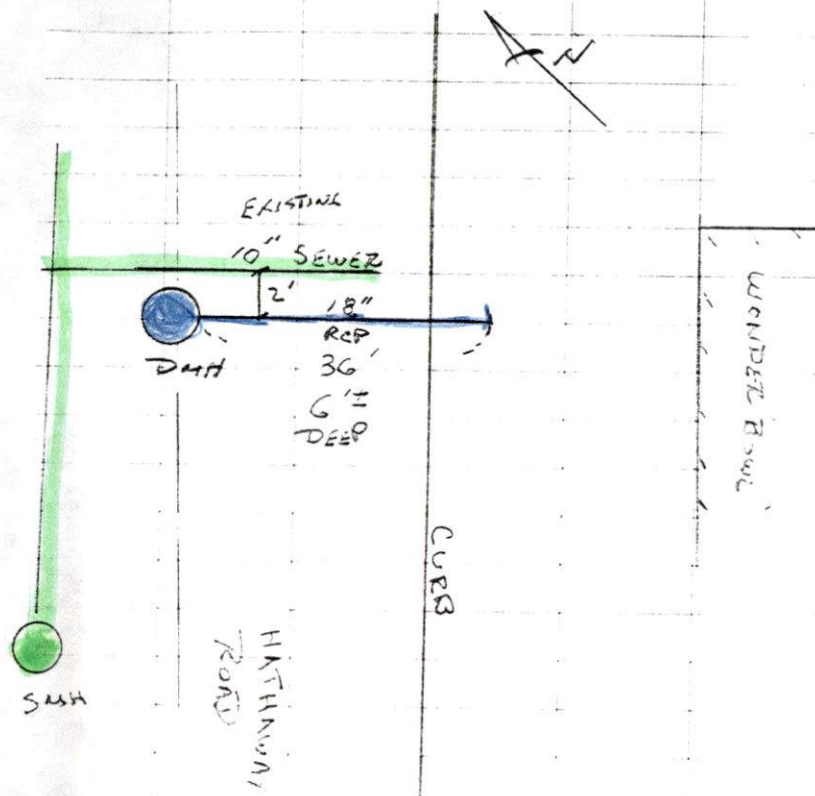

5

9-18-06

HATHAWAY ROAD - DRAIN  
FOR WONDER BOWL

PERMIT # Z3895

CONTRACTOR - J. B. LANAGAN





PERMIT NO.  
**23885**

CITY OF NEW BEDFORD  
SEWER AND/OR STORM DRAIN PERMIT

DATE 9/5/06

This certifies that permission is granted to

Stephen Gendron P.O. 428 Somerset, MA  
Property Owner Address Tel.

To connect a sewer and/or storm drain located at 64 Hathaway Rd. 36" R.C.P.

Assessor's Plot 96 Lot 41, to the sewer and/or storm drain in Hathaway Rd. Street

To be laid in accordance with the conditions in this application and the City of New Bedford ordinances.  
TYPE OF USE: RESIDENTIAL ☒ COMMERCIAL INDUSTRIAL OTHER

If applicant other than actual property owner, attach Letter of Authorization from Property Owner.

Name Steve Rezendes Tel. 508 984 1668  
Mailing Address 21 East River Dr. Dartmouth

The Bonded Contractor/Drain Layer authorized to perform this work is:  
J.B. Lanagan Co. Inc. 21 East River Drive Dartmouth 984-1668  
Name Address Tel.

Type of Pipe Required: 18" R.C.P.

PERMIT EXPIRES ONE YEAR AFTER DATE OF ISSUE

- Requires separate connections for sewage and storm drain where applicable. Storm water cannot be discharged to a sanitary sewer.
  - All work must be inspected and approved by a D.P.I. inspector before backfilling.
  - If this connection is to be part of a private service shared jointly with other building owners, attach copy of Recorded Joint Maintenance Agreement.
  - Permits can be issued to Industrial and/or Commercial Applicants only upon receipt and approval by the Commissioner of Public Infrastructure of required plans and supplemental information.
  - In addition, a City-issued Industrial User Discharge Permit and/or a Sewer Extension/Connection Permit issued by the Commonwealth of Massachusetts D.E.P. shall be required by the City for Industrial Discharge into the sewer system.
- Industrial User Discharge Permit No. \_\_\_\_\_ Date \_\_\_\_\_

Comm. Mass. Sewer Conn./Ext. Permit No. \_\_\_\_\_ Date \_\_\_\_\_  
A Filing and Inspection Fee of \$150.00 plus an Entrance Fee of \$ \_\_\_\_\_ where applicable, must accompany this application.

Bank# Sovereign Check# 16777 Date 9/5/06 Receipt# 6613

Other requirements: 24 hr. inspection at 508-979-1527  
flowable fill  
Sewer

Connection made to Storm Drain Part of jointly-shared private line YES NO

Applicant agrees to abide by the above terms, as well as all pertinent ordinances of the City of New Bedford, and such other special rules as the Commissioner of Public Infrastructure and/or City Engineer may deem necessary

Quante M. Andrade  
Acting City Engineer mn


\_\_\_\_\_  
Signature of Property Owner or Representative

INSPECTOR'S REPORT

INSPECTED BY: \_\_\_\_\_  
DATE: \_\_\_\_\_  
COMMENTS: \_\_\_\_\_

APPROVED \_\_\_\_\_ DISAPPROVED \_\_\_\_\_

SIGNATURE

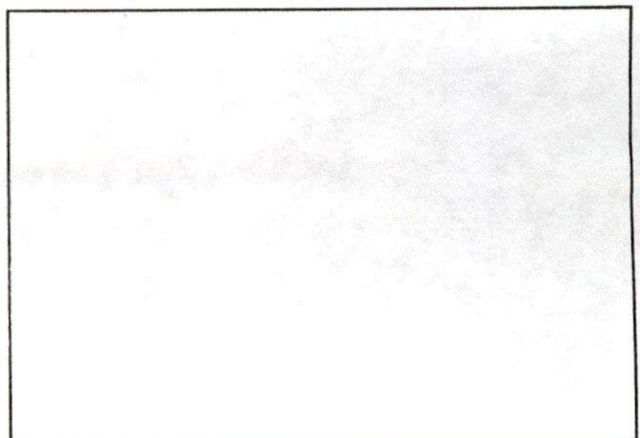

SKETCH PLAN





# CITY OF NEW BEDFORD MASSACHUSETTS

D.P.I. -Engineering Division

1105 Shawmut Ave.

New Bedford, Ma. 02746

Tel: 508-991-6150

Fax: 508-961-3054 991-6152

Ronald Labelle  
Commissioner

Duarte M. Andrade,  
Acting City Engineer

To Whom It May Concern:

I Stephen Gendron 80 428 Somerset MA., being  
(Name) (Mailing Address)

Owner of property located at 66 Hathaway Rd NB

Plot 96, Lot 41, hereby agree to allow J.B. Langley & Co.  
(Name)

21 East River River Dr, to act on my behalf including affixing my  
(Mailing Address)

signature in securing permit for:

☒ Sewer/Drain Service Permits  
☐ Water Service Permits  
☐ Driveway Installation Permits  
☐ Sidewalk Installation Permits

I further agree to conform to, and abide by, All City rules and ask regulations applicable to the permit (s) being applied for:

Name [Signature]  
Signature  
80 428 Somerset MA.  
Address

9/5/06  
Date

774 644 8155  
Telephone number