



9/7/07

PERMIT NO.

23887

CITY OF NEW BEDFORD
SEWER AND/OR STORM DRAIN PERMIT

DATE 9/7/06

This certifies that permission is granted to

Jose Cruz 1074 Marlboro St NB 508.99.8.2445
Property Owner Address Tel.

To connect a sewer and/or storm drain located at stub at Marlboro St.

Assessor's Plot 132H Lot 351, to the sewer and/or storm drain in Marlboro Street

To be laid in accordance with the conditions in this application and the City of New Bedford ordinances.

TYPE OF USE: ☒ RESIDENTIAL ☐ COMMERCIAL ☐ INDUSTRIAL ☐ OTHER

If applicant other than actual property owner, attach Letter of Authorization from Property Owner.

Name..... Tel.....

Mailing Address.....

The Bonded Contractor/Drain Layer authorized to perform this work is:

Cardoso Contracting 95R 5 Main St Acushnet 508.998.5115
Name Address Tel.

Type of Pipe Required: SDR 35 pvc

PERMIT EXPIRES ONE YEAR AFTER DATE OF ISSUE

- Requires separate connections for sewage and storm drain where applicable. Storm water cannot be discharged to a sanitary sewer.
- All work must be inspected and approved by a D.P.I. inspector before backfilling.
- If this connection is to be part of a private service shared jointly with other building owners, attach copy of Recorded Joint Maintenance Agreement.
- Permits can be issued to Industrial and/or Commercial Applicants only upon receipt and approval by the Commissioner of Public Infrastructure of required plans and supplemental information.
- In addition, a City-issued Industrial User Discharge Permit and/or a Sewer Extension/Connection Permit issued by the Commonwealth of Massachusetts D.E.P. shall be required by the City for Industrial Discharge into the sewer system.

Industrial User Discharge Permit No..... Date.....

Comm. Mass. Sewer Conn./Ext. Permit No..... Date.....

A Filing and Inspection Fee of \$50.00 plus an Entrance Fee of \$..... where applicable, must accompany this application.

Bank# Citizens Bank Check# 1080 Date 9/8/06 Receipt# 10624

Other requirements:.....


24 hr inspection notice at 508.979.1527

Connection made to Sewer Part of jointly-shared private line YES NO
Storm Drain

Applicant agrees to abide by the above terms, as well as all pertinent ordinances of the City of New Bedford, and such other special rules as the Commissioner of Public Infrastructure and/or City Engineer may deem necessary

Dante M. Andrade
Acting City EngineerJose P. Cruz
Signature of Property Owner or Representative

INSPECTOR'S REPORT

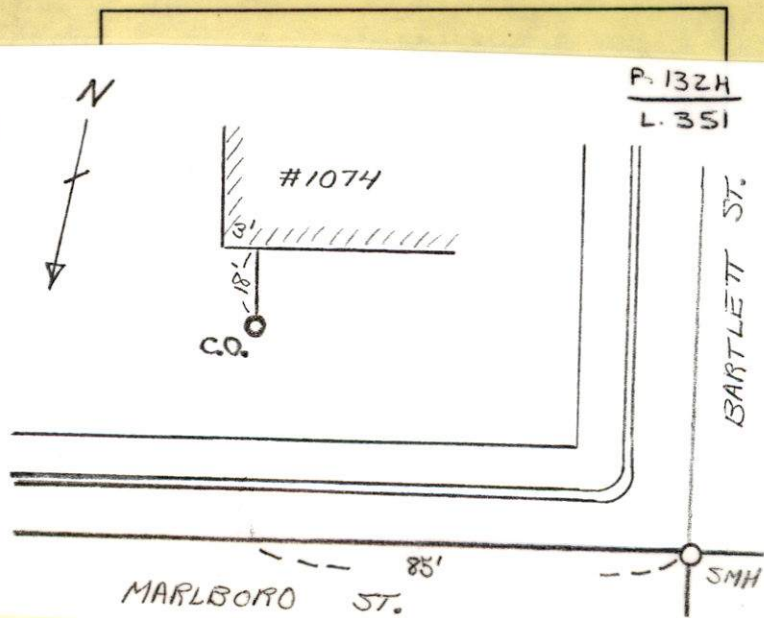INSPECTED BY: KEVIN CORWELL
DATE: 9-21-06
COMMENTS:☒ APPROVED ☐ DISAPPROVEDKevin J. Corwell
SIGNATURE



PERMIT NO.
23887

CITY OF NEW BEDFORD
SEWER AND/OR STORM DRAIN PERMIT

9/7/07
DATE 9/7/06

This certifies that permission is granted to

Jose Cruz 10.74 Marlboro St. NB 508.99.8.2445
Property Owner Address Tel.

To connect a sewer and/or storm drain located at stub at Marlboro St.

Assessor's Plot 132H Lot 351, to the sewer and/or storm drain in Marlboro Street

To be laid in accordance with the conditions in this application and the City of New Bedford ordinances.

TYPE OF USE: RESIDENTIAL COMMERCIAL INDUSTRIAL OTHER

If applicant other than actual property owner, attach Letter of Authorization from Property Owner.

Name Tel.

Mailing Address

The Bonded Contractor/Drain Layer authorized to perform this work is:

Cardoso Contracting 25 R. S. Main St. Acushnet 508.228.5115
Name Address Tel.

Type of Pipe Required: S.D.R. 35 pvc

OWNER TO PAY FOR STUB CONNECTION AND ASSESSMENT FEE ONCE IT HAS BEEN DETERMINED BY THE CITY

PERMIT EXPIRES ONE YEAR AFTER DATE OF ISSUE

- Requires separate connections for sewage and storm drain where applicable. Storm water cannot be discharged to a sanitary sewer.
 - All work must be inspected and approved by a D.P.I. inspector before backfilling.
 - If this connection is to be part of a private service shared jointly with other building owners, attach copy of Recorded Joint Maintenance Agreement.
 - Permits can be issued to Industrial and/or Commercial Applicants only upon receipt and approval by the Commissioner of Public Infrastructure of required plans and supplemental information.
 - In addition, a City-issued Industrial User Discharge Permit and/or a Sewer Extension/Connection Permit issued by the Commonwealth of Massachusetts D.E.P. shall be required by the City for Industrial Discharge into the sewer system.
- Industrial User Discharge Permit No. Date.

Comm. Mass. Sewer Conn./Ext. Permit No. Date.

A Filing and Inspection Fee of \$50.00 plus an Entrance Fee of \$ where applicable, must accompany this application.

Bank# Citizens Bank Check# 1080 Date 9/8/06 Receipt# 6624

Other requirements:

24 hr inspection notice at 508.979.1527

Connection made to Sewer Part of jointly-shared private line YES NO
Storm Drain

Applicant agrees to abide by the above terms, as well as all pertinent ordinances of the City of New Bedford, and such other special rules as the Commissioner of Public Infrastructure and/or City Engineer may deem necessary

Duarte M. Andrade
Acting City Engineer


Jose P. Cruz
Signature of Property Owner or Representative

INSPECTOR'S REPORT


INSPECTED BY:
DATE:
COMMENTS:

APPROVED DISAPPROVED

SIGNATURE

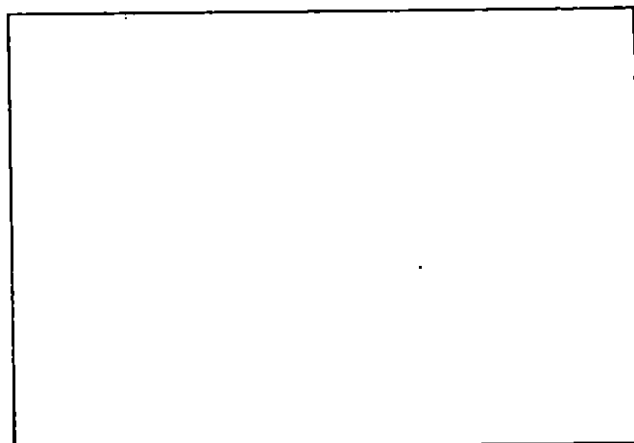

SKETCH PLAN

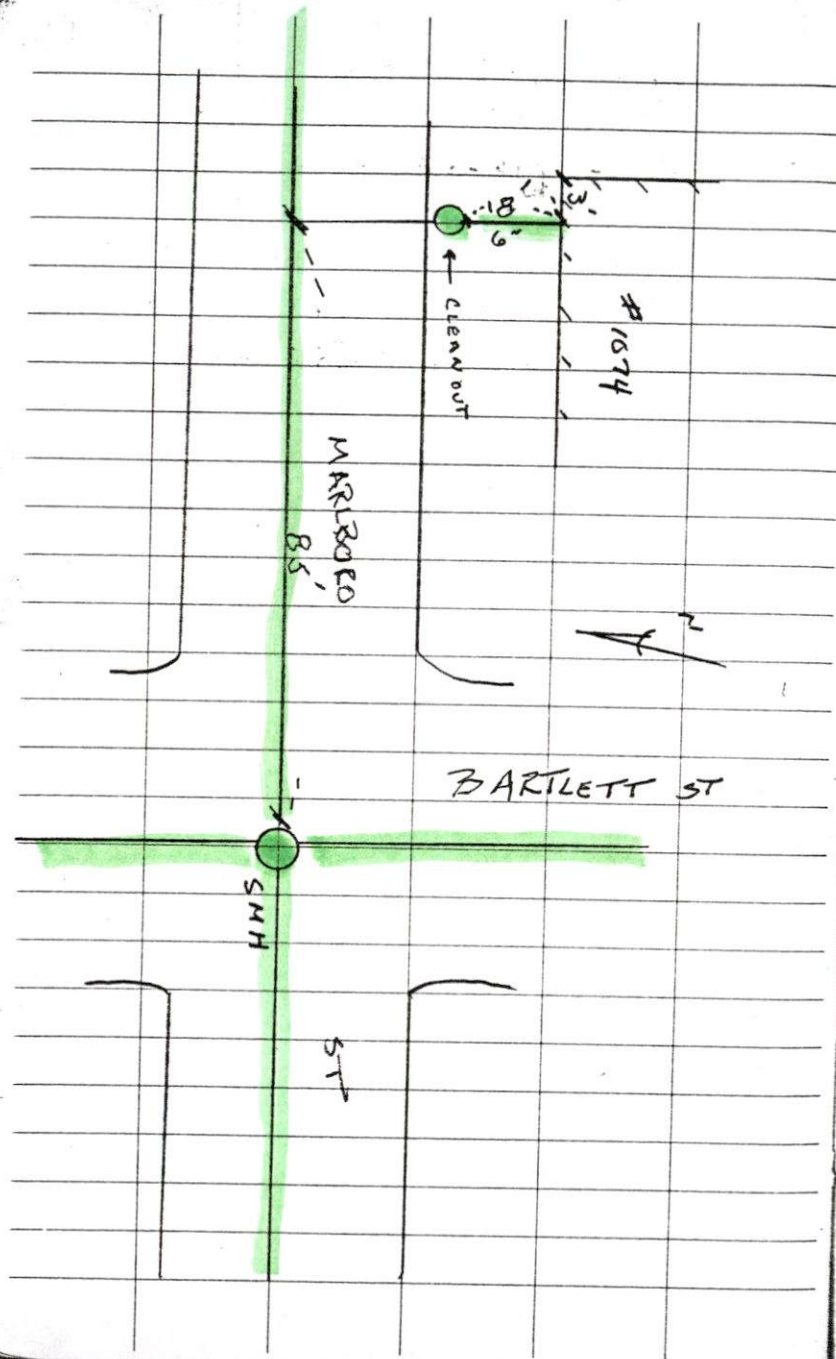

9-21-06

SUNNY 70° (6)
THURSDAY

#1074 MARLBORO ST
PERMIT 23887

CONTRACTOR - NELSON CARDOSA
CELL - 508-294-8507

City of New Bedford ~ Real Property On-Line ASSESSOR'S OFFICE

Location: 1074 MARLBORO ST Parcel ID: 132H 351 Zoning: 2RB Fiscal Year: 2007

Current Owner Information:

CRUZ JOSE P
AMELIA CRUZ
1074 MARLBOROUGH ST

NEW BEDFORD, MA 02740

Current Sales Information:

Sale Date: 12/31/1989
Sale Price: 0
Legal Reference: 1693-472
Grantor: N/A



Enter card number to view

Card 1 of 1

[New Search](#)

This Property contains 0.146 acres of land mainly classified as Single Family with a(n) RANCH style building, built about 1974, having Wood Shingle exterior and Asphalt roof cover, with 1 unit(s), 5 total room(s), 3 total bedroom(s) 1 total bath(s), 0 3/4 baths, and 0 total half bath(s).

Building Value: 146100 Land Value: 104700 Yard Items Value: 1800 Total Value: 252600

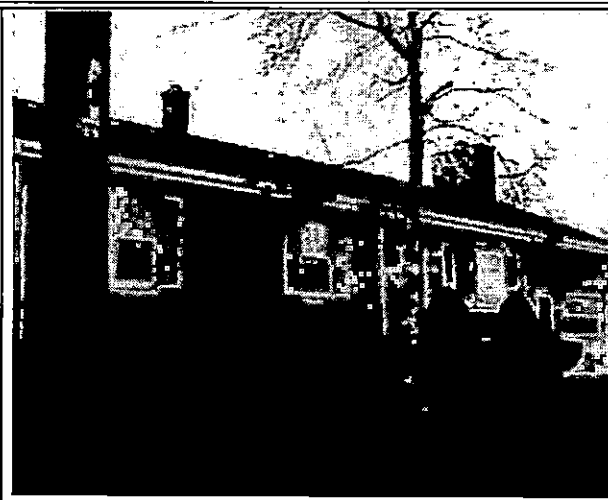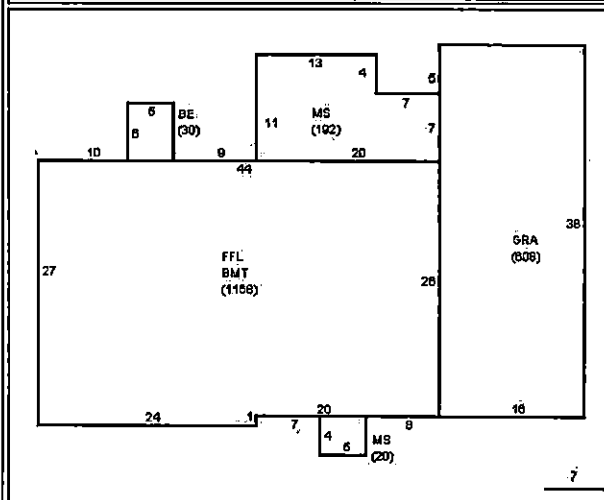

Fiscal Year 2007		Fiscal Year 2006		Fiscal Year 2005	
Tax Rate Residential:	10.31	Tax Rate Residential:	10.87	Tax Rate Residential:	
Tax Rate Commercial:	22.35	Tax Rate Commercial:	25.13	Tax Rate Commercial:	
Property Code:	101	Property Code:	101	Property Code:	
Total Bldg Value:	146100	Total Bldg Value:	126400	Total Bldg Value:	
Total Yard Value:	1800	Total Yard Value:	1800	Total Yard Value:	
Total Land Value:	104700	Total Land Value:	111400	Total Land Value:	
Total Parcel Value:	252600	Total Parcel Value:	239600	Total Parcel Value:	
Tax:	2604.31	Tax:	2604.46	Tax:	


Disclaimer: This information is believed to be correct but is subject to change and is not warranted.

style building, built about 1974, having Wood Shingle exterior
unit(s), 5 total room(s), 3 total bedroom(s) 1 total bath(s), 0 3/4 b

Building Value: 146100

Land Value: 104700

Yard Items Value	
1	100
2	200
3	300
100	10000

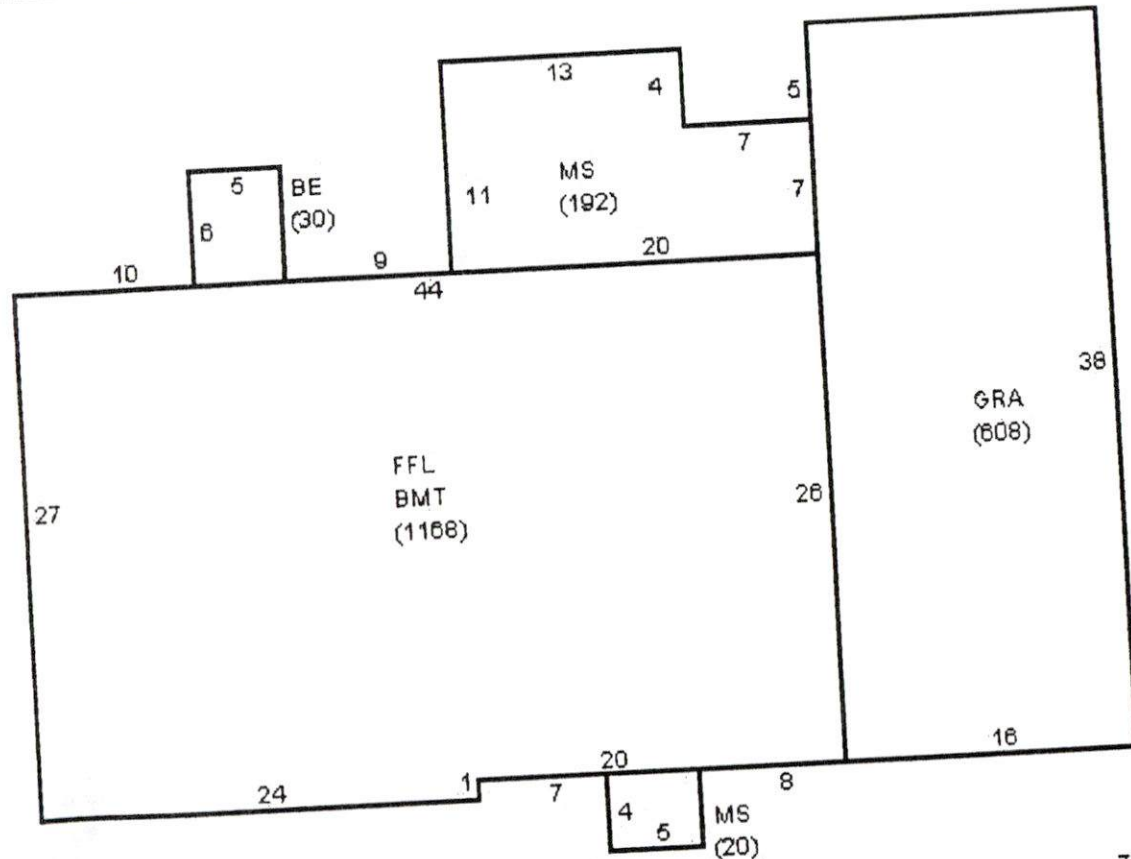**Fiscal Year 2007**

Tax Rate Residential:

10.31

to Commercial.

22.35

Fiscal Year 2006

Tax Rate Residential:

Tax Rate Commercial:



9/7/07

PERMIT NO.

23887

CITY OF NEW BEDFORD
SEWER AND/OR STORM DRAIN PERMIT

DATE 9/7/06

This certifies that permission is granted to

Jose Cruz 1074 Marlboro St NB 508.99.82445
Property Owner Address Tel.

To connect a sewer and/or storm drain located at stub at Marlboro St.

Assessor's Plot 132H Lot 351, to the sewer and/or storm drain in Marlboro Street

To be laid in accordance with the conditions in this application and the City of New Bedford ordinances.

TYPE OF USE: ☒ RESIDENTIAL ☐ COMMERCIAL ☐ INDUSTRIAL ☐ OTHER

If applicant other than actual property owner, attach Letter of Authorization from Property Owner.

Name..... Tel.....

Mailing Address.....

The Bonded Contractor/Drain Layer authorized to perform this work is:

Cardoso Contracting 95R S Main St Acushnet 508.998.5115
Name Address Tel.

Type of Pipe Required: SDR 35 pvc

PERMIT EXPIRES ONE YEAR AFTER DATE OF ISSUE

- Requires separate connections for sewage and storm drain where applicable. Storm water cannot be discharged to a sanitary sewer.
- All work must be inspected and approved by a D.P.I. inspector before backfilling.
- If this connection is to be part of a private service shared jointly with other building owners, attach copy of Recorded Joint Maintenance Agreement.
- Permits can be issued to Industrial and/or Commercial Applicants only upon receipt and approval by the Commissioner of Public Infrastructure of required plans and supplemental information.
- In addition, a City-issued Industrial User Discharge Permit and/or a Sewer Extension/Connection Permit issued by the Commonwealth of Massachusetts D.E.P. shall be required by the City for Industrial Discharge into the sewer system.

Industrial User Discharge Permit No..... Date.....

Comm. Mass. Sewer Conn./Ext. Permit No..... Date.....

A Filing and Inspection Fee of \$450.00 plus an Entrance Fee of \$..... where applicable, must accompany this application.

Bank# Citizens Bank Check# 1080 Date 9/8/06 Receipt# 6624

Other requirements:.....

24 hr inspection notice at 508.979.1527

Connection made to Sewer Part of jointly-shared private line YES NO
Storm Drain

Applicant agrees to abide by the above terms, as well as all pertinent ordinances of the City of New Bedford, and such other special rules as the Commissioner of Public Infrastructure and/or City Engineer may deem necessary

Duarte M. Andrade
Acting City EngineerJose P. Cruz
Signature of Property Owner or Representative

INSPECTOR'S REPORT

INSPECTED BY:.....

DATE:.....

COMMENTS:.....

APPROVED

DISAPPROVED

SIGNATURE

SKETCH PLAN

No
Stub

#1091

#1083

No Stub

BARTLETT STREET

52°/31

EMENT

Ⓢ

539/7

13'

15'

52°/30

15'

439°

#1102

NEW HSE
errandes
er permit

3841

18/06

#1092

#1084

23 882

9/18/06

#1074

23887

9/7/06

"
1" = 40'

52°/29

52°/28

113'

44'

39'

#1

Carol Sherman

From: Sarah Porter
Sent: Thursday, September 07, 2006 6:01 PM
To: Carol Sherman
Subject: RE: SEWER TIE-IN

Carol,

1074 Marlboro is all set - no conservation issues

Thanks

Sarah

-----Original Message-----

From: Carol Sherman
Sent: Thursday, September 07, 2006 9:19 AM
To: Sarah Porter
Subject: SEWER TIE-IN

SARAH

THE PROPERTY OWNER OF 1074 MARLBOROUGH ST. WOULD LIKE TO CONNECT TO OUR SEWER SYSTEM. THE PLOT IS 132 H AND THE LOT IS 351.

MAY WE ISSUE A PERMIT?

THANKS FOR YOUR ASSISTANCE

CAROL

Failed to Health 9-8-06