



PERMIT NO.
23893

CITY OF NEW BEDFORD
SEWER AND/OR STORM DRAIN PERMIT

DATE 9-19-06
Exp. 9-19-07

This certifies that permission is granted to

John L. Carvalho NB. 9925606
Property Owner Address Tel.

To connect a sewer and/or storm drain located at Collette St. #43-45

Assessor's Plot 100 Lot 100, to the sewer and/or storm drain in Street

To be laid in accordance with the conditions in this application and the City of New Bedford ordinances.
TYPE OF USE: RESIDENTIAL COMMERCIAL INDUSTRIAL OTHER 6606PD

If applicant other than actual property owner, attach Letter of Authorization from Property Owner.
Name Tel.

Mailing Address

The Bonded Contractor/Drain Layer authorized to perform this work is: Acushnet

Cardoso Paving & Construction Co. 95 R. So Main St. 508-998-5115
Name Address Tel.

Type of Pipe Required: 6" PUC-SDR 35

PERMIT EXPIRES ONE YEAR AFTER DATE OF ISSUE

- Requires separate connections for sewage and storm drain where applicable. Storm water cannot be discharged to a sanitary sewer.
 - All work must be inspected and approved by a D.P.I. inspector before backfilling.
 - If this connection is to be part of a private service shared jointly with other building owners, attach copy of Recorded Joint Maintenance Agreement.
 - Permits can be issued to Industrial and/or Commercial Applicants only upon receipt and approval by the Commissioner of Public Infrastructure of required plans and supplemental information.
 - In addition, a City-issued Industrial User Discharge Permit and/or a Sewer Extension/Connection Permit issued by the Commonwealth of Massachusetts D.E.P. shall be required by the City for Industrial Discharge into the sewer system.
- Industrial User Discharge Permit No. Date

Comm. Mass. Sewer Conn./Ext. Permit No. Date
A Filing and Inspection Fee of \$150.00 plus an Entrance Fee of \$ where applicable, must accompany this application.

Bank# Bank of America Check# 818 Date 9-19-06 Receipt# 6659

Other requirements: Flowable Fill in Pavement Area
24 HR NOTICE FOR INSPECTION

Connection made to Sewer Part of jointly-shared private line YES NO
Storm Drain


Applicant agrees to abide by the above terms, as well as all pertinent ordinances of the City of New Bedford, and such other special rules as the Commissioner of Public Infrastructure and/or City Engineer may deem necessary

City Engineer Signature of Property Owner or Representative


INSPECTOR'S REPORT

INSPECTED BY: KEVIN CORNELL
DATE: 10-17-06
COMMENTS:

APPROVED DISAPPROVED
Kevin J. Cornell
SIGNATURE

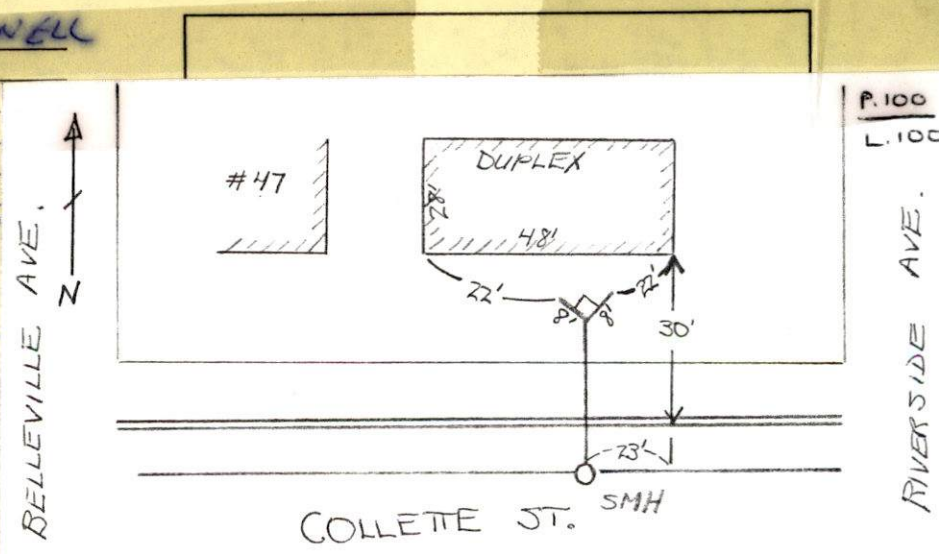

508-998-5115

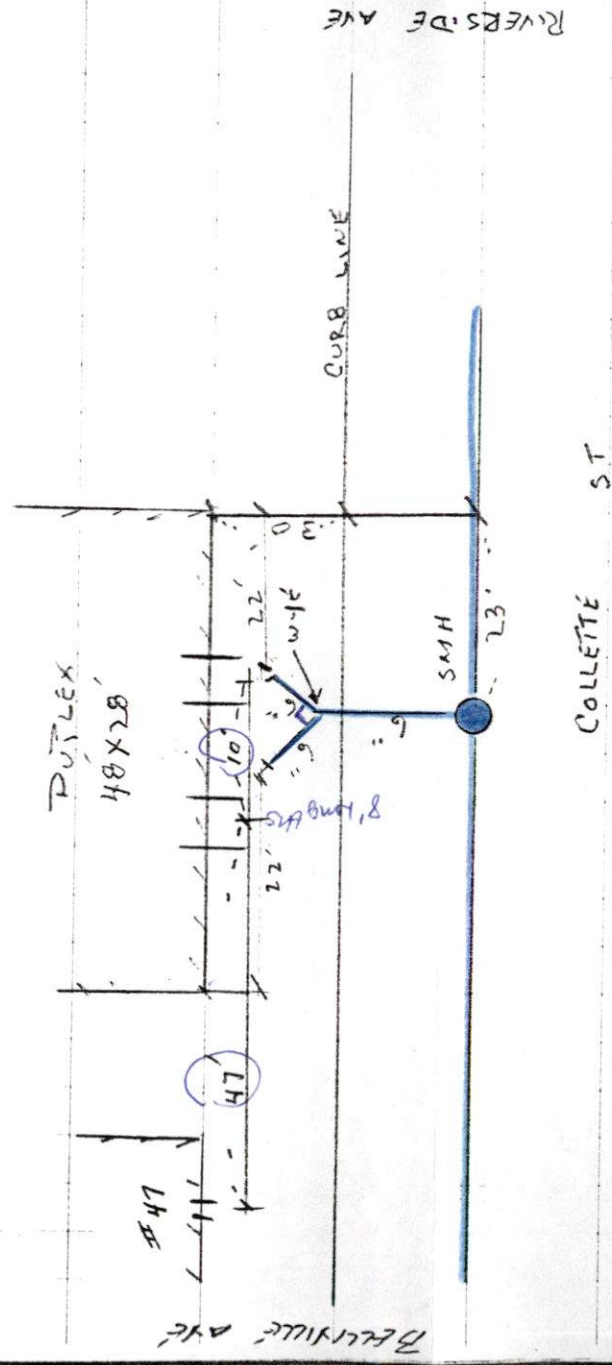



PERMIT NO.

23893

CITY OF NEW BEDFORD
SEWER AND/OR STORM DRAIN PERMIT

DATE

9-19-06
Exp. 9-19-07

This certifies that permission is granted to

John L. Carvalho

Property Owner

Address

N.B.

Tel.

9925606

To connect a sewer and/or storm drain located at

Collette St. #43-45

Assessor's Plot 100 Lot 100

to the sewer and/or storm drain in

Street

To be laid in accordance with the conditions in this application and the City of New Bedford ordinances.

TYPE OF USE:

RESIDENTIAL

COMMERCIAL

INDUSTRIAL

OTHER

6606PD

If applicant other than actual property owner, attach Letter of Authorization from Property Owner.

Name

Tel.

Mailing Address

The Bonded Contractor/Drain Layer authorized to perform this work is:

Cardoso Paving & Construction Co. 95 R. So. Main St. Acushnet 508-998-5115

Name

Address

Tel.

Type of Pipe Required:

6" PVC SDR 35

PERMIT EXPIRES ONE YEAR AFTER DATE OF ISSUE

- Requires separate connections for sewage and storm drain where applicable. Storm water cannot be discharged to a sanitary sewer.
- All work must be inspected and approved by a D.P.I. inspector before backfilling.
- If this connection is to be part of a private service shared jointly with other building owners, attach copy of Recorded Joint Maintenance Agreement.
- Permits can be issued to Industrial and/or Commercial Applicants only upon receipt and approval by the Commissioner of Public Infrastructure of required plans and supplemental information.
- In addition, a City-issued Industrial User Discharge Permit and/or a Sewer Extension/Connection Permit issued by the Commonwealth of Massachusetts D.E.P. shall be required by the City for Industrial Discharge into the sewer system.

Industrial User Discharge Permit No. Date

Comm. Mass. Sewer Conn./Ext. Permit No. Date

A Filing and Inspection Fee of \$150.00, plus an Entrance Fee of \$ where applicable, must accompany this application.

Bank# Bank of America Check# 818 Date 9-19-06 Receipt# 6659

Other requirements: Flowable Fill in Pavement Area

24 HR Notice for Inspection

Connection made to Sewer

Part of jointly-shared private line

YES

NO

Storm Drain

Applicant agrees to abide by the above terms, as well as all pertinent ordinances of the City of New Bedford, and such other special rules as the Commissioner of Public Infrastructure and/or City Engineer may deem necessary

Acting - City Engineer

John L. Carvalho
Signature of Property Owner or Representative

INSPECTOR'S REPORT

INSPECTED BY:

DATE:

COMMENTS:

APPROVED

DISAPPROVED

SIGNATURE

SKETCH PLAN

