



PERMIT NO.  
23898

CITY OF NEW BEDFORD  
SEWER AND/OR STORM DRAIN PERMIT

DATE 9/22/06

This certifies that permission is granted to

JOSE M. FERRO 1057 MARLBORO ST 508-998-8227  
Property Owner Address Tel.

To connect a sewer and/or storm drain located at 1057 MARLBORO ST

Assessor's Plot 132H Lot 205, to the sewer and/or storm drain in MARLBORO SHEFFIELD Street  
(see sketch)

To be laid in accordance with the conditions in this application and the City of New Bedford ordinances.

TYPE OF USE: RESIDENTIAL COMMERCIAL INDUSTRIAL OTHER

330 GPD

If applicant other than actual property owner, attach Letter of Authorization from Property Owner.

Name Tel.

Mailing Address

The Bonded Contractor/Drain Layer authorized to perform this work is:

MENARD BROS 307 COUNTY RD W. WAREHAM 508-995-4422  
Name Address Tel.

Type of Pipe Required: PVC SDR 35

PERMIT EXPIRES ONE YEAR AFTER DATE OF ISSUE

- Requires separate connections for sewage and storm drain where applicable. Storm water cannot be discharged to a sanitary sewer.
- All work must be inspected and approved by a D.P.I. inspector before backfilling.
- If this connection is to be part of a private service shared jointly with other building owners, attach copy of Recorded Joint Maintenance Agreement.
- Permits can be issued to Industrial and/or Commercial Applicants only upon receipt and approval by the Commissioner of Public Infrastructure of required plans and supplemental information.
- In addition, a City-issued Industrial User Discharge Permit and/or a Sewer Extension/Connection Permit issued by the Commonwealth of Massachusetts D.E.P. shall be required by the City for Industrial Discharge into the sewer system.

Industrial User Discharge Permit No. Date

Comm. Mass. Sewer Conn./Ext. Permit No. Date

A Filing and Inspection Fee of \$150.00, plus an Entrance Fee of \$... where applicable, must accompany this application.

Bank# WEBSTER BANK Check# 1521 Date 9-22-06 Receipt# 6677

Other requirements: INSP ONLY - CONNECT TO 8" SEWER 24 HRS NOTICE FOR ALL

INSPECTIONS. FLOWABLE FILL REQUIRED IN ALL TRENCHES

Connection made to Sewer Part of jointly-shared private line YES NO  
Storm Drain

Applicant agrees to abide by the above terms, as well as all pertinent ordinances of the City of New Bedford, and such other special rules as the Commissioner of Public Infrastructure and/or City Engineer may deem necessary

ACTING City Engineer Signature of Property Owner or Representative

INSPECTOR'S REPORT

INSPECTED BY: KEVIN CORNELL


DATE: 10-04-06

COMMENTS:


APPROVED

DISAPPROVED

Kevin J. Cornell  
SIGNATURE

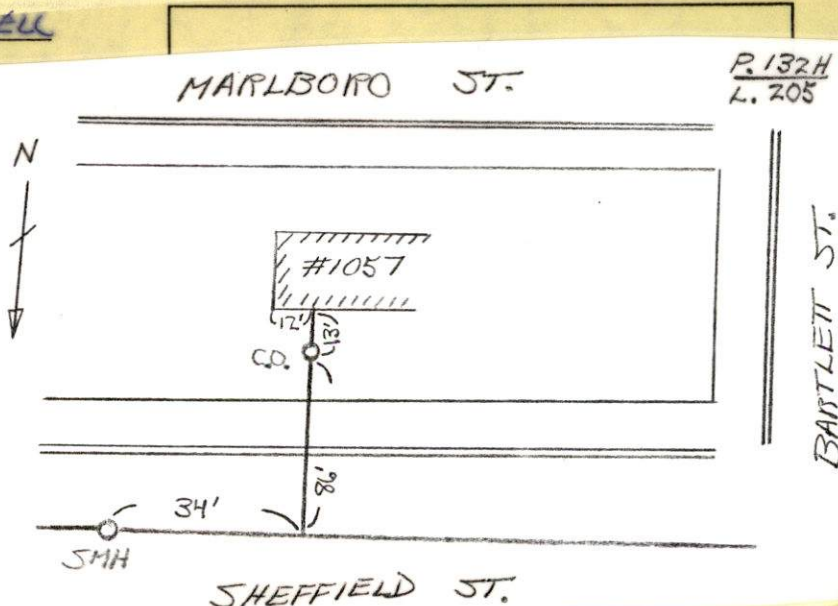



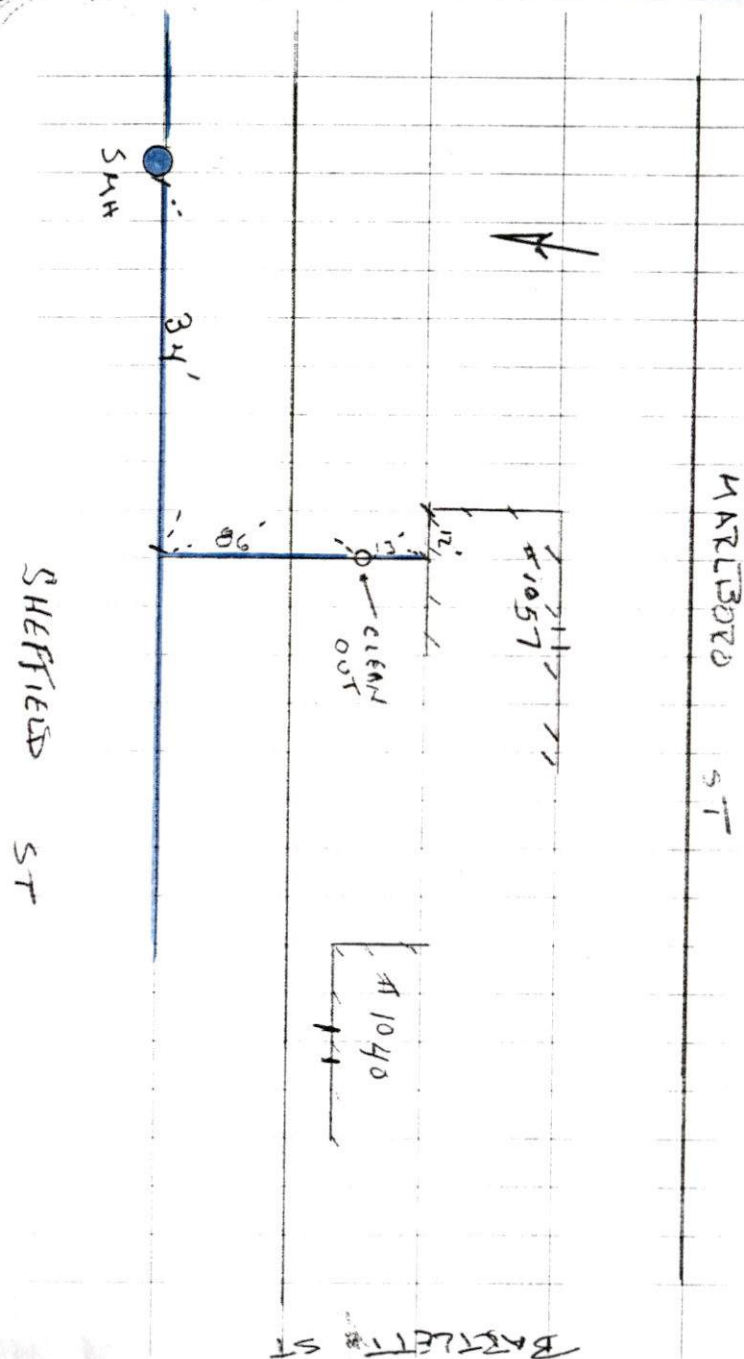

CLOUDY 65°  
10-19-06 THURSDAY

#1057 MARLBORO ST

PERMIT # 23898

CONTRACTOR - MENARD BRO  
508-995-4022

# City of New Bedford ~ Real Property On-Line ASSESSOR'S OFFICE

<b>Location:</b> 1057 MARLBORO ST		<b>Parcel ID:</b> 132H 205	<b>Zoning:</b> 2RB	<b>Fiscal Year:</b> 2007																																																
<b>Current Owner Information:</b> FERRO JOSE M FERRO ANA DEJESUS 1057 MARLBORO ST NEW BEDFORD, MA 02745		<b>Current Sales Information:</b> <b>Sale Date:</b> 7/30/1991 <b>Sale Price:</b> 90000 <b>Legal Reference:</b> 2674-63 <b>Grantor:</b> ARBEC LEO R		Enter card number to view Card 1 of 1 <input type="text"/> <input type="button" value="Go"/> <input type="button" value="New Search"/>																																																
This Property contains 0.390 acres of land mainly classified as Single Family with a(n) RANCH style building, built about 1947, having Stucco exterior and Asphalt roof cover, with 1 unit(s), 6 total room(s), 3 total bedroom(s) 1 total bath(s), 0 3/4 baths, and 0 total half bath(s).																																																				
<b>Building Value:</b> 133500		<b>Land Value:</b> 169700	<b>Yard Items Value:</b> 500	<b>Total Value:</b> 303700																																																
<b>Fiscal Year 2007</b> <table border="1"> <tr><td>Tax Rate Residential:</td><td>10.31</td></tr> <tr><td>Tax Rate Commercial:</td><td>22.35</td></tr> <tr><td>Property Code:</td><td>101</td></tr> <tr><td>Total Bldg Value:</td><td>133500</td></tr> <tr><td>Total Yard Value:</td><td>500</td></tr> <tr><td>Total Land Value:</td><td>169700</td></tr> <tr><td>Total Parcel Value:</td><td>303700</td></tr> <tr><td>Tax:</td><td>3131.16</td></tr> </table>		Tax Rate Residential:	10.31	Tax Rate Commercial:	22.35	Property Code:	101	Total Bldg Value:	133500	Total Yard Value:	500	Total Land Value:	169700	Total Parcel Value:	303700	Tax:	3131.16	<b>Fiscal Year 2006</b> <table border="1"> <tr><td>Tax Rate Residential:</td><td>10.87</td></tr> <tr><td>Tax Rate Commercial:</td><td>25.13</td></tr> <tr><td>Property Code:</td><td>101</td></tr> <tr><td>Total Bldg Value:</td><td>105600</td></tr> <tr><td>Total Yard Value:</td><td>500</td></tr> <tr><td>Total Land Value:</td><td>187400</td></tr> <tr><td>Total Parcel Value:</td><td>293500</td></tr> <tr><td>Tax:</td><td>3190.35</td></tr> </table>		Tax Rate Residential:	10.87	Tax Rate Commercial:	25.13	Property Code:	101	Total Bldg Value:	105600	Total Yard Value:	500	Total Land Value:	187400	Total Parcel Value:	293500	Tax:	3190.35	<b>Fiscal Year 2005</b> <table border="1"> <tr><td>Tax Rate Residential:</td><td></td></tr> <tr><td>Tax Rate Commercial:</td><td></td></tr> <tr><td>Property Code:</td><td></td></tr> <tr><td>Total Bldg Value:</td><td></td></tr> <tr><td>Total Yard Value:</td><td></td></tr> <tr><td>Total Land Value:</td><td></td></tr> <tr><td>Total Parcel Value:</td><td></td></tr> <tr><td>Tax:</td><td></td></tr> </table>	Tax Rate Residential:		Tax Rate Commercial:		Property Code:		Total Bldg Value:		Total Yard Value:		Total Land Value:		Total Parcel Value:		Tax:	
Tax Rate Residential:	10.31																																																			
Tax Rate Commercial:	22.35																																																			
Property Code:	101																																																			
Total Bldg Value:	133500																																																			
Total Yard Value:	500																																																			
Total Land Value:	169700																																																			
Total Parcel Value:	303700																																																			
Tax:	3131.16																																																			
Tax Rate Residential:	10.87																																																			
Tax Rate Commercial:	25.13																																																			
Property Code:	101																																																			
Total Bldg Value:	105600																																																			
Total Yard Value:	500																																																			
Total Land Value:	187400																																																			
Total Parcel Value:	293500																																																			
Tax:	3190.35																																																			
Tax Rate Residential:																																																				
Tax Rate Commercial:																																																				
Property Code:																																																				
Total Bldg Value:																																																				
Total Yard Value:																																																				
Total Land Value:																																																				
Total Parcel Value:																																																				
Tax:																																																				



Disclaimer: This information is believed to be correct but is subject to change and is not warranted.

This Property contains 0.390 acres of land mainly classified as  
 style building, built about 1947, having Stucco exterior and As  
 6 total room(s), 3 total bedroom(s) 1 total bath(s), 0 3/4 baths, a

**Building Value:** 133500

**Land Value:** 169700

**Yard Items Val**

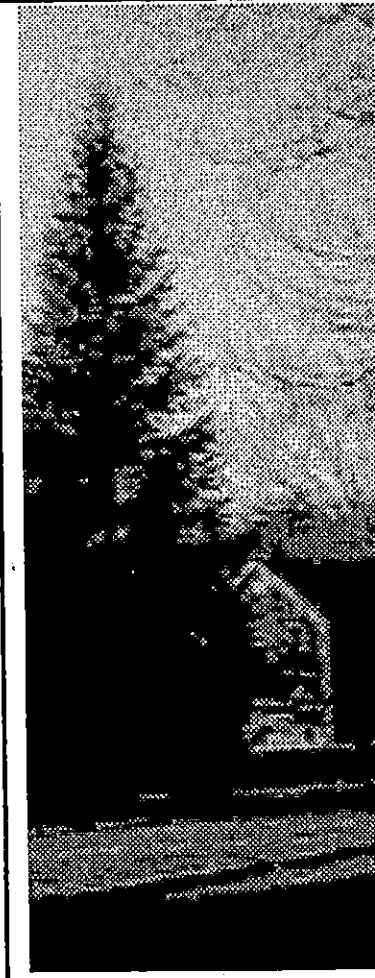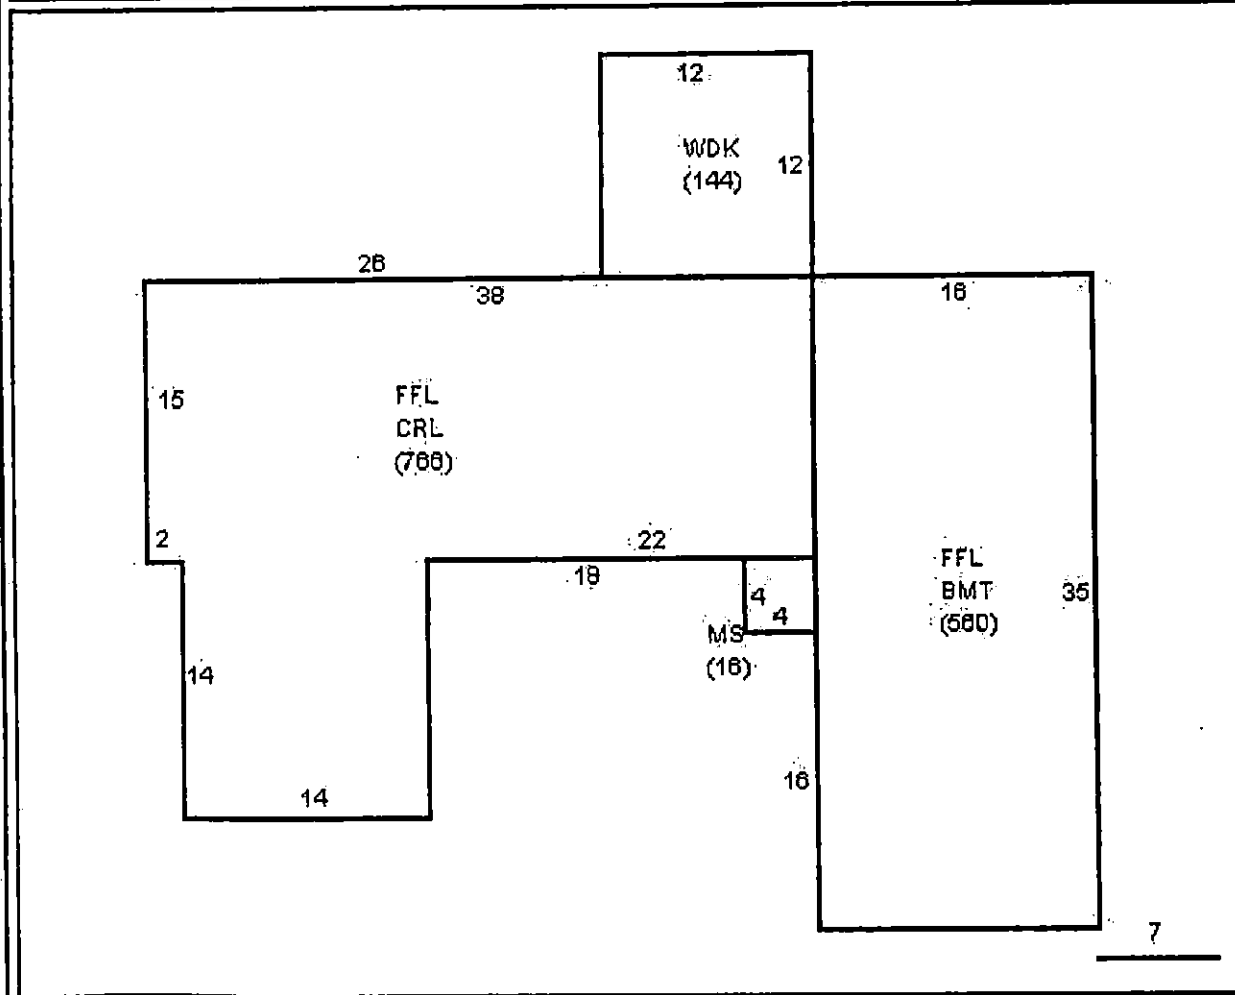

**Fiscal Year 2007**

**Fiscal Year 2006**

Tax Date Residential:

10 31

Tax Date Residential:

10





PERMIT NO.  
**23898**

CITY OF NEW BEDFORD  
SEWER AND/OR STORM DRAIN PERMIT

DATE 9/22/06

This certifies that permission is granted to

JOSE M. FERRO 1057 MARLBORO ST 508-998-8227  
Property Owner Address Tel.

To connect a sewer and/or storm drain located at 1057 MARLBORO ST

Assessor's Plot 132H Lot 205, to the sewer and/or storm drain in MARLBORO Street

To be laid in accordance with the conditions in this application and the City of New Bedford ordinances.

TYPE OF USE: RESIDENTIAL COMMERCIAL INDUSTRIAL OTHER

330 CPD

If applicant other than actual property owner, attach Letter of Authorization from Property Owner.

Name..... Tel.....

Mailing Address.....

The Bonded Contractor/Drain Layer authorized to perform this work is:

MENARD BROS 307 COUNTY RD W. WAREHAM 508-995-4022  
Name Address Tel.

Type of Pipe Required: PVC SDR 35

PERMIT EXPIRES ONE YEAR AFTER DATE OF ISSUE

- Requires separate connections for sewage and storm drain where applicable. Storm water cannot be discharged to a sanitary sewer.
- All work must be inspected and approved by a D.P.I. inspector before backfilling.
- If this connection is to be part of a private service shared jointly with other building owners, attach copy of Recorded Joint Maintenance Agreement.
- Permits can be issued to Industrial and/or Commercial Applicants only upon receipt and approval by the Commissioner of Public Infrastructure of required plans and supplemental information.
- In addition, a City-issued Industrial User Discharge Permit and/or a Sewer Extension/Connection Permit issued by the Commonwealth of Massachusetts D.E.P. shall be required by the City for Industrial Discharge into the sewer system.

Industrial User Discharge Permit No..... Date.....

Comm. Mass. Sewer Conn./Ext. Permit No..... Date.....

A Filing and Inspection Fee of \$ 150.00, plus an Entrance Fee of \$ 25.00 where applicable, must accompany this application.

Bank# WEBSTER BANK Check# 1521 Date 9-22-06 Receipt# 6677

Other requirements: INSP ONLY - CONNECT TO 8" SEWER 24 HRS NOTICE FOR ALL

INSPECTIONS FLOWABLE FILL REQUIRED IN ALL TRENCHES

Connection made to Sewer Part of jointly-shared private line YES NO  
Storm Drain

Applicant agrees to abide by the above terms, as well as all pertinent ordinances of the City of New Bedford, and such other special rules as the Commissioner of Public Infrastructure and/or City Engineer may deem necessary

Quentin M. Andrade  
ACTING City Engineer

Jose M. Ferro  
Signature of Property Owner or Representative

INSPECTOR'S REPORT

INSPECTED BY: \_\_\_\_\_


DATE: \_\_\_\_\_

COMMENTS: \_\_\_\_\_

APPROVED

DISAPPROVED

SIGNATURE

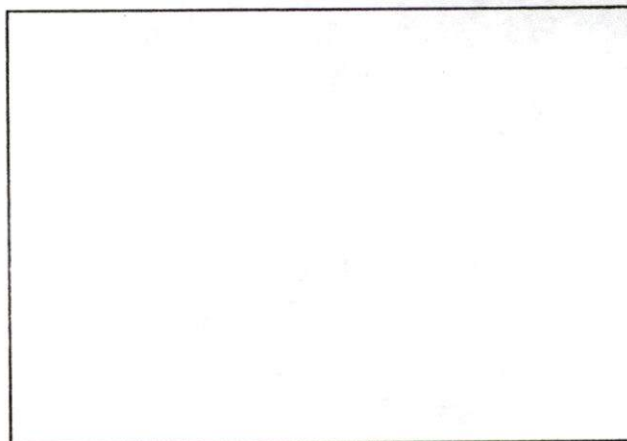

SKETCH PLAN

## Carol Sherman

---

**From:** Sarah Porter  
**Sent:** Friday, September 22, 2006 3:58 PM  
**To:** Carol Sherman  
**Subject:** RE: SEWER TIE-IN

all set  
thank you

-----Original Message-----

**From:** Carol Sherman  
**Sent:** Friday, September 22, 2006 1:22 PM  
**To:** Sarah Porter  
**Subject:** SEWER TIE-IN

SARAH  
THE PROPERTY OWNER OF 1057 MARLBORO ST. WOULD LIKE TO CONNECT TO OUR SEWER SYSTEM.  
THE PLOT IS 132 H AND THE LOT IS 205.

MAY WE ISSUE A PERMIT?

THANKS FOR YOUR ASSISTANCE.

CAROL

TRANSMISSION VERIFICATION REPORT

TIME : 09/25/2006 07:37  
NAME : DPI WATER WASTEWATER  
FAX : 5089916152  
TEL : 5089916152

DATE, TIME	09/25 07:36
FAX NO./NAME	3143
DURATION	00:00:48
PAGE(S)	01
RESULT	OK
MODE	STANDARD ECM

9/25/06 Failed to many / health.