



PERMIT NO.
23905

CITY OF NEW BEDFORD
SEWER AND/OR STORM DRAIN PERMIT

DATE 10/23/06

This certifies that permission is granted to

Helen M. Woodis 1365 Bartlett St. NB 508 995 9952
Property Owner Address Tel.

To connect a sewer and/or storm drain located at stub at prop line

Assessor's Plot 134 Lot 299, to the sewer and/or storm drain in Bartlett Street

To be laid in accordance with the conditions in this application and the City of New Bedford ordinances.

TYPE OF USE: ☒ RESIDENTIAL ☐ COMMERCIAL ☐ INDUSTRIAL ☐ OTHER 220 gpd

If applicant other than actual property owner, attach Letter of Authorization from Property Owner.

Name Mailing Address Tel.

The Bonded Contractor/Drain Layer authorized to perform this work is:

August Backhoe Service 345 Bridge St. Fairhaven 508 996 3599
Name Address Tel.

Type of Pipe Required: PVC SDR 35

PERMIT EXPIRES ONE YEAR AFTER DATE OF ISSUE owner to pay for stub connection and assessment fee once it has been determined by City

- Requires separate connections for sewage and storm drain where applicable. Storm water cannot be discharged to a sanitary sewer.
- All work must be inspected and approved by a D.P.I. inspector before backfilling.
- If this connection is to be part of a private service shared jointly with other building owners, attach copy of Recorded Joint Maintenance Agreement.
- Permits can be issued to Industrial and/or Commercial Applicants only upon receipt and approval by the Commissioner of Public Infrastructure of required plans and supplemental information.
- In addition, a City-issued Industrial User Discharge Permit and/or a Sewer Extension/Connection Permit issued by the Commonwealth of Massachusetts D.E.P. shall be required by the City for Industrial Discharge into the sewer system.

Industrial User Discharge Permit No. Date

Comm. Mass. Sewer Conn./Ext. Permit No. Date

A Filing and Inspection Fee of \$150.00 plus an Entrance Fee of \$ where applicable, must accompany this application.

Bank# Webster Bank Check# 1599 Date 10/23/06 Receipt# 6186

Other requirements: 24 hr. inspection notice at 508-999-1527

Connection made to ☒ Sewer ☐ Storm Drain Part of jointly-shared private line YES ☒ NO

Applicant agrees to abide by the above terms, as well as all pertinent ordinances of the City of New Bedford, and such other special rules as the Commissioner of Public Infrastructure and/or City Engineer may deem necessary

Duarte M. Andradef
Acting City Engineer mn


Helen M. Woodis
Signature of Property Owner or Representative

INSPECTOR'S REPORT

INSPECTED BY: KEVIN CORNEU
DATE: 11-14-06
COMMENTS:

☒ APPROVED ☐ DISAPPROVED

Kevin J. Corneu
SIGNATURE

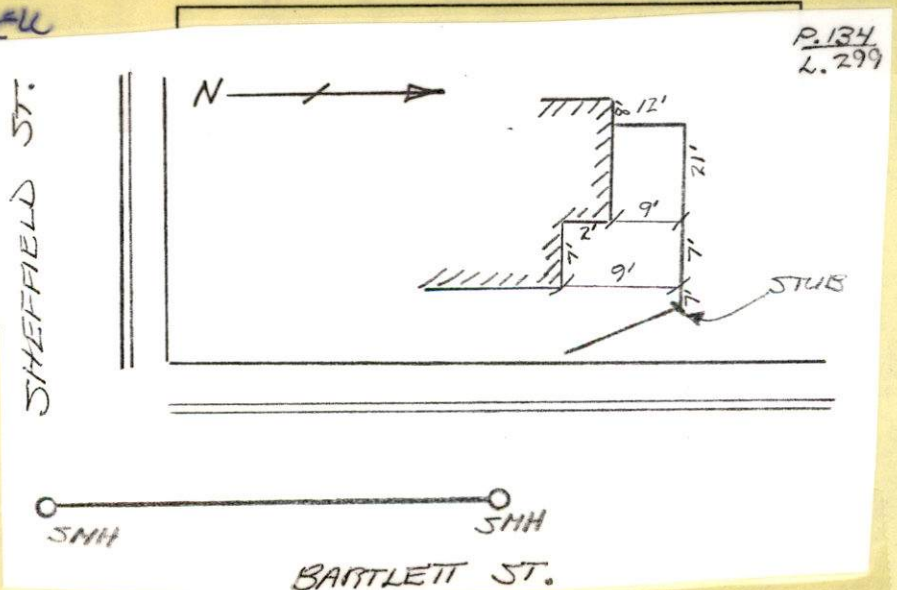


cloudy 5:30
11-14-86 /UES

#1265 BARTLETT ST

PERMIT #23905

CONTRACTOR - JOE ABUST
508-996-3599

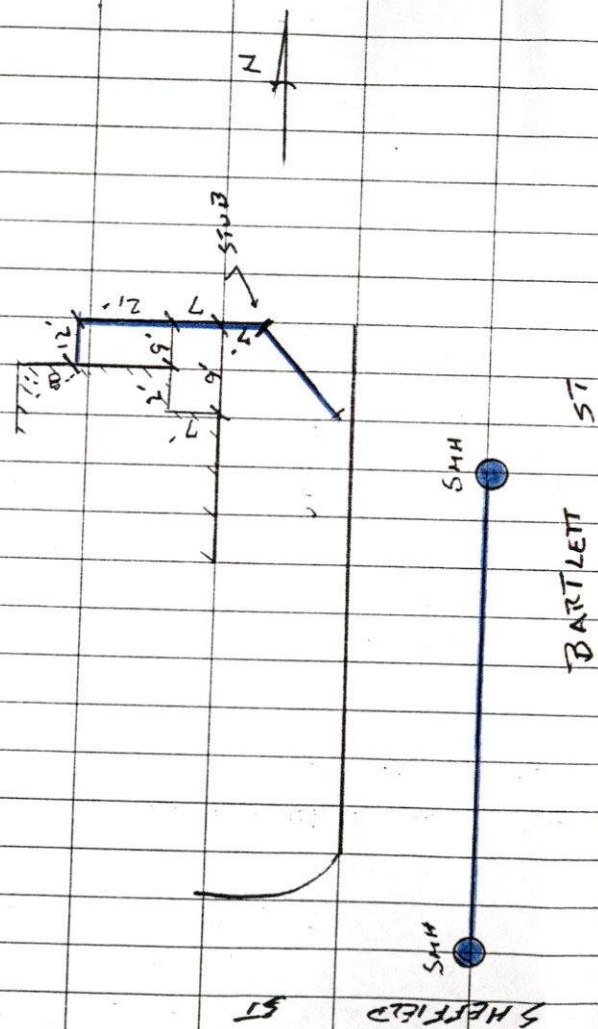


cod style building, built about 1925, having wood Shingle ex
with 1 unit(s), 4 total room(s), 2 total bedroom(s) 1 total bath
bath(s).

Building Value: 51700

Land Value: 172300

Yard Items Va

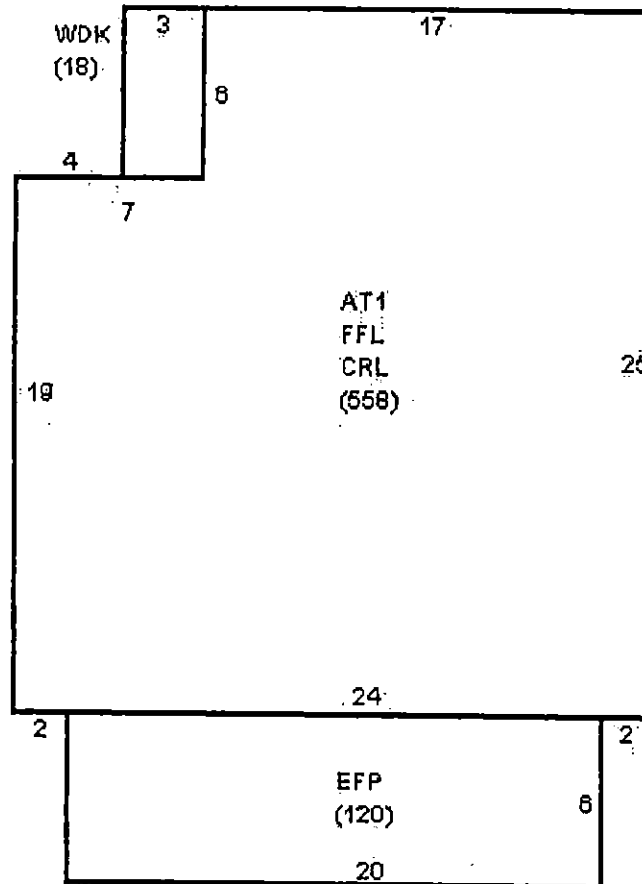

Fiscal Year 2007

Tax Rate Residential:

10.31

Tax Rate Commercial:

22.25

Fiscal Year 2006

Tax Rate Residential:

1

Tax Rate Commercial:

22

City of New Bedford ~ Real Property On-Line ASSESSOR'S OFFICE

Location: 1265 BARTLETT ST		Parcel ID: 134 299	Zoning: 2RA	Fiscal Year: 2007																																																
Current Owner Information: WOODIS HELEN M 1265 BARTLETT STREET NEW BEDFORD, MA 02745		Current Sales Information: Sale Date: 1/9/1998 Sale Price: 100 Legal Reference: 4022-317 Grantor: WOODIS HELEN M,		Enter card number to view Card 1 of 1 <input type="text"/> <input type="button" value="Go"/> <input type="button" value="New Search"/>																																																
This Property contains 1.178 acres of land mainly classified as Single Family with a(n) Cape cod style building, built about 1925, having Wood Shingle exterior and Asphalt roof cover, with 1 unit(s), 4 total room(s), 2 total bedroom(s) 1 total bath(s), 0 3/4 baths, and 0 total half bath(s).																																																				
Building Value: 51700		Land Value: 172300	Yard Items Value: 4400	Total Value: 228400																																																
Fiscal Year 2007 <table border="1"> <tr><td>Tax Rate Residential:</td><td>10.31</td></tr> <tr><td>Tax Rate Commercial:</td><td>22.35</td></tr> <tr><td>Property Code:</td><td>101</td></tr> <tr><td>Total Bldg Value:</td><td>51700</td></tr> <tr><td>Total Yard Value:</td><td>4400</td></tr> <tr><td>Total Land Value:</td><td>172300</td></tr> <tr><td>Total Parcel Value:</td><td>228400</td></tr> <tr><td>Tax:</td><td>2354.8</td></tr> </table>		Tax Rate Residential:	10.31	Tax Rate Commercial:	22.35	Property Code:	101	Total Bldg Value:	51700	Total Yard Value:	4400	Total Land Value:	172300	Total Parcel Value:	228400	Tax:	2354.8	Fiscal Year 2006 <table border="1"> <tr><td>Tax Rate Residential:</td><td>10.87</td></tr> <tr><td>Tax Rate Commercial:</td><td>25.13</td></tr> <tr><td>Property Code:</td><td>101</td></tr> <tr><td>Total Bldg Value:</td><td>46800</td></tr> <tr><td>Total Yard Value:</td><td>3600</td></tr> <tr><td>Total Land Value:</td><td>178800</td></tr> <tr><td>Total Parcel Value:</td><td>229200</td></tr> <tr><td>Tax:</td><td>2491.41</td></tr> </table>		Tax Rate Residential:	10.87	Tax Rate Commercial:	25.13	Property Code:	101	Total Bldg Value:	46800	Total Yard Value:	3600	Total Land Value:	178800	Total Parcel Value:	229200	Tax:	2491.41	Fiscal Year 2005 <table border="1"> <tr><td>Tax Rate Residential:</td><td></td></tr> <tr><td>Tax Rate Commercial:</td><td></td></tr> <tr><td>Property Code:</td><td></td></tr> <tr><td>Total Bldg Value:</td><td></td></tr> <tr><td>Total Yard Value:</td><td></td></tr> <tr><td>Total Land Value:</td><td></td></tr> <tr><td>Total Parcel Value:</td><td></td></tr> <tr><td>Tax:</td><td></td></tr> </table>	Tax Rate Residential:		Tax Rate Commercial:		Property Code:		Total Bldg Value:		Total Yard Value:		Total Land Value:		Total Parcel Value:		Tax:	
Tax Rate Residential:	10.31																																																			
Tax Rate Commercial:	22.35																																																			
Property Code:	101																																																			
Total Bldg Value:	51700																																																			
Total Yard Value:	4400																																																			
Total Land Value:	172300																																																			
Total Parcel Value:	228400																																																			
Tax:	2354.8																																																			
Tax Rate Residential:	10.87																																																			
Tax Rate Commercial:	25.13																																																			
Property Code:	101																																																			
Total Bldg Value:	46800																																																			
Total Yard Value:	3600																																																			
Total Land Value:	178800																																																			
Total Parcel Value:	229200																																																			
Tax:	2491.41																																																			
Tax Rate Residential:																																																				
Tax Rate Commercial:																																																				
Property Code:																																																				
Total Bldg Value:																																																				
Total Yard Value:																																																				
Total Land Value:																																																				
Total Parcel Value:																																																				
Tax:																																																				

Disclaimer: This information is believed to be correct but is subject to change and is not warranted.



PERMIT NO.

23905

CITY OF NEW BEDFORD
SEWER AND/OR STORM DRAIN PERMIT

DATE 10/23/06

This certifies that permission is granted to

Helen M. Woodis 1265 Bartlett St. NB 508.995.9952
Property Owner Address Tel.

To connect a sewer and/or storm drain located at stub at prop line

Assessor's Plot 134 Lot 299, to the sewer and/or storm drain in Bartlett Street

To be laid in accordance with the conditions in this application and the City of New Bedford ordinances.

TYPE OF USE: RESIDENTIAL COMMERCIAL INDUSTRIAL OTHER 200 gpd

If applicant other than actual property owner, attach Letter of Authorization from Property Owner.

Name Tel.

Mailing Address

The Bonded Contractor/Drain Layer authorized to perform this work is:

August Backhoe Service 345 Bridge St. Fairhaven 508.996.3599
Name Address Tel.

Type of Pipe Required: PVC SDR 35

PERMIT EXPIRES ONE YEAR AFTER DATE OF ISSUE

owner to pay for stub connection and assessment fee once it has been determined by City

- Requires separate connections for sewage and storm drain where applicable. Storm water cannot be discharged to a sanitary sewer.
- All work must be inspected and approved by a D.P.I. inspector before backfilling.
- If this connection is to be part of a private service shared jointly with other building owners, attach copy of Recorded Joint Maintenance Agreement.
- Permits can be issued to Industrial and/or Commercial Applicants only upon receipt and approval by the Commissioner of Public Infrastructure of required plans and supplemental information.
- In addition, a City-issued Industrial User Discharge Permit and/or a Sewer Extension/Connection Permit issued by the Commonwealth of Massachusetts D.E.P. shall be required by the City for Industrial Discharge into the sewer system.

Industrial User Discharge Permit No. Date

Comm. Mass. Sewer Conn./Ext. Permit No. Date

A Filing and Inspection Fee of \$150.00 plus an Entrance Fee of \$7.00 where applicable, must accompany this application.

Bank# Webster Bank Check# 1599 Date 10/23/06 Receipt# 6186

Other requirements: 24 hr. inspection notice at 508-979-1527

Connection made to Sewer Part of jointly-shared private line YES NO
Storm Drain

Applicant agrees to abide by the above terms, as well as all pertinent ordinances of the City of New Bedford, and such other special rules as the Commissioner of Public Infrastructure and/or City Engineer may deem necessary

Quarte M. Andrade Acting City Engineer mn


Helen M. Woodis Signature of Property Owner or Representative

INSPECTOR'S REPORT

INSPECTED BY: DATE: COMMENTS:

APPROVED DISAPPROVED

SIGNATURE

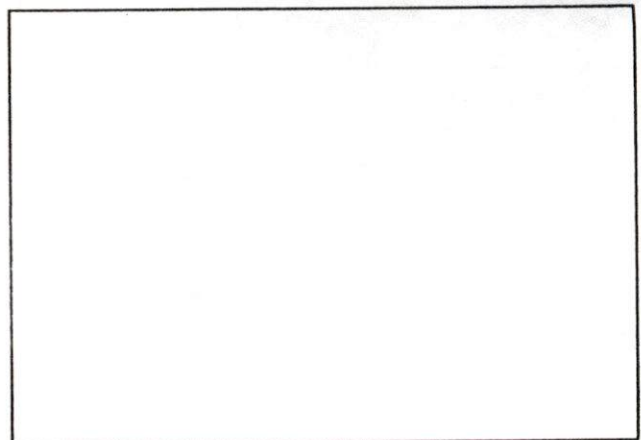

SKETCH PLAN

Mary T. Neves

From: Sarah Porter
Sent: Monday, October 23, 2006 5:11 PM
To: Mary T. Neves
Subject: RE: SEWER TIE IN

OK by me thank you Mary

-----Original Message-----

From: Mary T. Neves
Sent: Monday, October 23, 2006 2:36 PM
To: Sarah Porter
Subject: SEWER TIE IN

Hi Sarah,

The property owner of 1265 Bartlett Street wants to tie into the stub at the property line.

The plot is 134 and the lot is 299.

May I issue this permit?

Thanks