



PERMIT NO.  
23908

CITY OF NEW BEDFORD  
SEWER AND/OR STORM DRAIN PERMIT

DATE 10/30/06

This certifies that permission is granted to

Michael Rymaszewicz 1014 Almy St. NB 508.995.3404  
Property Owner Address Tel. 508.9916133 work

To connect a sewer and/or storm drain located at stub at property line - 2" force main

Assessor's Plot 134 Lot 122, to the sewer and/or storm drain in Almy Street

To be laid in accordance with the conditions in this application and the City of New Bedford ordinances.

TYPE OF USE: ☒ RESIDENTIAL ☐ COMMERCIAL ☐ INDUSTRIAL ☐ OTHER 3309pd

If applicant other than actual property owner, attach Letter of Authorization from Property Owner.

Name Tel.

Mailing Address

The Bonded Contractor/Drain Layer authorized to perform this work is:

R.J. Lussier P.O. Box 51643 NB 508.763.4827

Name Address Tel.

Type of Pipe Required: sdr pipe 12" pipe

PERMIT EXPIRES ONE YEAR AFTER DATE OF ISSUE

- Requires separate connections for sewage and storm drain where applicable. Storm water cannot be discharged to a sanitary sewer.
  - All work must be inspected and approved by a D.P.I. inspector before backfilling.
  - If this connection is to be part of a private service shared jointly with other building owners, attach copy of Recorded Joint Maintenance Agreement.
  - Permits can be issued to Industrial and/or Commercial Applicants only upon receipt and approval by the Commissioner of Public Infrastructure of required plans and supplemental information.
  - In addition, a City-issued Industrial User Discharge Permit and/or a Sewer Extension/Connection Permit issued by the Commonwealth of Massachusetts D.E.P. shall be required by the City for Industrial Discharge into the sewer system.
- Industrial User Discharge Permit No. Date.

Comm. Mass. Sewer Conn./Ext. Permit No. Date.

A Filing and Inspection Fee of \$150.00 plus an Entrance Fee of \$ where applicable, must accompany this application.

Bank# Webster Check# 1750 Date 10/30/06 Receipt# 6203

Other requirements: 24 hr. inspection notice at 508.979.527

Connection made to Sewer Part of jointly-shared private line YES ☒ NO  
Storm Drain

Applicant agrees to abide by the above terms, as well as all pertinent ordinances of the City of New Bedford, and such other special rules as the Commissioner of Public Infrastructure and/or City Engineer may deem necessary

Duarte M. Andrade Acting City Engineer mn


Michael Rymaszewicz Signature of Property Owner or Representative

INSPECTOR'S REPORT

INSPECTED BY: KEVIN CORWELL  
DATE: 11-03-06  
COMMENTS:

☒ APPROVED ☐ DISAPPROVE

Kevin J. Corwell  
SIGNATURE

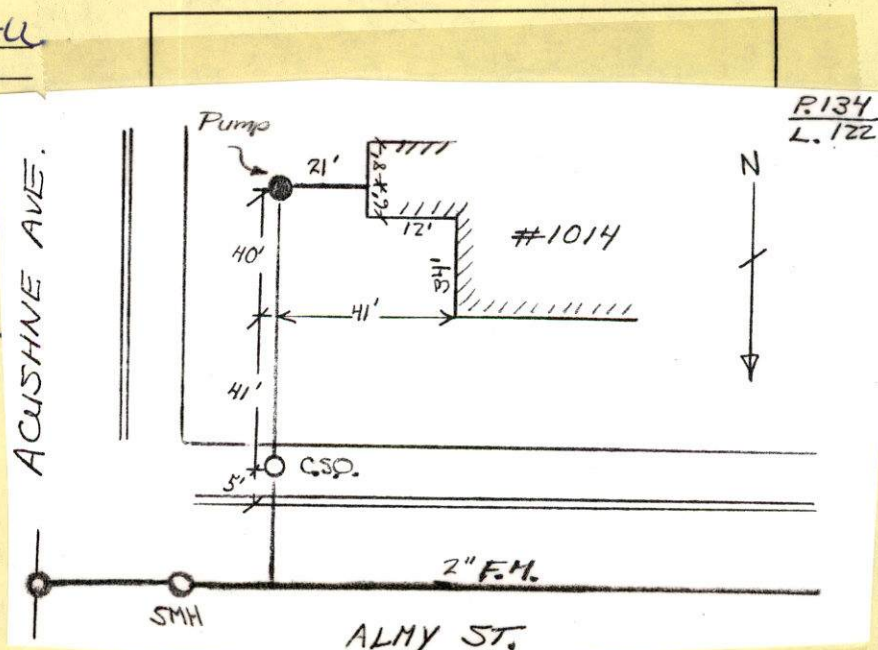



SUNNY 45°  
FRIDAY 11-03-06 (25)

#1014 ALMY ST-FORCE MAIN

PERMIT # 23908

CONTRACTOR R.J. CANESSA  
508-763-4827

ACUSHNET AVE


SMH

SMH

1" FORCE MAIN

ALMY

ST

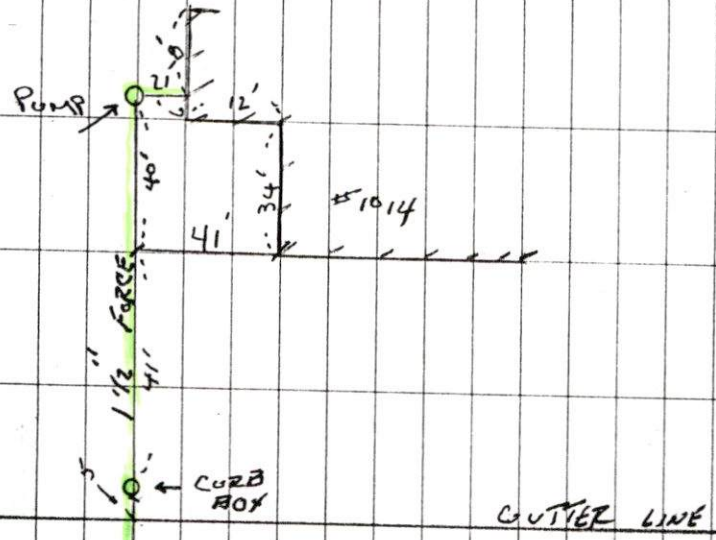


This Property contains 0.138 acres of land mainly classified as Single family detached building, built about 1950, having Wood Shingle exterior with 1 unit(s), 6 total room(s), 3 total bedroom(s) 1 total bath(s), 1 total bath(s).

Building Value: 100100

Land Value: 62200

Yard Items Value:

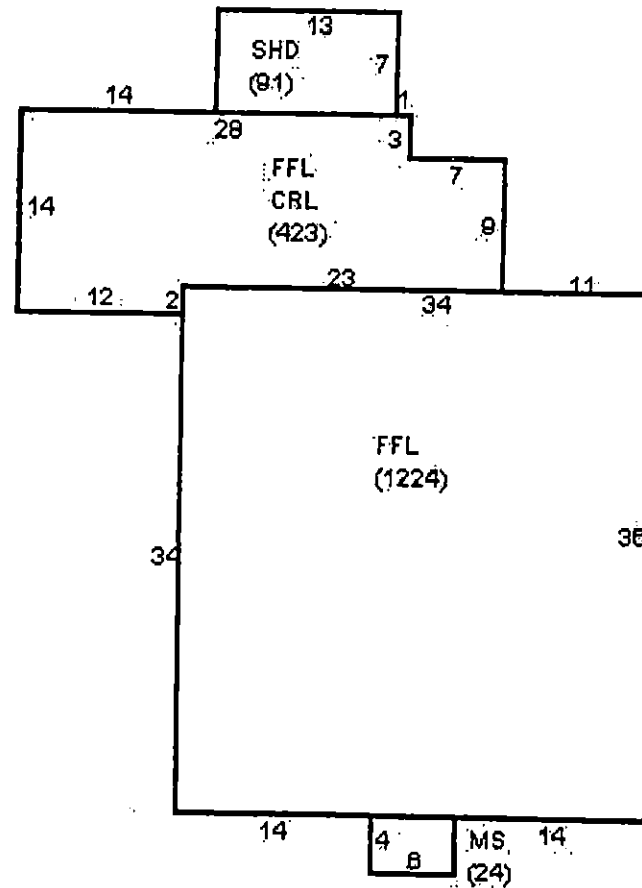

Fiscal Year 2007

Fiscal Year 2006

# City of New Bedford ~ Real Property On-Line ASSESSOR'S OFFICE

<b>Location:</b> 1014 ALMY ST		<b>Parcel ID:</b> 134 122	<b>Zoning:</b> 2RA	<b>Fiscal Year:</b> 2007																																																
<b>Current Owner Information:</b> RYMSZEWICZ HELEN  1014 ALMY ST  NEW BEDFORD, MA 02745		<b>Current Sales Information:</b> <b>Sale Date:</b> 2/4/1998 <b>Sale Price:</b> 0 <b>Legal Reference:</b> 4037-248 <b>Grantor:</b> RYMSZEWICZ HELEN,		Enter card number to view Card 1 of 1 <input type="text"/> <input type="button" value="Go"/>  <input type="button" value="New Search"/>																																																
This Property contains 0.138 acres of land mainly classified as Single Family with a(n) Cape cod style building, built about 1950, having Wood Shingle exterior and Asphalt roof cover, with 1 unit(s), 6 total room(s), 3 total bedroom(s) 1 total bath(s), 0 3/4 baths, and 0 total half bath(s).																																																				
<b>Building Value:</b> 100100		<b>Land Value:</b> 62200	<b>Yard Items Value:</b> 1100	<b>Total Value:</b> 163400																																																
<b>Fiscal Year 2007</b> <table border="1"> <tr><td>Tax Rate Residential:</td><td>10.31</td></tr> <tr><td>Tax Rate Commercial:</td><td>22.35</td></tr> <tr><td>Property Code:</td><td>101</td></tr> <tr><td>Total Bldg Value:</td><td>100100</td></tr> <tr><td>Total Yard Value:</td><td>1100</td></tr> <tr><td>Total Land Value:</td><td>62200</td></tr> <tr><td>Total Parcel Value:</td><td>163400</td></tr> <tr><td>Tax:</td><td>1684.65</td></tr> </table>		Tax Rate Residential:	10.31	Tax Rate Commercial:	22.35	Property Code:	101	Total Bldg Value:	100100	Total Yard Value:	1100	Total Land Value:	62200	Total Parcel Value:	163400	Tax:	1684.65	<b>Fiscal Year 2006</b> <table border="1"> <tr><td>Tax Rate Residential:</td><td>10.87</td></tr> <tr><td>Tax Rate Commercial:</td><td>25.13</td></tr> <tr><td>Property Code:</td><td>101</td></tr> <tr><td>Total Bldg Value:</td><td>86100</td></tr> <tr><td>Total Yard Value:</td><td>1100</td></tr> <tr><td>Total Land Value:</td><td>55600</td></tr> <tr><td>Total Parcel Value:</td><td>142800</td></tr> <tr><td>Tax:</td><td>1552.24</td></tr> </table>		Tax Rate Residential:	10.87	Tax Rate Commercial:	25.13	Property Code:	101	Total Bldg Value:	86100	Total Yard Value:	1100	Total Land Value:	55600	Total Parcel Value:	142800	Tax:	1552.24	<b>Fiscal Year 2005</b> <table border="1"> <tr><td>Tax Rate Residential:</td><td></td></tr> <tr><td>Tax Rate Commercial:</td><td></td></tr> <tr><td>Property Code:</td><td></td></tr> <tr><td>Total Bldg Value:</td><td></td></tr> <tr><td>Total Yard Value:</td><td></td></tr> <tr><td>Total Land Value:</td><td></td></tr> <tr><td>Total Parcel Value:</td><td></td></tr> <tr><td>Tax:</td><td></td></tr> </table>	Tax Rate Residential:		Tax Rate Commercial:		Property Code:		Total Bldg Value:		Total Yard Value:		Total Land Value:		Total Parcel Value:		Tax:	
Tax Rate Residential:	10.31																																																			
Tax Rate Commercial:	22.35																																																			
Property Code:	101																																																			
Total Bldg Value:	100100																																																			
Total Yard Value:	1100																																																			
Total Land Value:	62200																																																			
Total Parcel Value:	163400																																																			
Tax:	1684.65																																																			
Tax Rate Residential:	10.87																																																			
Tax Rate Commercial:	25.13																																																			
Property Code:	101																																																			
Total Bldg Value:	86100																																																			
Total Yard Value:	1100																																																			
Total Land Value:	55600																																																			
Total Parcel Value:	142800																																																			
Tax:	1552.24																																																			
Tax Rate Residential:																																																				
Tax Rate Commercial:																																																				
Property Code:																																																				
Total Bldg Value:																																																				
Total Yard Value:																																																				
Total Land Value:																																																				
Total Parcel Value:																																																				
Tax:																																																				

Disclaimer: This information is believed to be correct but is subject to change and is not warranted.





PERMIT NO.  
**23908**

CITY OF NEW BEDFORD  
SEWER AND/OR STORM DRAIN PERMIT

DATE 10/30/06

This certifies that permission is granted to

Michael Rymaszewicz 1014 Almy St. NB 508 995 3404  
Property Owner Address Tel. 508 991 6133 work

To connect a sewer and/or storm drain located at stub at property line - 2" force main

Assessor's Plot 134 Lot 122, to the sewer and/or storm drain in Almy Street

To be laid in accordance with the conditions in this application and the City of New Bedford ordinances.

TYPE OF USE: ☒ RESIDENTIAL ☐ COMMERCIAL ☐ INDUSTRIAL ☐ OTHER

3309pd

If applicant other than actual property owner, attach Letter of Authorization from Property Owner.

Name..... Tel.....

Mailing Address.....

The Bonded Contractor/Drain Layer authorized to perform this work is:

R. J. Laezza P.O. Box 51643 NB 508 763 4827  
Name Address Tel.

Type of Pipe Required: sdn 1 1/2" pipe

PERMIT EXPIRES ONE YEAR AFTER DATE OF ISSUE

- Requires separate connections for sewage and storm drain where applicable. Storm water cannot be discharged to a sanitary sewer.
  - All work must be inspected and approved by a D.P.I. inspector before backfilling.
  - If this connection is to be part of a private service shared jointly with other building owners, attach copy of Recorded Joint Maintenance Agreement.
  - Permits can be issued to Industrial and/or Commercial Applicants only upon receipt and approval by the Commissioner of Public Infrastructure of required plans and supplemental information.
  - In addition, a City-issued Industrial User Discharge Permit and/or a Sewer Extension/Connection Permit issued by the Commonwealth of Massachusetts D.E.P. shall be required by the City for Industrial Discharge into the sewer system.
- Industrial User Discharge Permit No..... Date.....

Comm. Mass. Sewer Conn./Ext. Permit No..... Date.....

A Filing and Inspection Fee of \$150.00 plus an Entrance Fee of \$..... where applicable, must accompany this application.

Bank# Webster Check# 1750 Date 10/30/06 Receipt# 6203

Other requirements: 24 hr. inspection notice at 508 979 1527

Connection made to Sewer Part of jointly-shared private line YES ☒ NO  
Storm Drain

Applicant agrees to abide by the above terms, as well as all pertinent ordinances of the City of New Bedford, and such other special rules as the Commissioner of Public Infrastructure and/or City Engineer may deem necessary

Quate M. Andrade  
Acting City Engineer mn

Michael Rymaszewicz  
Signature of Property Owner or Representative

INSPECTOR'S REPORT

INSPECTED BY: \_\_\_\_\_  
DATE: \_\_\_\_\_  
COMMENTS: \_\_\_\_\_

APPROVED \_\_\_\_\_ DISAPPROVED \_\_\_\_\_

SIGNATURE

SKETCH PLAN

Mary T. Neves

---

**From:** Sarah Porter  
**Sent:** Tuesday, October 31, 2006 11:42 AM  
**To:** Mary T. Neves  
**Subject:** RE: sewer tie in

Ok all set to issue

Thank you Mary

-----Original Message-----

**From:** Mary T. Neves  
**Sent:** Monday, October 30, 2006 8:52 AM  
**To:** Sarah Porter  
**Subject:** sewer tie in

Hi Sarah,

The owner of 1014 Almy Street wants to tie into the sewer stub. The plot is 134 and the lot is 122.

May I issue this permit?

Thanks for your assistance.