



PERMIT NO.

23909

CITY OF NEW BEDFORD  
SEWER AND/OR STORM DRAIN PERMIT

DATE 11-2-06

This certifies that permission is granted to

FRANKLIN D. Quigley 54 Sacamore St. Newton, MA 02461  
Property Owner Address Walgreens Tel. 2968 ACUSHNET AVE.

To connect a sewer and/or storm drain located at ACUSHNET AVE / WEC PHILLIPS ST.

Assessor's Plot 132 Lot 366 to the sewer and/or storm drain in ACUSHNET AVE Street

To be laid in accordance with the conditions in this application and the City of New Bedford ordinances.

TYPE OF USE: RESIDENTIAL COMMERCIAL INDUSTRIAL OTHER

If applicant other than actual property owner, attach Letter of Authorization from Property Owner.

Name TIMOTHY DREW DBA - T. DREW Exc Tel.

Mailing Address 18 Plymouth St. Abington, MA 02351

The Bonded Contractor/Drain Layer authorized to perform this work is:

T. Drew Excavating 18 Plymouth St. 781-706-2576

Name Address Tel.

Type of Pipe Required: S.D.R. 35 PVC

## PERMIT EXPIRES ONE YEAR AFTER DATE OF ISSUE

- Requires separate connections for sewage and storm drain where applicable. Storm water cannot be discharged to a sanitary sewer.
- All work must be inspected and approved by a D.P.I. inspector before backfilling.
- If this connection is to be part of a private service shared jointly with other building owners, attach copy of Recorded Joint Maintenance Agreement.
- Permits can be issued to Industrial and/or Commercial Applicants only upon receipt and approval by the Commissioner of Public Infrastructure of required plans and supplemental information.
- In addition, a City-issued Industrial User Discharge Permit and/or a Sewer Extension/Connection Permit issued by the Commonwealth of Massachusetts D.E.P. shall be required by the City for Industrial Discharge into the sewer system.

Industrial User Discharge Permit No. Date

Comm. Mass. Sewer Conn./Ext. Permit No. Date

A Filing and Inspection Fee of \$150.00, plus an Entrance Fee of \$ where applicable, must accompany this application.

Bank# Sovereign Bank Check# 629 Date 11-3-06 Receipt# 6129

Other requirements: 24 hour notice for inspection

per approved plans

Connection made to Sewer Part of jointly-shared private line YES NO  
Storm Drain

Applicant agrees to abide by the above terms, as well as all pertinent ordinances of the City of New Bedford, and such other special rules as the Commissioner of Public Infrastructure and/or City Engineer may deem necessary

Duarte M. Andrade Acting City Engineer Timothy D Drew Signature of Property Owner or Representative

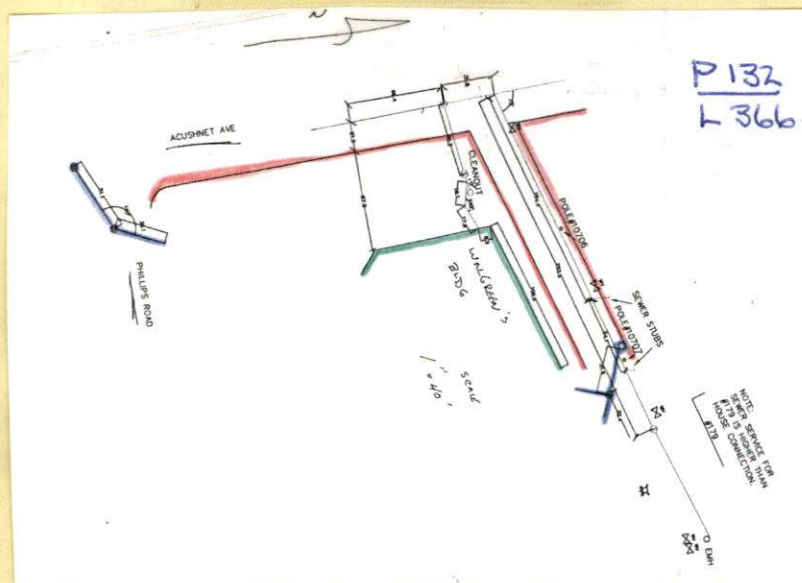
## INSPECTOR'S REPORT

INSPECTED BY: KEVIN CORNELL

DATE: 1-10-07

COMMENTS:

APPROVED DISAPPROVED

Kevin J. Cornell  
SIGNATURE





PERMIT NO.

23909

CITY OF NEW BEDFORD  
SEWER AND/OR STORM DRAIN PERMIT

DATE 11-2-06

This certifies that permission is granted to

FRANKLIN D. Quigley 54 Sacomett St. Newton, MA 02461  
Property Owner Address #975 Phillips Rd. Tel.

To connect a sewer and/or storm drain located at Acushnet Ave. / N.E.C. Phillips Rd.

Assessor's Plot 132 Lot 366, to the sewer and/or storm drain in Acushnet Ave. Street

To be laid in accordance with the conditions in this application and the City of New Bedford ordinances.

TYPE OF USE: RESIDENTIAL COMMERCIAL INDUSTRIAL OTHER

If applicant other than actual property owner, attach Letter of Authorization from Property Owner.

Name Timothy Drew DBA - T. Drew Exc. Tel.

Mailing Address 18 Plymouth St. Abington, MA 02351

The Bonded Contractor/Drain Layer authorized to perform this work is:

T. Drew Excavating 18 Plymouth St. 781-706-2576

Name Address Tel.

Type of Pipe Required: SDR-35 PVC

## PERMIT EXPIRES ONE YEAR AFTER DATE OF ISSUE

- Requires separate connections for sewage and storm drain where applicable. Storm water cannot be discharged to a sanitary sewer.
  - All work must be inspected and approved by a D.P.I. inspector before backfilling.
  - If this connection is to be part of a private service shared jointly with other building owners, attach copy of Recorded Joint Maintenance Agreement.
  - Permits can be issued to Industrial and/or Commercial Applicants only upon receipt and approval by the Commissioner of Public Infrastructure of required plans and supplemental information.
  - In addition, a City-issued Industrial User Discharge Permit and/or a Sewer Extension/Connection Permit issued by the Commonwealth of Massachusetts D.E.P. shall be required by the City for Industrial Discharge into the sewer system.
- Industrial User Discharge Permit No. Date

Comm. Mass. Sewer Conn./Ext. Permit No. Date

A Filing and Inspection Fee of \$150.00, plus an Entrance Fee of \$ where applicable, must accompany this application.

Bank# Sovereign Bank Check# 629 Date 11-3-06 Receipt# 6129

Other requirements: 24 hour notice for inspection

per approved plans

Connection made to Sewer Part of jointly-shared private line YES NO  
Storm Drain

Applicant agrees to abide by the above terms, as well as all pertinent ordinances of the City of New Bedford, and such other special rules as the Commissioner of Public Infrastructure and/or City Engineer may deem necessary

Duarte M. Andrade  
Acting City EngineerTimothy D. Drew  
Signature of Property Owner or Representative

## INSPECTOR'S REPORT

INSPECTED BY: \_\_\_\_\_  
DATE: \_\_\_\_\_  
COMMENTS: \_\_\_\_\_

APPROVED

DISAPPROVED

SIGNATURE

SKETCH PLAN