



PERMIT NO.

23934

CITY OF NEW BEDFORD  
SEWER AND/OR STORM DRAIN PERMIT

DATE 3/30/07

This certifies that permission is granted to

Irene Pires 1120 Almy St. NB 508 995 4958  
Property Owner Address Tel.

To connect a sewer and/or storm drain located at 2" force main Almy Street

Assessor's Plot 134 Lot 131, to the sewer and/or storm drain in stub at property line Street

To be laid in accordance with the conditions in this application and the City of New Bedford ordinances.

TYPE OF USE: RESIDENTIAL COMMERCIAL INDUSTRIAL OTHER 330 gpd

If applicant other than actual property owner, attach Letter of Authorization from Property Owner.

Name..... Tel.....

Mailing Address.....

The Bonded Contractor/Drain Layer authorized to perform this work is:

Chris Mendoza Co 45 Chase Rd. Dartmouth 508 990-2553  
Name Address Tel.

Type of Pipe Required: PVC 1 1/2" sdn 40?

PERMIT EXPIRES ONE YEAR AFTER DATE OF ISSUE

Owner to pay for stub connection and assessment fee once it has been determined by the City

- Requires separate connections for sewage and storm drain where applicable. Storm water cannot be discharged to a sanitary sewer.
- All work must be inspected and approved by a D.P.I. inspector before backfilling.
- If this connection is to be part of a private service shared jointly with other building owners, attach copy of Recorded Joint Maintenance Agreement.
- Permits can be issued to Industrial and/or Commercial Applicants only upon receipt and approval by the Commissioner of Public Infrastructure of required plans and supplemental information.
- In addition, a City-issued Industrial User Discharge Permit and/or a Sewer Extension/Connection Permit issued by the Commonwealth of Massachusetts D.E.P. shall be required by the City for Industrial Discharge into the sewer system.

Industrial User Discharge Permit No..... Date.....

Comm. Mass. Sewer Conn./Ext. Permit No..... Date.....

A Filing and Inspection Fee of \$150.00 plus an Entrance Fee of \$..... where applicable, must accompany this application.

Bank# Sovereign Check# 873 Date 3/30/07 Receipt# 6999

Other requirements: 24 hr. inspection at 508 979 1527. Contractor must contact City's Conservation Agent 508-991-6188 - Wetland Issue

Connection made to Sewer Part of jointly-shared private line YES NO  
Storm Drain

Applicant agrees to abide by the above terms, as well as all pertinent ordinances of the City of New Bedford, and such other special rules as the Commissioner of Public Infrastructure and/or City Engineer may deem necessary

Duarte M. Andrade / mn  
Acting City Engineer

Signature of Property Owner or Representative


## INSPECTOR'S REPORT

INSPECTED BY: Kevin Cornell  
DATE: 4/25/07  
COMMENTS:

APPROVED

DISAPPROV

SIGNATURE

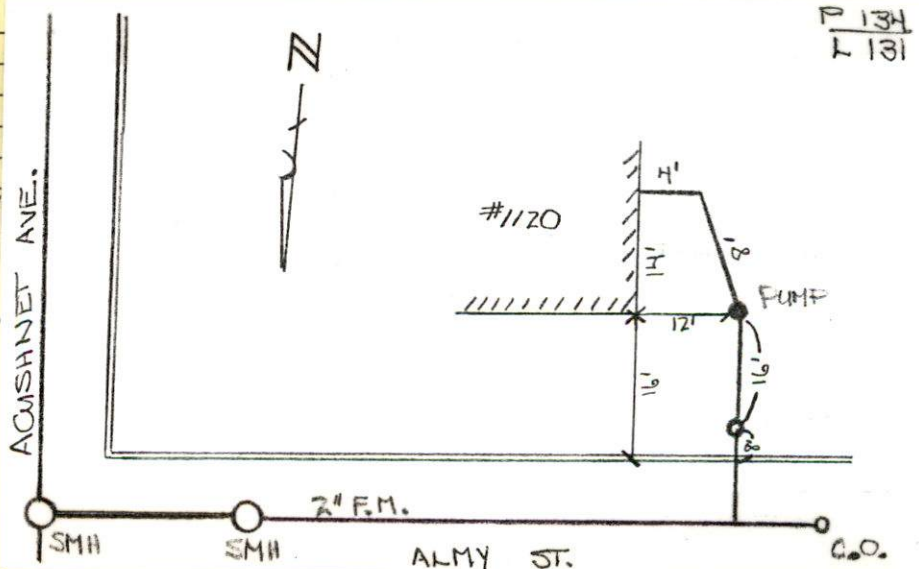




4-25-07  
SUNNY 60°  
WEDNESDAY

# 1120 ALMY ST  
PERMIT # 23834

CONTRACTOR - CHRIS MENDOZA  
508-980-2553

SEE ALMY ST  
AS-BUILT PLAN  
FOR FORCE MAIN  
& HOUSE LOCATION

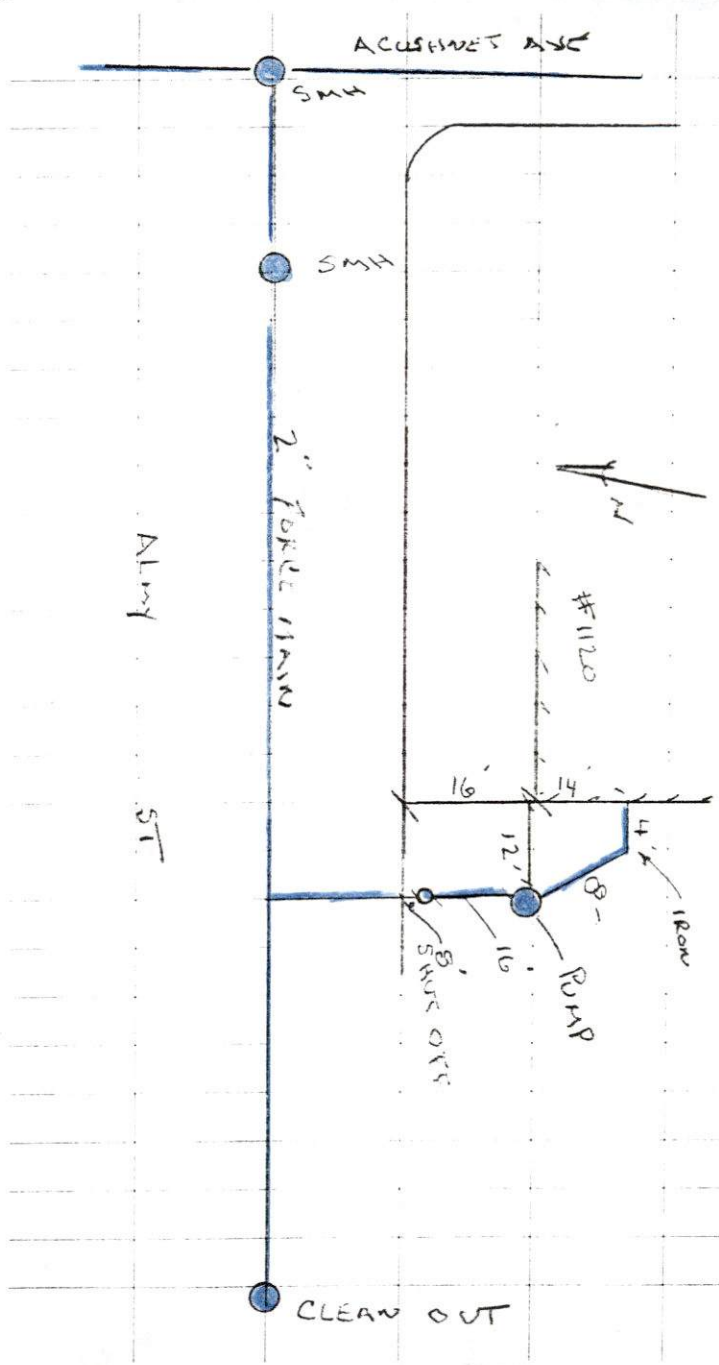



PERMIT NO.  
**23934**

CITY OF NEW BEDFORD  
SEWER AND/OR STORM DRAIN PERMIT

DATE 3/30/07

This certifies that permission is granted to

Irene Pires 1120 Almy St. NB 508 995 4958  
Property Owner Address Tel.

To connect a sewer and/or storm drain located at 2" force main Almy Street

Assessor's Plot 134 Lot 131, to the sewer and/or storm drain in stub at property line Street

To be laid in accordance with the conditions in this application and the City of New Bedford ordinances.

TYPE OF USE: RESIDENTIAL COMMERCIAL INDUSTRIAL OTHER

330 gpd

If applicant other than actual property owner, attach Letter of Authorization from Property Owner.

Name..... Tel.....

Mailing Address.....

The Bonded Contractor/Drain Layer authorized to perform this work is:

Chris Mendoza Co 45 Chase Rd Dartmouth 508 990-2553  
Name Address Tel.

Type of Pipe Required: PVC 1 1/2" sdw 40'

Owner to pay for stub connection and assessment fee once it has been determined by the City

PERMIT EXPIRES ONE YEAR AFTER DATE OF ISSUE

- Requires separate connections for sewage and storm drain where applicable. Storm water cannot be discharged to a sanitary sewer.
- All work must be inspected and approved by a D.P.I. inspector before backfilling.
- If this connection is to be part of a private service shared jointly with other building owners, attach copy of Recorded Joint Maintenance Agreement.
- Permits can be issued to Industrial and/or Commercial Applicants only upon receipt and approval by the Commissioner of Public Infrastructure of required plans and supplemental information.
- In addition, a City-issued Industrial User Discharge Permit and/or a Sewer Extension/Connection Permit issued by the Commonwealth of Massachusetts D.E.P. shall be required by the City for Industrial Discharge into the sewer system.

Industrial User Discharge Permit No..... Date.....

Comm. Mass. Sewer Conn./Ext. Permit No..... Date.....

A Filing and Inspection Fee of \$150.00 plus an Entrance Fee of \$..... where applicable, must accompany this application.

Bank# Savercign Check# 873 Date 3/30/07 Receipt# 6999

Other requirements: 24 hr inspection at 508 979 1527. Contractor must contact City's Conservation Agent 508-991-6188 - Wetland Issue

Connection made to Sewer Part of jointly-shared private line YES ☒ NO  
Storm Drain

Applicant agrees to abide by the above terms, as well as all pertinent ordinances of the City of New Bedford, and such other special rules as the Commissioner of Public Infrastructure and/or City Engineer may deem necessary

Quante M. Andrade  
Acting City Engineer /mn


Irene Pires  
Signature of Property Owner or Representative

INSPECTOR'S REPORT

INSPECTED BY: \_\_\_\_\_  
DATE: \_\_\_\_\_  
COMMENTS: \_\_\_\_\_

APPROVED \_\_\_\_\_ DISAPPROVED \_\_\_\_\_

SIGNATURE

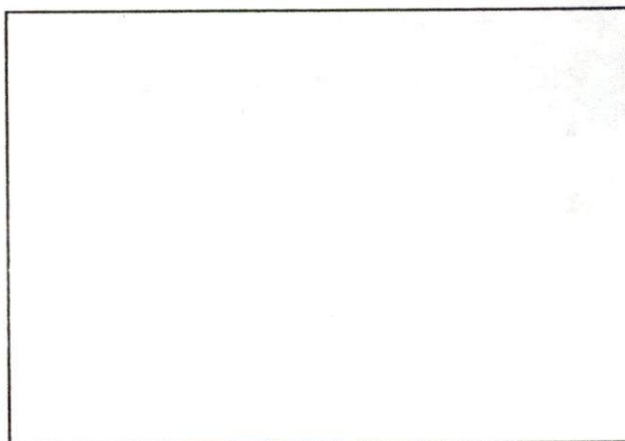

SKETCH PLAN

## Mary T. Neves

---

**From:** Sarah Porter  
**Sent:** Monday, April 02, 2007 8:36 AM  
**To:** Mary T. Neves  
**Subject:** RE: sewer permit 23934

Mary,

please have the contractor call me - they will probably have to put out some hay bales as the wetland is very close to them

thank you

Sarah

-----Original Message-----

**From:** Mary T. Neves  
**Sent:** Friday, March 30, 2007 3:13 PM  
**To:** Sarah Porter  
**Subject:** sewer permit 23934

Hi Sarah,

The property owner of 1120 Almy Street would like to tie into the public sewer. The plot is 134 and the lot is 131.

May we issue this permit? A stub exists to the property line.

Thanks for your assistance.



1105 Shawmut Avenue  
New Bedford, MA 02746  
Phone: 508-979-1551  
Fax: 508-991-6152

**City of New Bedford,  
DPI**

# Fax

To: Mary From: Engineering  
Fax: \_\_\_\_\_ Date: 4-27-07  
Phone: \_\_\_\_\_ Pages: 2  
Re: 1120 Almy St. CC: \_\_\_\_\_

☐ Urgent ☐ For Review ☐ Please Comment ☐ Please Reply ☐ Please Recycle

•Comments: Mary  
Kevin Cornell inspected 4.25.07  
Do not have his report yet  
but verbally he said all OK.



PERMIT NO.  
23934

CITY OF NEW BEDFORD  
SEWER AND/OR STORM DRAIN PERMIT

DATE 3/30/07

This certifies that permission is granted to

Irene Pires 1120 Almy St. NB 508 995 4958  
Property Owner Address Tel.

To connect a sewer and/or storm drain located at 2" force main Almy Street

Assessor's Plot 134 Lot 131, to the sewer and/or storm drain in stub at property line Street

To be laid in accordance with the conditions in this application and the City of New Bedford ordinances.

TYPE OF USE: RESIDENTIAL COMMERCIAL INDUSTRIAL OTHER 330 gpd

If applicant other than actual property owner, attach Letter of Authorization from Property Owner.

Name Tel.

Mailing Address

The Bonded Contractor/Drain Layer authorized to perform this work is:

Chris Mendoza Co 45 Chase Rd Dartmouth 508 990-2553

Name Address Tel.

Type of Pipe Required: P.V.C. 1 1/2" sdv 40?

PERMIT EXPIRES ONE YEAR AFTER DATE OF ISSUE

Owner to pay for stub connection and assessment fee once it has been determined by the City

- Requires separate connections for sewage and storm drain where applicable. Storm water cannot be discharged to a sanitary sewer.
- All work must be inspected and approved by a D.P.I. inspector before backfilling.
- If this connection is to be part of a private service shared jointly with other building owners, attach copy of Recorded Joint Maintenance Agreement.
- Permits can be issued to Industrial and/or Commercial Applicants only upon receipt and approval by the Commissioner of Public Infrastructure of required plans and supplemental information.
- In addition, a City-issued Industrial User Discharge Permit and/or a Sewer Extension/Connection Permit issued by the Commonwealth of Massachusetts D.E.P. shall be required by the City for Industrial Discharge into the sewer system.

Industrial User Discharge Permit No. Date

Comm. Mass. Sewer Conn./Ext. Permit No. Date

A Filing and Inspection Fee of \$150 plus an Entrance Fee of \$... where applicable, must accompany this application.

Bank# Sovereign Check# 873 Date 3/30/07 Receipt# 6999

Other requirements: 24 hr inspection at 508 979 1527. Contractor must contact City's Conservation Agent 508-991-6188 - Wetland Issues

Connection made to Sewer Part of jointly-shared private line YES NO  
Storm Drain

Applicant agrees to abide by the above terms, as well as all pertinent ordinances of the City of New Bedford, and such other special rules as the Commissioner of Public Infrastructure and/or City Engineer may deem necessary

Quate M. Andrade Acting City Engineer

Signature of Property Owner or Representative

INSPECTOR'S REPORT

INSPECTED BY:

DATE:

COMMENTS:

APPROVED

DISAPPROVED

SIGNATURE

Inspected by  
Kevin Cornell  
on 4.25-07  
  
Verbally spoke to  
Kevin & all pt

SKETCH PLAN

TRANSMISSION VERIFICATION REPORT

TIME : 04/27/2007 08:54  
NAME : DPI WATER WASTEWATER  
FAX : 5089916152  
TEL : 5089916152

DATE, TIME	04/27 08:52
FAX NO./NAME	3143
DURATION	00:01:14
PAGE(S)	02
RESULT	OK
MODE	STANDARD
	ECM