



PERMIT NO.
23952

CITY OF NEW BEDFORD
SEWER AND/OR STORM DRAIN PERMIT

DATE 5/4/07

This certifies that permission is granted to

N.B. Housing Authority 725 Pleasant St. N.B. 508-997-4852
Property Owner Address Tel. (Units 1-6)

To connect a sewer and/or storm drain located at Mill St. N.S. between A.S.H. & Cedar St.
Mill St. (E. 1st St.) SMH & DMH

Assessor's Plot 5.7 Lot 174 to the sewer and/or storm drain in Cedar St. (at N. 1st St.) DMH Street

To be laid in accordance with the conditions in this application and the City of New Bedford ordinances.
TYPE OF USE: ☒ RESIDENTIAL ☐ COMMERCIAL ☐ INDUSTRIAL FLOW 1320 G.P.D. 1320
3 units @ 150 G.P.D. = 330
3 units @ 330 G.P.D. = 990

If applicant other than actual property owner, attach Letter of Authorization from Property Owner.

Name Joseph Woodall Tel. 508-520-9733
Mailing Address 182 Seaboard St. Norfolk, MA

The Bonded Contractor/Drain Layer authorized to perform this work is:
Joe Woodall & Sons Const. Co. Inc. 182 Seaboard St. Norfolk, MA
Name Address Tel.

Type of Pipe Required: SDC 35 PVC 508-520-9733

PERMIT EXPIRES ONE YEAR AFTER DATE OF ISSUE

- Requires separate connections for sewage and storm drain where applicable. Storm water cannot be discharged to a sanitary sewer.
- All work must be inspected and approved by a D.P.I. inspector before backfilling.
- If this connection is to be part of a private service shared jointly with other building owners, attach copy of Recorded Joint Maintenance Agreement.
- Permits can be issued to Industrial and/or Commercial Applicants only upon receipt and approval by the Commissioner of Public Infrastructure of required plans and supplemental information.
- In addition, a City-issued Industrial User Discharge Permit and/or a Sewer Extension/Connection Permit issued by the Commonwealth of Massachusetts D.E.P. shall be required by the City for Industrial Discharge into the sewer system.

Industrial User Discharge Permit No. _____ Date _____

Comm. Mass. Sewer Conn./Ext. Permit No. 1908 Date _____

A Filing and Inspection Fee of \$150.00 plus an Entrance Fee of \$2058 where applicable, must accompany this application.

Bank# Bank of America Check# 20554 Date 5/3/07 Receipt# 97110

Other requirements: 24 hr inspection at 508-979-1527 Construct per

approved plans - 4 manholes + 7 mbs + 8 drain inlets
Sewer (262' x 41") + (215' x 41") = \$1908 + \$150 permit = \$2058

Connection made to Storm Drain Part of jointly-shared private line YES NO Total

Applicant agrees to abide by the above terms, as well as all pertinent ordinances of the City of New Bedford, and such other special rules as the Commissioner of Public Infrastructure and/or City Engineer may deem necessary

Quarte M. Andrade
Acting City Engineer mn

Signature of Property Owner or Representative


INSPECTOR'S REPORT

INSPECTED BY: _____
DATE: _____
COMMENTS: _____

APPROVED

DIS

SIGNATURE

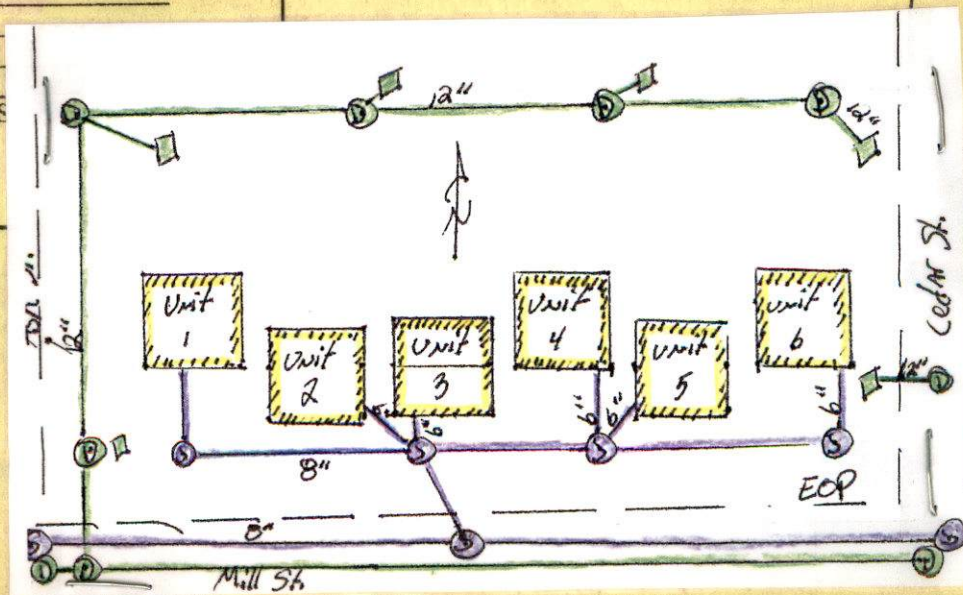



PERMIT NO.
23952

CITY OF NEW BEDFORD
SEWER AND/OR STORM DRAIN PERMIT

DATE 5/4/07

This certifies that permission is granted to

N.B. Housing Authority 725 Pleasant St. N.B. 508-997-4852
Property Owner Address Tel. (Units 1-6)

To connect a sewer and/or storm drain located at Mill St. N.S. between Ash & Cedar St.
Assessor's Plot 5.7 Lot 174 to the sewer and/or storm drain in Cedar St. (at N. Line of Mill St.) DMH Street

To be laid in accordance with the conditions in this application and the City of New Bedford ordinances.
TYPE OF USE: ☒ RESIDENTIAL ☐ COMMERCIAL ☐ INDUSTRIAL FLOW 1320 G.P.D. 1320

If applicant other than actual property owner, attach Letter of Authorization from Property Owner.
Name Joseph Woodall Tel. 508-520-9733
Mailing Address 182 Seckonk St. Norfolk, MA
The Bonded Contractor/Drain Layer authorized to perform this work is:
Joe Woodall & Sons Const. Co. Inc. 182 Seckonk St. Norfolk, MA
Name Address Tel.
Type of Pipe Required: 36" PVC 508-520-9733

PERMIT EXPIRES ONE YEAR AFTER DATE OF ISSUE

- Requires separate connections for sewage and storm drain where applicable. Storm water cannot be discharged to a sanitary sewer.
 - All work must be inspected and approved by a D.P.I. inspector before backfilling.
 - If this connection is to be part of a private service shared jointly with other building owners, attach copy of Recorded Joint Maintenance Agreement.
 - Permits can be issued to Industrial and/or Commercial Applicants only upon receipt and approval by the Commissioner of Public Infrastructure of required plans and supplemental information.
 - In addition, a City-issued Industrial User Discharge Permit and/or a Sewer Extension/Connection Permit issued by the Commonwealth of Massachusetts D.E.P. shall be required by the City for Industrial Discharge into the sewer system.
- Industrial User Discharge Permit No. Date

Comm. Mass. Sewer Conn./Ext. Permit No. 1908.D.00
A Filing and Inspection Fee of \$150.00 plus an Entrance Fee of \$150.00 where applicable, must accompany this application.

Bank# Sovereign Check# 20554 Date 5/3/07 Receipt# 2297110

Other requirements: 24 hr inspection at 508-979-1527 Construct per
Sewer Storm drain

approved plans - 4 manholes 7 mls + 5 drain inlets
Sewer (262' x 41") + (215' x 41") = \$1,908. + \$150 permit = \$2058.
Connection made to Part of jointly-shared private line YES NO
Storm Drain Total

Applicant agrees to abide by the above terms, as well as all pertinent ordinances of the City of New Bedford, and such other special rules as the Commissioner of Public Infrastructure and/or City Engineer may deem necessary

Quarte M. Andrade
Acting City Engineer

Signature of Property Owner or Representative

INSPECTOR'S REPORT

INSPECTED BY:
DATE:
COMMENTS:

APPROVED

DISAPPROVED

SIGNATURE

SKETCH PLAN

Duane (5/3/07):

all other #'s as quoted by Michele's e-mail to JJ Cardosi (even though plans show slight differences in linear footages for S.D. & S. main cmts.) and do add Storm drain not included initially & call Cardosi to explain. All set, Jay Cardosi (John Cardosi) will come in tomorrow w/HC & w/subcontractor to sign permits.

→ **MILL ST. FROM ASH ST. TO CEDAR ST. UNITS 1-6**

MAIN SEWER INSTALLATION, WITH 4 MANHOLES

Storm Drain Install. with 7 MH'S & 5 Drain Inlets

WATER MAIN INSPECTION

6 WATER SERVICE CONNECTIONS

AFTER SEWER MAIN HAS BEEN INSPECTED, THEN SEWER SERVICE PERMITS MAY BE OBTAINED

206'

215 X \$4.00

SUB-TOTAL

\$150.00

\$860.00

\$1,010.00

240 X \$4.00

- 6 X \$225.00

SUB-TOTAL

\$960.00

\$1,350.00

\$2,310.00

- 6 X \$150.00

\$900.00

→ **MILL ST. FROM CEDAR ST. TO COTTAGE ST. UNITS 7-14**

✕ **MAIN SEWER INSTALLATION, WITH 5 MANHOLES**

✕ **STORM DRAIN MAIN INSTALLATION, WITH 4 MANHOLES AND 5 DRAIN INLETS**

WATER MAIN INSPECTION

8 WATER SERVICE CONNECTIONS

AFTER SEWER MAIN HAS BEEN INSPECTED, THEN SEWER SERVICE PERMITS MAY BE OBTAINED

CHECK FOR SEWER & SD MAINS

CHECK FOR WATER MAIN & SERVICE TAPS

CHECK FOR SEWER SERVICE CONNECTIONS

✕ lot 377

326'

307 X \$4.00

SUB-TOTAL

\$150.00

\$1,228.00

\$1,272.00

\$2,650.00

318' X \$4.00

343'

350 X \$4.00

- 8 X \$225.00

SUB-TOTAL

\$1,400.00

\$1,800.00

\$3,200.00

- 8 X \$150.00

\$1,200.00

\$3,660.00

\$5,510.00

\$2,100.00

Water main 960 + 1400 = \$2360.00

Joe Wordell - Sewer & Water Contractor

Mr. Cardosi - General Contractor

401-435-6101

e-mail: INFO@JJCardosi.Com



John J. Cardosi, Jr.
President
Cell: 401.640.9038

J. J. CARDOSI, INC.
General Contractor
INDUSTRIAL - COMMERCIAL

28 Boston Street
East Providence, RI 02914-5009
www.jjcardosi.com

Tel: 401.435.6101
Fax: 401.435.6102
Pager: 401.785.5317

New Bedford Housing Authority

Modernization Office

725 Pleasant Street

New Bedford, Massachusetts 02740

JOSEPH S. FINNERTY
Executive DirectorTEL: 508-997-4852
FAX: 508-997-4825
TDD: 508-997-4674

April 30, 2007Mr. Ronald LaBelle
Dept. of Public Infrastructure
1105 Shawmut Ave.
New Bedford, Ma 02740

Dear Mr. LaBelle,

I, Richard Walega of the New Bedford Housing Authority authorize Joe Woodall and Sons to acquire necessary permits for the site work for the Mill Street Housing Project.

Sincerely,

Richard Walega
Deputy Director of Modernization

VOID

7099

CITY OF NEW BEDFORD
ENGINEERING DEPARTMENT

5/4 2007

TO J. J. Cordosi, Inc.

78 Boston St., E. Providence, RI 02914-5009

sewer permit # 23952
& storm drain

p 57 l 174

Mill St. - Ash St. to Cedar St.
(Condo units 1-6) permit 150.00

extension 1908.00
of sewer &
storm drain

ACCOUNT 6001-439-44201-000

DEPOSIT \$ 2058.00

The City Ordinances require that before this work is undertaken,
the estimated cost of the same must be deposited with the City Treasurer.