



PERMIT NO.

CITY OF NEW BEDFORD
SEWER AND/OR STORM DRAIN PERMITDATE 6-6-07

23962

This certifies that permission is granted to

Property Owner Franklin Bldg & Dr.
Scott Holman Address 1765 Merriman Rd. AKRON OH 44313
Tel. ADVANCE AUTO PARTS Tel. 330-836-9911To connect a sewer and/or storm drain located at MT. Pleasant St (E) X Hathaway Rd.Assessor's Plot 102 Lot 81, to the sewer and/or storm drain in MT. Pleasant St Street

To be laid in accordance with the conditions in this application and the City of New Bedford ordinances.

TYPE OF USE: RESIDENTIAL COMMERCIAL INDUSTRIAL FLOW G.P.D.

If applicant other than actual property owner, attach Letter of Authorization from Property Owner.

Name Steven Decker Tel.
Mailing Address P.O. Box 728, 19 Industrial Park Rd. Saco, ME 04072

The Bonded Contractor/Drain Layer authorized to perform this work is:

Name S. L. F. Construction Corp. Address 169 Camelot Dr. Plymouth, MA 02360
Tel. 508-746-3834
Type of Pipe Required: SDR 35 PVC

PERMIT EXPIRES ONE YEAR AFTER DATE OF ISSUE

- Requires separate connections for sewage and storm drain where applicable. Storm water cannot be discharged to a sanitary sewer.
- All work must be inspected and approved by a D.P.I. inspector before backfilling.
- If this connection is to be part of a private service shared jointly with other building owners, attach copy of Recorded Joint Maintenance Agreement.
- Permits can be issued to Industrial and/or Commercial Applicants only upon receipt and approval by the Commissioner of Public Infrastructure of required plans and supplemental information.
- In addition, a City-issued Industrial User Discharge Permit and/or a Sewer Extension/Connection Permit issued by the Commonwealth of Massachusetts D.E.P. shall be required by the City for Industrial Discharge into the sewer system.

Industrial User Discharge Permit No. Date Comm. Mass. Sewer Conn./Ext. Permit No. Date A Filing and Inspection Fee of \$ 150.00, plus an Entrance Fee of \$ where applicable, must accompany this application.Bank# FIFTH Third Bank Check# 1013 Date 6-4-07 Receipt# 7201Other requirements: Install manhole. Construction perapproved plan.Connection made to Sewer Part of jointly-shared private line YES NO
Storm Drain

Applicant agrees to abide by the above terms, as well as all pertinent ordinances of the City of New Bedford, and such other special rules as the Commissioner of Public Infrastructure and/or City Engineer may deem necessary


City Engineer Dustin M. AndradeSignature of Property Owner or Representative Steven Decker

INSPECTOR'S REPORT

INSPECTED BY: Kevin CornellDATE: 8/1/07COMMENTS: Inspection on 7/5 & 8/1 - see attached field notes, & as-built C

APPROVED

DISAP

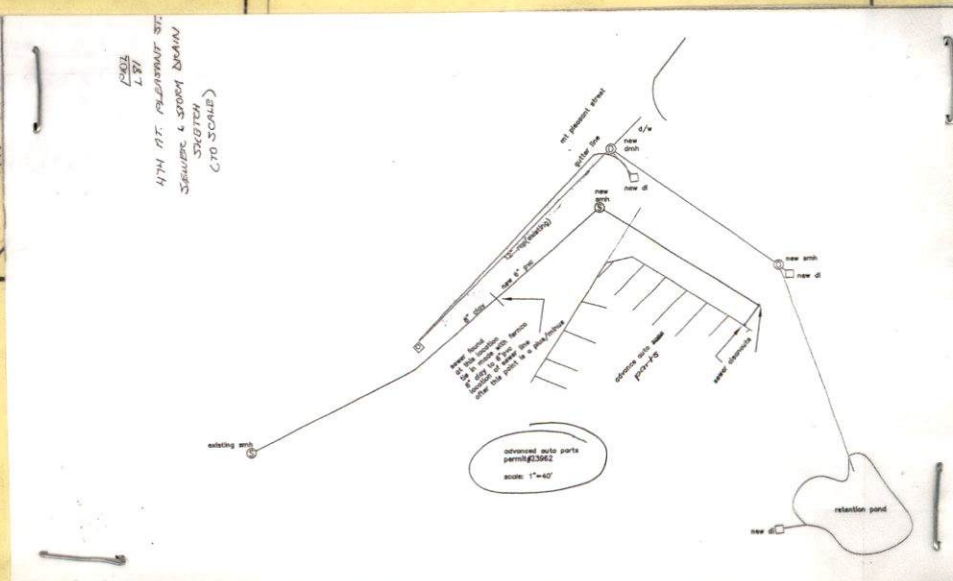SIGNATURE Kevin Cornell



PERMIT NO.

23962

CITY OF NEW BEDFORD
SEWER AND/OR STORM DRAIN PERMIT

DATE 6-6-07

This certifies that permission is granted to

Franklin Bldg & Dev.

Scott Holman

Property Owner

1765 Merriman Rd. AKRON OH 44313

Address

Tel. 330-836-9971

#474

To connect a sewer and/or storm drain located at... Mt. Pleasant St (S) Ux Hathaway Rd.

Assessor's Plot 102 Lot 81 to the sewer and/or storm drain in... Mt. Pleasant St Street

To be laid in accordance with the conditions in this application and the City of New Bedford ordinances.

TYPE OF USE: RESIDENTIAL COMMERCIAL INDUSTRIAL FLOW G.P.D.

If applicant other than actual property owner, attach Letter of Authorization from Property Owner.

Name Steven Decker

Tel.

Mailing Address P.O. Box 728, 19 Industrial Park Rd., SACO, ME 04072

The Bonded Contractor/Drain Layer authorized to perform this work is:

S.L.T. Construction Corp. 169 Camelot Dr. Plymouth, MA 02360

Name

Address

Tel. 508-746-3834

Type of Pipe Required: SDR 35 PVC

PERMIT EXPIRES ONE YEAR AFTER DATE OF ISSUE

- Requires separate connections for sewage and storm drain where applicable. Storm water cannot be discharged to a sanitary sewer.
- All work must be inspected and approved by a D.P.I. inspector before backfilling.
- If this connection is to be part of a private service shared jointly with other building owners, attach copy of Recorded Joint Maintenance Agreement.
- Permits can be issued to Industrial and/or Commercial Applicants only upon receipt and approval by the Commissioner of Public Infrastructure of required plans and supplemental information.
- In addition, a City-issued Industrial User Discharge Permit and/or a Sewer Extension/Connection Permit issued by the Commonwealth of Massachusetts D.E.P. shall be required by the City for Industrial Discharge into the sewer system.

Industrial User Discharge Permit No. Date

Comm. Mass. Sewer Conn./Ext. Permit No. Date

A Filing and Inspection Fee of \$150.00 plus an Entrance Fee of \$ where applicable, must accompany this application.

Bank# Fifth Third Bank Cleveland, OH Check# 1013 Date 6-4-07 Receipt# 7201

Other requirements: Install manhole Construction per

Approved Plan

Connection made to Sewer Part of jointly-shared private line YES NO
Storm Drain

Applicant agrees to abide by the above terms, as well as all pertinent ordinances of the City of New Bedford, and such other special rules as the Commissioner of Public Infrastructure and/or City Engineer may deem necessary

Duane M. Andrade
City Engineer


Signature of Property Owner or Representative

INSPECTOR'S REPORT

INSPECTED BY: _____
DATE: _____
COMMENTS: _____

APPROVED DISAPPROVED

SIGNATURE

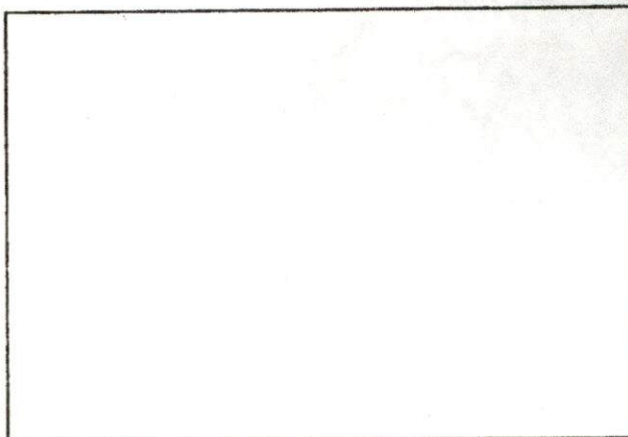

SKETCH PLAN



CITY OF NEW BEDFORD MASSACHUSETTS

D.P.I. -Engineering Division

1105 Shawmut Ave.

New Bedford, Ma. 02746

Tel: 508-991-6150

Fax: 508-961-3054 991-6152

Ronald Labelle
Commissioner

Duarte M. Andrade,
Acting City Engineer

To Whom It May Concern:

I Scott Holman 1765 Merriman Rd, Akron OH, being
(Name) (Mailing Address) 44313

Owner of property located at 480 Mt Pleasant St. C.S. nx Hathaway Rd

Plot 102, Lot 81, hereby agree to allow Steven Decker
(Name)

PO Box 728, 1A Industrial Park Rd, to act on my behalf including affixing my
(Mailing Address)

Saco, ME 04072

signature in securing permit for:

| | |
|-----------|-------------------------------|
| <u>pd</u> | Sewer/Drain Service Permits |
| <u>pd</u> | Water Service Permits |
| <u>pd</u> | Driveway Installation Permits |
| <u>pd</u> | Sidewalk Installation Permits |

I further agree to conform to, and abide by, All City rules and ask regulations applicable to the permit (s) being applied for:

Name Pittsford

Signature

1765 Merriman Rd, Akron OH 44313

Address

June 1, 2007

Date

(330) 836-9971

Telephone number



CITY OF NEW BEDFORD

951

NO. 84-07

LICENSE NO. _____

DATE _____ 20____

FOUNDATION PERMIT

MSBC Sect. 111.8 – Any permit issued shall be deemed abandoned and invalid unless the work authorized by it shall have been commenced within six (6) months after its issuance.

This certifies that CEDARWOOD Development, owner/contractor
has permission to INSTALL Foundation
on 480 MT. PLEASANT ST. 83'4" x 82'8"

providing that the person accepting this permit shall in every respect conform to the terms of the application therefor on file in this office; to the provisions of the Statute of the Commonwealth and to the By-Laws of the City of New Bedford relating to the Inspection, Erection, Enlarging, Altering, Raising, Moving, Repairing or Tearing Down of a Building.

WIRING INSPECTOR

PLUMBING INSPECTOR

BUILDING INSPECTOR

ROUGH FINISH

YOUR AREA INSPECTOR IS: JIM BERNBE

- Tel. 979-1540 Between 8:00 AM – 9:00 AM

NOTICE: NOTIFY INSPECTOR 48 HOURS
IN ADVANCE OF APPLYING
SHEATING OR LATHING


OCCUPANCY PERMIT REQUIRED BEFORE OCCUPANCY

No Building or Structure shall be used or occupied until the Certificate of Use and Occupancy shall have been issued by the Building Commissioner – MSBC. Sect. 120.1 – N.B. Zoning Ord. Sect. 9-269

THIS CARD MUST BE DISPLAYED IN A CONSPICUOUS PLACE ON THE PREMISES
AND NOT TORN DOWN OR REMOVED UNTIL COMPLETION OF WORK

SUBJECT TO MASSACHUSETTS STATE
BUILDING CODE REQUIREMENTS

[Signature]
BUILDING INSPECTOR

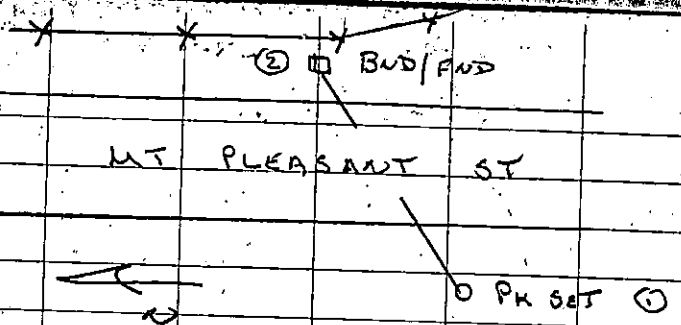

MT PLEASANT ST

K @ #1 0 00 #2 X RT

| DESC | X | DIST |
|---------------|-----------|---------|
| BUD | 0-00 | 102.275 |
| GL | 351-2755 | 77.84 |
| DW | 8-39-20 | 61.51 |
| DW | 41-30-25 | 52.69 |
| 12" Drain | 52-00-40 | 58.18 |
| 12" Drain | 63-37-55 | 61.11 |
| GL | 98-46-10 | 94.67 |
| Sewer | 100-31-05 | 127.34 |
| CB | 114-00-10 | 158.00 |
| SMH | 127-01-25 | 250.87 |
| OLDG Cor | 91-56-00 | 105.60 |
| OLDG Cor | 79-47-35 | 124.64 |
| OLDG Cor | 73-31-35 | 112.20 |
| " | 71-30-15 | 109.31 |
| " | 64-26-15 | 111.65 |
| " | 51-56-55 | 117.97 |
| sew. cleanout | 52-23-35 | 173.29 |

6-29-07 FRIDAY. SUNNY
70°

MT PLEASANT ST (19)

PLOT 102 LOT 81
ADVANCE AUTO ZONE


PERMIT 23962

CONTRACTOR S LT CONSTR
508-746-3834

339-987-7361

PLANNER GULLEY

| | | |
|--------------|-----------|--------|
| sew cleanout | 118-44-30 | 170.54 |
| SMH | 67-18-10 | 81.29 |

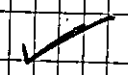

PLOTTED

REPORT
DONE

Sunny 20
870

Wednesday

8-01-07

Mt. Pleasant St (Measure auto yards)

R. Mavak

Dist

| | | |
|---------|-----------|---------------------|
| 133.980 | 229-13-05 | Ret pond |
| 117.515 | 237-02-00 | Ret pond |
| 125.875 | 235-46-45 | drn pipe - ret pond |
| 133.175 | 235-46-45 | dot of float |
| 143.375 | 238-25-45 | dot of float |
| 156.760 | 241-48-00 | dot of float |

✓
FLOTTED
763621
DANC

#2

PK Sol

Δ N #2 0° 01 #2 *

Dist

| | | |
|--------|----------|-----|
| 102.22 | 0-00-00 | BND |
| 58.37 | 49-58-45 | DMH |
| 77.290 | 52-05-00 | DI |

Description

| | | |
|---------|----------|--------|
| 162.585 | 40-36-05 | DMH |
| 170.220 | 40-37-50 | DI |
| 55.705 | 59-10-35 | Dr way |

| | | |
|--------|----------|--------|
| 63.58 | 50-41-50 | Dr way |
| 72.345 | 51-23-25 | Dr way |
| 72.925 | 24-43-25 | Dr way |

| | | |
|---------|----------|------------|
| 63.755 | 18-55-50 | Dr way |
| 59.805 | 11-37-10 | Dr way |
| 177.495 | 30-01-30 | PK Nail #3 |

Δ @ #3 0° 01 #2 *

Dist

| | | |
|---------|-----------|-------------|
| 177.505 | 0-00-00 | PK no. 1 #2 |
| 159.455 | 250-11-15 | DI |
| 153.960 | 246-09-25 | Ret pond |

165.920 238-17-40 Ret pond

P102
L81

474 MT. PLEASANT ST.
SEWER & STORM DRAIN
SKETCH
(TO SCALE)

