



PERMIT NO.

23963

CITY OF NEW BEDFORD
SEWER AND/OR STORM DRAIN PERMIT

DATE 6/11/07

This certifies that permission is granted to

Property Owner Arbunway Town House Condominium 492 Front St. Weymouth Ma.
Address (875) Tel. 508 284 2238

To connect a sewer and/or storm drain located at Old Plainville Rd. (sub.) Tel. 508 583 8731

Assessor's Plot 12.5 Lot 5, to the sewer and/or storm drain in Old Plainville Rd. Street

To be laid in accordance with the conditions in this application and the City of New Bedford ordinances.

TYPE OF USE: ☒ RESIDENTIAL ☐ COMMERCIAL ☐ INDUSTRIAL FLOW 2860 G.P.D.

If applicant other than actual property owner, attach Letter of Authorization from Property Owner.

Name..... Tel.....

Mailing Address.....

The Bonded Contractor/Drain Layer authorized to perform this work is:

Name Silva Excavating 412 Bedford St. Bridgewater Tel. 508-378-226

Address.....

Type of Pipe Required: sd 3.5 pvc

PERMIT EXPIRES ONE YEAR AFTER DATE OF ISSUE 211-07 foundation permit

- Requires separate connections for sewage and storm drain where applicable. Storm water cannot be discharged to a sanitary sewer.
- All work must be inspected and approved by a D.P.I. inspector before backfilling.
- If this connection is to be part of a private service shared jointly with other building owners, attach copy of Recorded Joint Maintenance Agreement.
- Permits can be issued to Industrial and/or Commercial Applicants only upon receipt and approval by the Commissioner of Public Infrastructure of required plans and supplemental information.
- In addition, a City-issued Industrial User Discharge Permit and/or a Sewer Extension/Connection Permit issued by the Commonwealth of Massachusetts D.E.P. shall be required by the City for Industrial Discharge into the sewer system.

Industrial User Discharge Permit No..... Date.....

Comm. Mass. Sewer Conn./Ext. Permit No..... Date.....

A Filing and Inspection Fee of \$ 150 plus an Entrance Fee of \$..... where applicable, must accompany this application.

Bank# Waban One Check# 1403 Date 6/11/07 Receipt# 7209

Other requirements: construction plan attached, 24 hr inspection notice
at 508-979-1527

Connection made to Sewer Part of jointly-shared private line YES NO
Storm Drain

Applicant agrees to abide by the above terms, as well as all pertinent ordinances of the City of New Bedford, and such other special rules as the Commissioner of Public Infrastructure and/or City Engineer may deem necessary

Acting City Engineer Quente M. Andrade Signature of Property Owner or Representative Tom Howard

INSPECTOR'S REPORT

INSPECTED BY: _____


DATE: _____

COMMENTS: _____

APPROVED

DISA

SIGNATURE

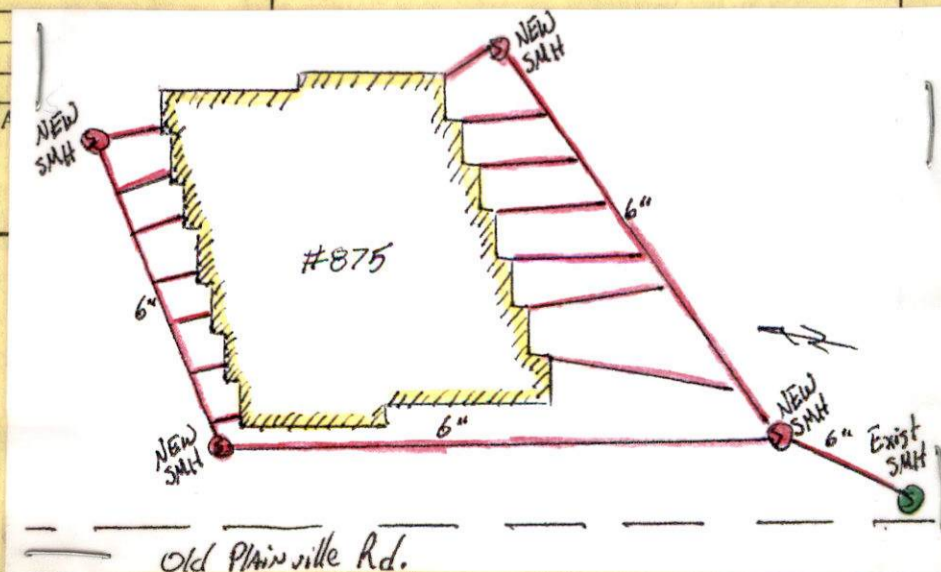



PERMIT NO.

23963

CITY OF NEW BEDFORD
SEWER AND/OR STORM DRAIN PERMIT

DATE 6/11/07

This certifies that permission is granted to

Property Owner Arbway Town House Condoms Address 432 Front St. Weymouth Ma. Tel. 508 284 2238

To connect a sewer and/or storm drain located at Old Plainville Rd (mb.) 508 583 8731

Assessor's Plot 125 Lot 5 to the sewer and/or storm drain in Old Plainville Rd. Street

To be laid in accordance with the conditions in this application and the City of New Bedford ordinances.

TYPE OF USE: ☒ RESIDENTIAL ☐ COMMERCIAL ☐ INDUSTRIAL FLOW 2860 G.P.D.

If applicant other than actual property owner, attach Letter of Authorization from Property Owner.

Name..... Tel.....

Mailing Address.....

The Bonded Contractor/Drain Layer authorized to perform this work is:

Name Sika Excavating Address 412 Bedford St. Bridgewater Tel. 508-378-226

Type of Pipe Required: sdr 35 pvc

PERMIT EXPIRES ONE YEAR AFTER DATE OF ISSUE

211-07 foundation permit

- Requires separate connections for sewage and storm drain where applicable. Storm water cannot be discharged to a sanitary sewer.
- All work must be inspected and approved by a D.P.I. inspector before backfilling.
- If this connection is to be part of a private service shared jointly with other building owners, attach copy of Recorded Joint Maintenance Agreement.
- Permits can be issued to Industrial and/or Commercial Applicants only upon receipt and approval by the Commissioner of Public Infrastructure of required plans and supplemental information.
- In addition, a City-issued Industrial User Discharge Permit and/or a Sewer Extension/Connection Permit issued by the Commonwealth of Massachusetts D.E.P. shall be required by the City for Industrial Discharge into the sewer system.

Industrial User Discharge Permit No..... Date.....

Comm. Mass. Sewer Conn./Ext. Permit No..... Date.....

A Filing and Inspection Fee of \$150 plus an Entrance Fee of \$..... where applicable, must accompany this application.

Bank# Harbor One Check# 1403 Date 6/11/07 Receipt# 7209

Other requirements: construction plan attached, 24 hr inspection notice
at 508-979-1527

Connection made to Sewer Part of jointly-shared private line YES NO
Storm Drain

Applicant agrees to abide by the above terms, as well as all pertinent ordinances of the City of New Bedford, and such other special rules as the Commissioner of Public Infrastructure and/or City Engineer may deem necessary

Duarte M. Andrade
Acting City Engineer

Tom Howard
Signature of Property Owner or Representative
Tom Howard (1/2 Owner)

INSPECTOR'S REPORT

INSPECTED BY: _____

DATE: _____

COMMENTS: _____

APPROVED

DISAPPROVED

SIGNATURE

SKETCH PLAN

curb line