



PERMIT NO.

CITY OF NEW BEDFORD  
SEWER AND/OR STORM DRAIN PERMIT

DATE 7/6/07

23978

This certifies that permission is granted to

N.B. Housing Authority 725 Pleasant St N.B. 508-997-4852  
Property Owner Address unit 13 46'w x Cottage St Tel.

To connect a sewer and/or storm drain located at 162 Mill St (on private property) s  
Cottage St. (on private property) sd  
Assessor's Plot 58 Lot 377, to the sewer and/or storm drain in 1 Street

To be laid in accordance with the conditions in this application and the City of New Bedford ordinances. see  
TYPE OF USE: ☒ RESIDENTIAL ☐ COMMERCIAL ☐ INDUSTRIAL FLOW 23951 G.P.D.

If applicant other than actual property owner, attach Letter of Authorization from Property Owner.

Name Joseph Woodall Tel. 508-520-9733  
Mailing Address 182 Seaboard St Norfolk Ma  
The Bonded Contractor/Drain Layer authorized to perform this work is:  
Joe Woodall + Sara Conner Co Inc 182 Seaboard St Norfolk, Ma  
Name Address Tel. 508 520 9733  
Type of Pipe Required: sdn 35 pvc

PERMIT EXPIRES ONE YEAR AFTER DATE OF ISSUE

- Requires separate connections for sewage and storm drain where applicable. Storm water cannot be discharged to a sanitary sewer.
- All work must be inspected and approved by a D.P.I. inspector before backfilling.
- If this connection is to be part of a private service shared jointly with other building owners, attach copy of Recorded Joint Maintenance Agreement.
- Permits can be issued to Industrial and/or Commercial Applicants only upon receipt and approval by the Commissioner of Public Infrastructure of required plans and supplemental information.
- In addition, a City-issued Industrial User Discharge Permit and/or a Sewer Extension/Connection Permit issued by the Commonwealth of Massachusetts D.E.P. shall be required by the City for Industrial Discharge into the sewer system.

Industrial User Discharge Permit No. Date

Comm. Mass. Sewer Conn./Ext. Permit No. Date

A Filing and Inspection Fee of \$150.00 plus an Entrance Fee of \$..... where applicable, must accompany this application.

Bank# Sovereign Bank Check# 20800 Date 7/6/07 Receipt# 7278

Other requirements: 24 hr inspection at 508.979.1528

Construct per approved plans

Connection made to Sewer Part of jointly-shared private line YES NO  
Storm Drain

Applicant agrees to abide by the above terms, as well as all pertinent ordinances of the City of New Bedford, and such other special rules as the Commissioner of Public Infrastructure and/or City Engineer may deem necessary


Duarte M. Andrade Acting City Engineer mn  
Signature of Property Owner or Representative

INSPECTOR'S REPORT

INSPECTED BY: Kevin Corneil  
DATE: 7/10/07  
COMMENTS:

APPROVED DISAPPI

Kevin Corneil  
SIGNATURE

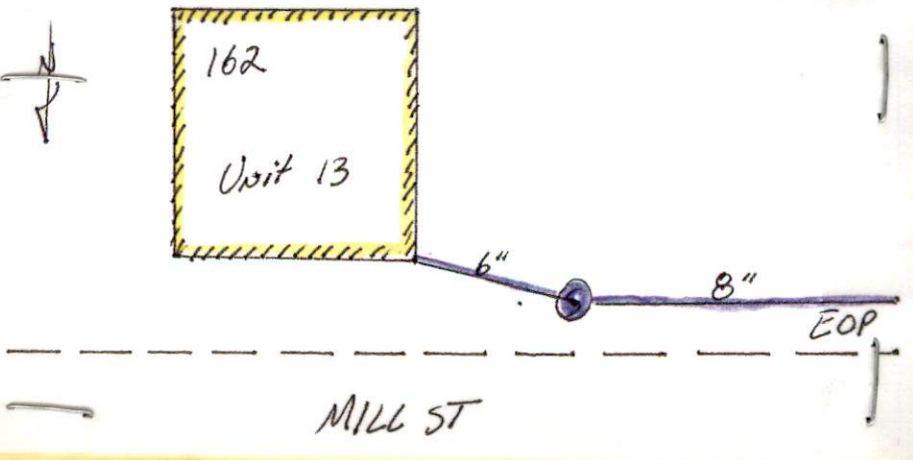





PERMIT NO.

23978

CITY OF NEW BEDFORD  
SEWER AND/OR STORM DRAIN PERMIT

DATE 7/6/07

This certifies that permission is granted to

N.B. Housing Authority 725 Pleasant St NB 508-997-4852  
Property Owner Address unit 13 46' w x Cottage St Tel.

To connect a sewer and/or storm drain located at 162 Mill St (on private property) & Cottage St (on private property) adj  
Assessor's Plot 58 Lot 3.7.7, to the sewer and/or storm drain in        Street

To be laid in accordance with the conditions in this application and the City of New Bedford ordinances. see

TYPE OF USE: ☒ RESIDENTIAL ☐ COMMERCIAL ☐ INDUSTRIAL FLOW 23951 G.P.D.

If applicant other than actual property owner, attach Letter of Authorization from Property Owner.

Name Joseph Woodall Tel. 508-520-9733

Mailing Address 182 Seehawk St Norfolk Ma

The Bonded Contractor/Drain Layer authorized to perform this work is:

Joe Woodall & Sons Const Co Inc 182 Seehawk St Norfolk Ma

Name        Address        Tel.       

Type of Pipe Required: sdn 35 pvc 508.520.97.33

PERMIT EXPIRES ONE YEAR AFTER DATE OF ISSUE

- Requires separate connections for sewage and storm drain where applicable. Storm water cannot be discharged to a sanitary sewer.
- All work must be inspected and approved by a D.P.I. inspector before backfilling.
- If this connection is to be part of a private service shared jointly with other building owners, attach copy of Recorded Joint Maintenance Agreement.
- Permits can be issued to Industrial and/or Commercial Applicants only upon receipt and approval by the Commissioner of Public Infrastructure of required plans and supplemental information.
- In addition, a City-issued Industrial User Discharge Permit and/or a Sewer Extension/Connection Permit issued by the Commonwealth of Massachusetts D.E.P. shall be required by the City for Industrial Discharge into the sewer system.

Industrial User Discharge Permit No.        Date       

Comm. Mass. Sewer Conn./Ext. Permit No.        Date       

A Filing and Inspection Fee of \$150.00 plus an Entrance Fee of \$ 7 where applicable, must accompany this application.

Bank# Sovereign Bank Check# 20800 Date 7/6/07 Receipt# 7278

Other requirements: 24 hr inspection at 508.979.1528

Construct per approved plans

Connection made to Sewer Part of jointly-shared private line YES NO  
Storm Drain

Applicant agrees to abide by the above terms, as well as all pertinent ordinances of the City of New Bedford, and such other special rules as the Commissioner of Public Infrastructure and/or City Engineer may deem necessary.

Dante M. Andraski  
Acting City Engineer mn

        
Signature of Property Owner or Representative

INSPECTOR'S REPORT

INSPECTED BY:         
DATE:         
COMMENTS:       

APPROVED

DISAPPROVED

SIGNATURE

SKETCH PLAN



# CITY OF NEW BEDFORD

965

No. 610 07

LICENSE NO. \_\_\_\_\_

DATE 5/9 20 07

## FOUNDATION PERMIT

MSBC Sect. 111.8 - Any permit issued shall be deemed abandoned and invalid unless the work authorized by it shall have been commenced within six (6) months after its issuance.

This certifies that J. J. CARDOS, owner/contractor  
has permission to FOUNDATION 25' X 22'  
on MILL ST. PLOT 58 LOT 377 UNIT # 13

providing that the person accepting this permit shall in every respect conform to the terms of the application therefor on file in this office; to the provisions of the Statute of the Commonwealth and to the By-Laws of the City of New Bedford relating to the Inspection, Erection, Enlarging, Altering, Raising, Moving, Repairing or Tearing Down of a Building.

WIRING INSPECTOR

PLUMBING INSPECTOR

BUILDING INSPECTOR

ROUGH FINISH

YOUR AREA INSPECTOR IS: JIM BEWBE

- Tel. 979-1540 Between 8:00 AM - 9:00 AM

NOTICE: NOTIFY INSPECTOR 48 HOURS  
IN ADVANCE OF APPLYING  
SHEATING OR LATHING

### OCCUPANCY PERMIT REQUIRED BEFORE OCCUPANCY

No Building or Structure shall be used or occupied until the Certificate of Use and Occupancy shall have been issued by the Building Commissioner - MSBC. Sect. 120.1 - N.B. Zoning Ord. Sect. 9-269

THIS CARD MUST BE DISPLAYED IN A CONSPICUOUS PLACE ON THE PREMISES  
AND NOT TORN DOWN OR REMOVED UNTIL COMPLETION OF WORK

SUBJECT TO MASSACHUSETTS STATE  
BUILDING CODE REQUIREMENTS

  
BUILDING INSPECTOR



## New Bedford Housing Authority

Modernization Office

725 Pleasant Street

New Bedford, Massachusetts 02740

JOSEPH S. FINNERTY  
Executive Director

TEL: 508-997-4852  
FAX: 508-997-4825  
TDD: 508-997-4874

---

April 30, 2007

Mr. Ronald LaBelle  
Dept. of Public Infrastructure  
1105 Shawmut Ave.  
New Bedford, Ma 02740

Dear Mr. LaBelle,

I, Richard Walega of the New Bedford Housing Authority authorize Joe Woodall and Sons to acquire necessary permits for the site work for the Mill Street Housing Project.

Sincerely,

Richard Walega  
Deputy Director of Modernization