



PERMIT NO.  
23981

CITY OF NEW BEDFORD  
SEWER AND/OR STORM DRAIN PERMIT

DATE 7-6-07

This certifies that permission is granted to

Property Owner N.B. Housing Authority Address 725 Pleasant St. N.B. Tel. 508-997-4852  
1821 W X

To connect a sewer and/or storm drain located at 170 Mill St Unit 10 Cottage St

Assessor's Plot 58 Lot 377, to the sewer and/or storm drain in S Mill St (on private property) Street

To be laid in accordance with the conditions in this application and the City of New Bedford ordinances.

TYPE OF USE: RESIDENTIAL COMMERCIAL INDUSTRIAL FLOW G.P.D. See Sewer permit # 23951

If applicant other than actual property owner, attach Letter of Authorization from Property Owner.

Name Joseph Woodall Tel. 508-520-9733  
Mailing Address 182 Seaboard St Norfolk Ma

The Bonded Contractor/Drain Layer authorized to perform this work is:

Name Joe Woodall & Sons Const Co Inc Address 182 Seaboard St Norfolk, MA Tel. 508-520-9733  
Type of Pipe Required: SDR 35 PVC

PERMIT EXPIRES ONE YEAR AFTER DATE OF ISSUE

- Requires separate connections for sewage and storm drain where applicable. Storm water cannot be discharged to a sanitary sewer.
- All work must be inspected and approved by a D.P.I. inspector before backfilling.
- If this connection is to be part of a private service shared jointly with other building owners, attach copy of Recorded Joint Maintenance Agreement.
- Permits can be issued to Industrial and/or Commercial Applicants only upon receipt and approval by the Commissioner of Public Infrastructure of required plans and supplemental information.
- In addition, a City-issued Industrial User Discharge Permit and/or a Sewer Extension/Connection Permit issued by the Commonwealth of Massachusetts D.E.P. shall be required by the City for Industrial Discharge into the sewer system.

Industrial User Discharge Permit No. \_\_\_\_\_ Date \_\_\_\_\_

Comm. Mass. Sewer Conn./Ext. Permit No. \_\_\_\_\_ Date \_\_\_\_\_

A Filing and Inspection Fee of \$ 150.00 plus an Entrance Fee of \$ - where applicable, must accompany this application.

Bank# sovereign Bank Check# 20800 Date 7-6-07 Receipt# 7278

Other requirements: 24 hour notice for inspection @ 508-979-1527 Construct

per approved plans

Connection made to Sewer Part of jointly-shared private line YES NO  
Storm Drain


Applicant agrees to abide by the above terms, as well as all pertinent ordinances of the City of New Bedford, and such other special rules as the Commissioner of Public Infrastructure and/or City Engineer may deem necessary

City Engineer Dwight M. Andrade Signature of Property Owner or Representative [Signature]

INSPECTOR'S REPORT

INSPECTED BY: Kevin Cornell  
DATE: 7/10/07  
COMMENTS: \_\_\_\_\_

APPROVED [Signature] DISAPPROVED \_\_\_\_\_  
SIGNATURE

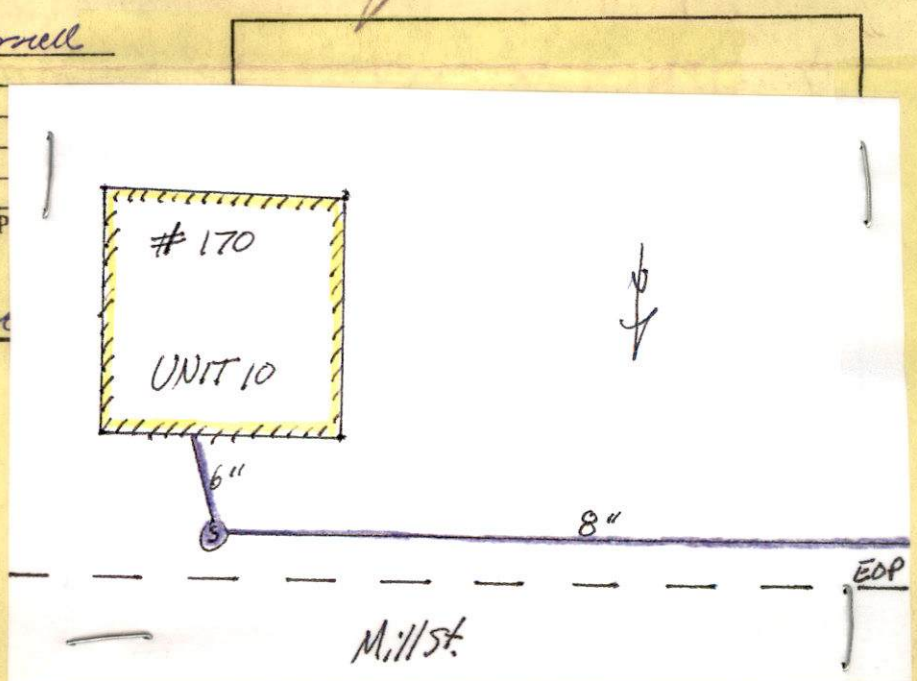





PERMIT NO.  
23981

CITY OF NEW BEDFORD  
SEWER AND/OR STORM DRAIN PERMIT

DATE 7-6-07

This certifies that permission is granted to

N.B. Housing Authority 725 Pleasant St. NB 508-997-4852  
Property Owner Address Tel. 182' W X

To connect a sewer and/or storm drain located at 170 Mill St. Unit 10 Co. Hage St.

Assessor's Plot 58 Lot 377, to the sewer and/or storm drain in S Mill St (Private property) Street  
SD Cottage St (on private property)

To be laid in accordance with the conditions in this application and the City of New Bedford ordinances.

TYPE OF USE: RESIDENTIAL COMMERCIAL INDUSTRIAL FLOW G.P.D. See  
Sewer permit  
#23951

If applicant other than actual property owner, attach Letter of Authorization from Property Owner.

Name Joseph Woodall Tel. 508-520-9733  
Mailing Address 182 Seekonk St. Norfolk Ma

The Bonded Contractor/Drain Layer authorized to perform this work is:

Joe Woodall & Sons Const. Co. Inc. 182 Seekonk St. Norfolk, MA  
Name Address Tel. 508-520-9733  
Type of Pipe Required: SDR 35 PVC

PERMIT EXPIRES ONE YEAR AFTER DATE OF ISSUE

- Requires separate connections for sewage and storm drain where applicable. Storm water cannot be discharged to a sanitary sewer.
  - All work must be inspected and approved by a D.P.I. inspector before backfilling.
  - If this connection is to be part of a private service shared jointly with other building owners, attach copy of Recorded Joint Maintenance Agreement.
  - Permits can be issued to Industrial and/or Commercial Applicants only upon receipt and approval by the Commissioner of Public Infrastructure of required plans and supplemental information.
  - In addition, a City-issued Industrial User Discharge Permit and/or a Sewer Extension/Connection Permit issued by the Commonwealth of Massachusetts D.E.P. shall be required by the City for Industrial Discharge into the sewer system.
- Industrial User Discharge Permit No. \_\_\_\_\_ Date \_\_\_\_\_

Comm. Mass. Sewer Conn./Ext. Permit No. \_\_\_\_\_ Date \_\_\_\_\_

A Filing and Inspection Fee of \$150.00 plus an Entrance Fee of \$\_\_\_\_\_ where applicable, must accompany this application.

Bank# Sovereign Check# 20800 Date 7-6-07 Receipt# 7278  
Bank Notice for

Other requirements: 24 hour inspection C. 508-979-1527-Construct  
Per approved Plans

Connection made to Sewer Part of jointly-shared private line YES NO  
Storm Drain

Applicant agrees to abide by the above terms, as well as all pertinent ordinances of the City of New Bedford, and such other special rules as the Commissioner of Public Infrastructure and/or City Engineer may deem necessary.

Dwight M. Andrade  
City Engineer

[Signature]  
Signature of Property Owner or Representative

INSPECTOR'S REPORT

INSPECTED BY: \_\_\_\_\_  
DATE: \_\_\_\_\_  
COMMENTS: \_\_\_\_\_

APPROVED \_\_\_\_\_ DISAPPROVED \_\_\_\_\_

SIGNATURE

SKETCH PLAN

## New Bedford Housing Authority

Modernization Office

725 Pleasant Street

New Bedford, Massachusetts 02740

JOSEPH S. FINNERTY  
Executive Director

TEL: 508-997-4852  
FAX: 508-997-4825  
TDD: 508-997-4874

---

April 30, 2007

Mr. Ronald LaBelle  
Dept. of Public Infrastructure  
1105 Shawmut Ave.  
New Bedford, Ma 02740

Dear Mr. LaBelle,

I, Richard Walega of the New Bedford Housing Authority authorize Joe Woodall and Sons to acquire necessary permits for the site work for the Mill Street Housing Project.

Sincerely,



Richard Walega  
Deputy Director of Modernization



# CITY OF NEW BEDFORD

962

NO. 607 07

LICENSE NO. \_\_\_\_\_

DATE 5/7 20 07

## FOUNDATION PERMIT

MSBC Sect. 111.8 – Any permit issued shall be deemed abandoned and invalid unless the work authorized by it shall have been commenced within six (6) months after its issuance.

This certifies that J. J. CARDOSI, owner/contractor  
has permission to FOUNDATION 26.5 x 22'  
on MILL ST. PLOT 58 LOT 377 UNIT # 10

providing that the person accepting this permit shall in every respect conform to the terms of the application therefor on file in this office; to the provisions of the Statute of the Commonwealth and to the By-Laws of the City of New Bedford relating to the Inspection, Erection, Enlarging, Altering, Raising, Moving, Repairing or Tearing Down of a Building.

WIRING INSPECTOR

PLUMBING INSPECTOR

BUILDING INSPECTOR

ROUGH FINISH

YOUR AREA INSPECTOR IS: JIM BERNICE

- Tel. 979-1540 Between 8:00 AM - 9:00 AM


NOTICE: NOTIFY INSPECTOR 48 HOURS  
IN ADVANCE OF APPLYING  
SHEATING OR LATHING

### OCCUPANCY PERMIT REQUIRED BEFORE OCCUPANCY

No Building or Structure shall be used or occupied until the Certificate of Use and Occupancy shall have been issued by the Building Commissioner – MSBC. Sect. 120.1 – N.B. Zoning Ord. Sect. 9-269

THIS CARD MUST BE DISPLAYED IN A CONSPICUOUS PLACE ON THE PREMISES  
AND NOT TORN DOWN OR REMOVED UNTIL COMPLETION OF WORK

SUBJECT TO MASSACHUSETTS STATE  
BUILDING CODE REQUIREMENTS

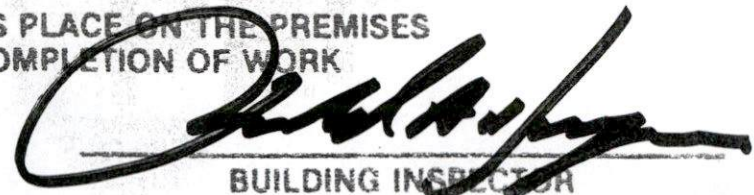  
BUILDING INSPECTOR