



PERMIT NO.

23983

CITY OF NEW BEDFORD
SEWER AND/OR STORM DRAIN PERMIT

DATE 7-6-07

This certifies that permission is granted to

Property Owner N.B. Housing Authority Address 725 Pleasant St. N.B. Tel. 508-997-4852

To connect a sewer and/or storm drain located at 174 Mill St Unit 8 Cottage St.

Assessor's Plot 58 Lot 377, to the sewer and/or storm drain in 5 Mill St (Private Property) Street

To be laid in accordance with the conditions in this application and the City of New Bedford ordinances.

TYPE OF USE: RESIDENTIAL COMMERCIAL INDUSTRIAL FLOW ✓ G.P.D. See Sewer Permit #23951

If applicant other than actual property owner, attach Letter of Authorization from Property Owner.

Name Joseph Woodall Tel. 508-520-9733

Mailing Address 182 Seaboard St. Norfolk, MA

The Bonded Contractor/Drain Layer authorized to perform this work is:

Name Joe Woodall & Son, Contract Co. Inc. Address 182 Seaboard St. Norfolk, MA Tel. 508-520-9733

Type of Pipe Required: SDR-35 PVC

PERMIT EXPIRES ONE YEAR AFTER DATE OF ISSUE

- Requires separate connections for sewage and storm drain where applicable. Storm water cannot be discharged to a sanitary sewer.
 - All work must be inspected and approved by a D.P.I. inspector before backfilling.
 - If this connection is to be part of a private service shared jointly with other building owners, attach copy of Recorded Joint Maintenance Agreement.
 - Permits can be issued to Industrial and/or Commercial Applicants only upon receipt and approval by the Commissioner of Public Infrastructure of required plans and supplemental information.
 - In addition, a City-issued Industrial User Discharge Permit and/or a Sewer Extension/Connection Permit issued by the Commonwealth of Massachusetts D.E.P. shall be required by the City for Industrial Discharge into the sewer system.
- Industrial User Discharge Permit No. _____ Date _____

Comm. Mass. Sewer Conn./Ext. Permit No. _____ Date _____

A Filing and Inspection Fee of \$ 150.00, plus an Entrance Fee of \$ _____ where applicable, must accompany this application.

Bank# Sovereign Bank Check# 20800 Date 7-6-07 Receipt# 7278

Other requirements: 24 hour notice for inspection @ 508-979-1527

Construct per approved plans

Connection made to Sewer Part of jointly-shared private line YES NO
Storm Drain

Applicant agrees to abide by the above terms, as well as all pertinent ordinances of the City of New Bedford, and such other special rules as the Commissioner of Public Infrastructure and/or City Engineer may deem necessary

City Engineer Duarte M. Andrade Signature of Property Owner or Representative [Signature]


INSPECTOR'S REPORT

INSPECTED BY: Kevin Cornell
DATE: 7/10/07
COMMENTS:

APPROVED

DISA

Kevin Cornell
SIGNATURE

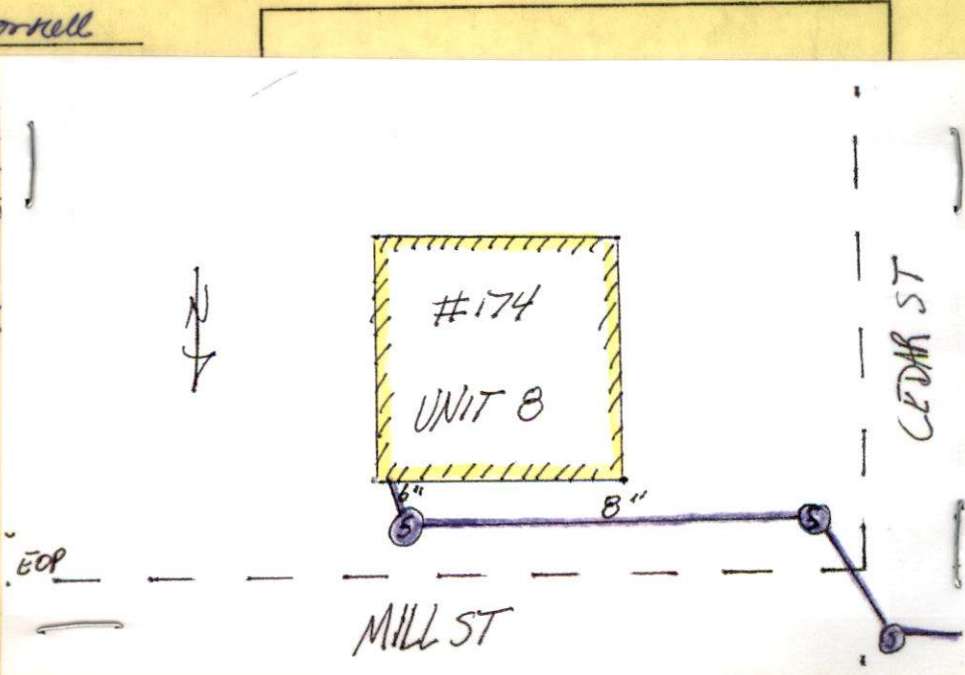



PERMIT NO.
23983

CITY OF NEW BEDFORD
SEWER AND/OR STORM DRAIN PERMIT

DATE 7-6-07

This certifies that permission is granted to

N.B. Housing Authority 725 Pleasant St. NB 508-997-4852
Property Owner Address Tel. 264' W X

To connect a sewer and/or storm drain located at 174 Mill St. Unit 8 Cottage St.

Assessor's Plot 58 Lot 377, to the sewer and/or storm drain in 5 - Mill St. (Private Property) Street

To be laid in accordance with the conditions in this application and the City of New Bedford ordinances.

TYPE OF USE: RESIDENTIAL COMMERCIAL INDUSTRIAL FLOW ✓ G.P.D. Sewer See Permit # 23951

If applicant other than actual property owner, attach Letter of Authorization from Property Owner.

Name Joseph Woodall Tel. 508-520-9733
Mailing Address 182 Seekonk St. Norfolk MA

The Bonded Contractor/Drain Layer authorized to perform this work is:

Joe Woodall & Son Const. Co. Inc. 182 Seekonk St. Norfolk MA
Name Address Tel. 508-520-9733
Type of Pipe Required: SDR-35 PVC

PERMIT EXPIRES ONE YEAR AFTER DATE OF ISSUE

- Requires separate connections for sewage and storm drain where applicable. Storm water cannot be discharged to a sanitary sewer.
- All work must be inspected and approved by a D.P.I. inspector before backfilling.
- If this connection is to be part of a private service shared jointly with other building owners, attach copy of Recorded Joint Maintenance Agreement.
- Permits can be issued to Industrial and/or Commercial Applicants only upon receipt and approval by the Commissioner of Public Infrastructure of required plans and supplemental information.
- In addition, a City-issued Industrial User Discharge Permit and/or a Sewer Extension/Connection Permit issued by the Commonwealth of Massachusetts D.E.P. shall be required by the City for Industrial Discharge into the sewer system.

Industrial User Discharge Permit No. _____ Date _____

Comm. Mass. Sewer Conn./Ext. Permit No. _____ Date _____

A Filing and Inspection Fee of \$ 150.00, plus an Entrance Fee of \$ _____ where applicable, must accompany this application.

Bank# Bank Check# 20800 Date 7-6-07 Receipt# 7278

Other requirements: 24 hour notice for inspection @ 508-979-1527

Construct per approved plans:

Connection made to Sewer Part of jointly-shared private line YES NO
Storm Drain

Applicant agrees to abide by the above terms, as well as all pertinent ordinances of the City of New Bedford, and such other special rules as the Commissioner of Public Infrastructure and/or City Engineer may deem necessary.

Duarte M. Andrade
City Engineer

[Signature]
Signature of Property Owner or Representative


INSPECTOR'S REPORT

INSPECTED BY: _____
DATE: _____
COMMENTS: _____

APPROVED

DISAPPROVED

SIGNATURE

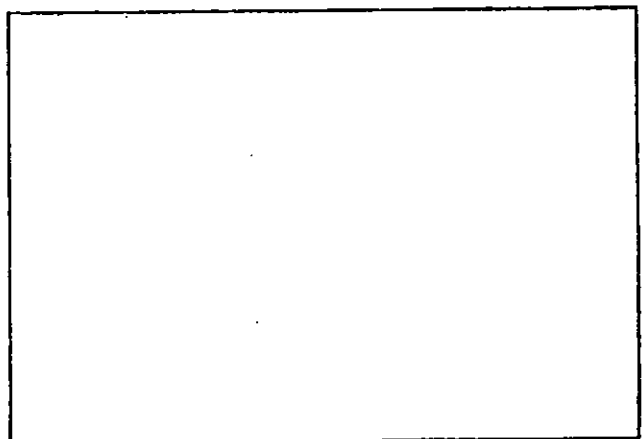

SKETCH PLAN

New Bedford Housing Authority

Modernization Office
725 Pleasant Street
New Bedford, Massachusetts 02740

JOSEPH S. FINNERTY
Executive Director

TEL: 508-997-4852
FAX: 508-997-4825
TDD: 508-997-4874

April 30, 2007

Mr. Ronald LaBelle
Dept. of Public Infrastructure
1105 Shawmut Ave.
New Bedford, Ma 02740

Dear Mr. LaBelle,

I, Richard Walega of the New Bedford Housing Authority authorize Joe Woodall and Sons to acquire necessary permits for the site work for the Mill Street Housing Project.

Sincerely,



Richard Walega
Deputy Director of Modernization



CITY OF NEW BEDFORD

960

NO. 605-07 LICENSE NO. _____DATE 5/8 20 07

FOUNDATION PERMIT

MSBC Sect. 111.8 – Any permit issued shall be deemed abandoned and invalid unless the work authorized by it shall have been commenced within six (6) months after its issuance.

This certifies that J. J. CARDOSI, owner/contractor
has permission to FOUNDATION 25'x22'
on MILL ST. PLOT-58 LOT 377 UNIT #8

providing that the person accepting this permit shall in every respect conform to the terms of the application therefor on file in this office; to the provisions of the Statute of the Commonwealth and to the By-Laws of the City of New Bedford relating to the Inspection, Erection, Enlarging, Altering, Raising, Moving, Repairing or Tearing Down of a Building.

WIRING INSPECTOR

PLUMBING INSPECTOR

BUILDING INSPECTOR

ROUGH FINISH

YOUR AREA INSPECTOR IS: Jimm BERNBE

– Tel. 979-1540 Between 8:00 AM – 9:00 AM

NOTICE: NOTIFY INSPECTOR 48 HOURS
IN ADVANCE OF APPLYING
SHEATING OR LATHING

OCCUPANCY PERMIT REQUIRED BEFORE OCCUPANCY

No Building or Structure shall be used or occupied until the Certificate of Use and Occupancy shall have been issued by the Building Commissioner – MSBC. Sect. 120.1 – N.B. Zoning Ord. Sect. 9-269

THIS CARD MUST BE DISPLAYED IN A CONSPICUOUS PLACE ON THE PREMISES
AND NOT TORN DOWN OR REMOVED UNTIL COMPLETION OF WORK

SUBJECT TO MASSACHUSETTS STATE
BUILDING CODE REQUIREMENTS

BUILDING INSPECTOR