



PERMIT NO.
24000

CITY OF NEW BEDFORD
SEWER AND/OR STORM DRAIN PERMIT

DATE 8/24/07
EXP 8/24/08

This certifies that permission is granted to

Property Owner Alm Niles Man. Piller LLC Address P.O. Box 72549 Dart. MA 02747 Tel. (508) 725-0727

To connect a sewer and/or storm drain located at 150 John Vertente Blvd., Dartmouth
Assessor's Plot 85 Lot 8-2, to the sewer and/or storm drain in John Vertente Blvd (12") Street

To be laid in accordance with the conditions in this application and the City of New Bedford ordinances.

TYPE OF USE: RESIDENTIAL COMMERCIAL INDUSTRIAL FLOW _____ G.P.D.

If applicant other than actual property owner, attach Letter of Authorization from Property Owner.

Name N/A Tel. _____
Mailing Address _____

The Bonded Contractor/Drain Layer authorized to perform this work is:

Fernando Construction 80 Main St. Acushnet MA (508) 328-0383
Name _____ Address _____ Tel. _____
Type of Pipe Required: 6" SDR 35

* PERMIT EXPIRES ONE YEAR AFTER DATE OF ISSUE

- Requires separate connections for sewage and storm drain where applicable. Storm water cannot be discharged to a sanitary sewer.
 - All work must be inspected and approved by a D.P.I. inspector before backfilling.
 - If this connection is to be part of a private service shared jointly with other building owners, attach copy of Recorded Joint Maintenance Agreement.
 - Permits can be issued to Industrial and/or Commercial Applicants only upon receipt and approval by the Commissioner of Public Infrastructure of required plans and supplemental information.
 - In addition, a City-issued Industrial User Discharge Permit and/or a Sewer Extension/Connection Permit issued by the Commonwealth of Massachusetts D.E.P. shall be required by the City for Industrial Discharge into the sewer system.
- Industrial User Discharge Permit No. Construction 11/1/07 Date Not needed

Comm. Mass. Sewer Conn./Ext. Permit No. _____ Date _____
A Filing and Inspection Fee of \$ 150, plus an Entrance Fee of \$ 680 where applicable, must accompany this application.

Bank# Bank of America Check# 1731 Date 8/24/07 Receipt# 7409

Other requirements: 170' x \$4/L.F. = \$680. Extension + \$150. Permit \$230.00
MUST call for inspection - 24hr notice required (508) 777-1526

Connection made to Sewer Part of jointly-shared private line YES NO
Storm Drain

Applicant agrees to abide by the above terms, as well as all pertinent ordinances of the City of New Bedford, and such other special rules as the Commissioner of Public Infrastructure and/or City Engineer may deem necessary

Quante 2nd District / 1004
City Engineer

X Alm Niles
Signature of Property Owner or Representative

INSPECTOR'S REPORT


INSPECTED BY: Bob Bichel
DATE: 11/30/2007
COMMENTS: _____

APPROVED

DISAPPROVED

SIGNATURE

See attached.

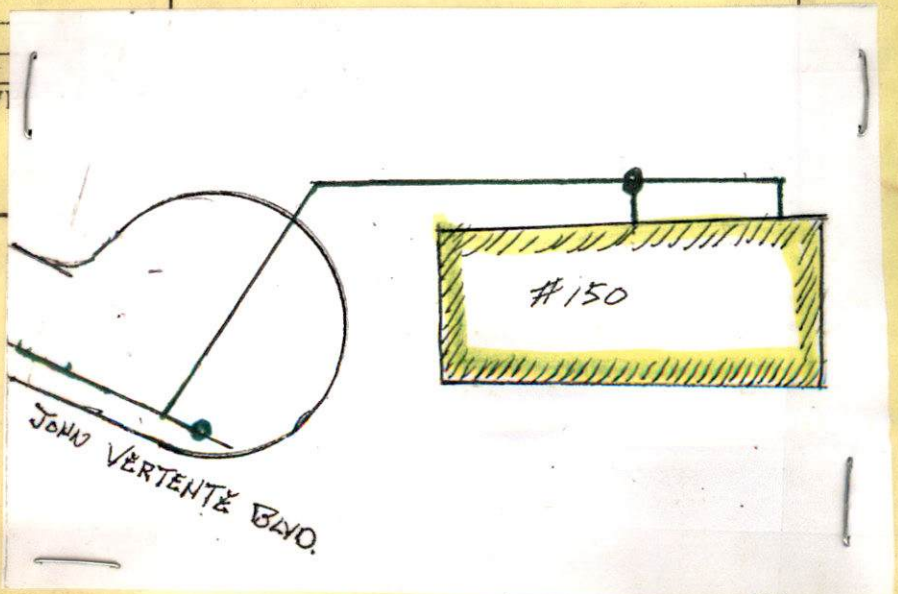



PERMIT NO.

24000

CITY OF NEW BEDFORD
SEWER AND/OR STORM DRAIN PERMIT

DATE 8/24/07
EXP 8/24/08

This certifies that permission is granted to

Alan Alves, mgr. Pillar LLC P.O. Box 79549 Dart. MA 02747
Property Owner Address Tel. (508) 955-0729

To connect a sewer and/or storm drain located at 150 John Verlande Blvd., Dartmouth
Dart.
Assessor's Plot 85 Lot 8-2 to the sewer and/or storm drain in John Verlande Blvd (12") Street

To be laid in accordance with the conditions in this application and the City of New Bedford ordinances.

TYPE OF USE: RESIDENTIAL COMMERCIAL INDUSTRIAL FLOW _____ G.P.D.

If applicant other than actual property owner, attach Letter of Authorization from Property Owner.

Name N/A Tel. _____

Mailing Address _____

The Bonded Contractor/Drain Layer authorized to perform this work is:

Fernandes Construction 80 Main St. Acushnet MA (508) 328-0383

Name Address Tel.

Type of Pipe Required: 6" SDR Sewer

* **PERMIT EXPIRES ONE YEAR AFTER DATE OF ISSUE**

- Requires separate connections for sewage and storm drain where applicable. Storm water cannot be discharged to a sanitary sewer.
- All work must be inspected and approved by a D.P.I. inspector before backfilling.
- If this connection is to be part of a private service shared jointly with other building owners, attach copy of Recorded Joint Maintenance Agreement.
- Permits can be issued to Industrial and/or Commercial Applicants only upon receipt and approval by the Commissioner of Public Infrastructure of required plans and supplemental information.
- In addition, a City-issued Industrial User Discharge Permit and/or a Sewer Extension/Connection Permit issued by the Commonwealth of Massachusetts D.E.P. shall be required by the City for Industrial Discharge into the sewer system.

Industrial User Discharge Permit No. Construction Warehouse Date _____
not needed

Comm. Mass. Sewer Conn./Ext. Permit No. _____ Date _____

A Filing and Inspection Fee of \$ 150, plus an Entrance Fee of \$ 680 where applicable, must accompany this application.

Bank# Bank of America Check# 1731 Date 8/24/07 Receipt# 7409

Other requirements: 170' x \$4/L.F. = \$680. Extension + \$150. Permit = \$830.00

Must call for inspection - 24 hr notice required (508) 979-1526

Connection made to Sewer Part of jointly-shared private line YES NO
Storm Drain

Applicant agrees to abide by the above terms, as well as all pertinent ordinances of the City of New Bedford, and such other special rules as the Commissioner of Public Infrastructure and/or City Engineer may deem necessary


Quarte M. Andrade, Josc City Engineer
X Alan Alves Signature of Property Owner or Representative

INSPECTOR'S REPORT

INSPECTED BY: _____
DATE: _____
COMMENTS: _____

APPROVED _____ DISAPPROVED _____

SIGNATURE

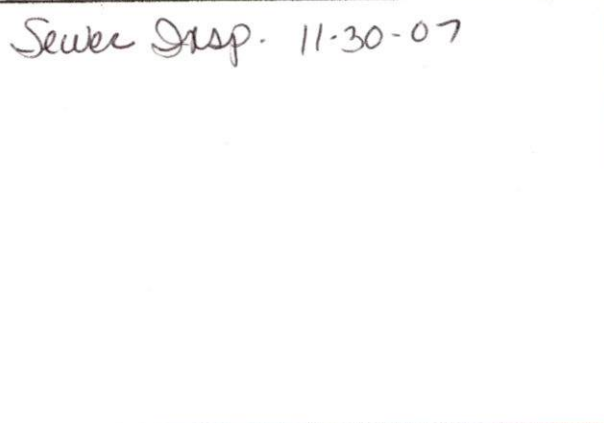

SKETCH PLAN



Inspector's Copy
Pillar LLC

P.IIA
DETAIL

PERMIT NO.

24000

CITY OF NEW BEDFORD
SEWER AND/OR STORM DRAIN PERMIT

DATE 8/24/07
EXP 8/24/08

This certifies that permission is granted to

Alan Alves, Mgr. Pillar LLC P.O. Box 79549 Dart. MA 02747
Property Owner Address Tel. (508) 955-0729

To connect a sewer and/or storm drain located at 150 John Verhulst Blvd., Dartmouth
Dart.
Assessor's Plot 85 Lot 8-2, to the sewer and/or storm drain in John Verhulst Blvd (12") Street

To be laid in accordance with the conditions in this application and the City of New Bedford ordinances.

TYPE OF USE: RESIDENTIAL COMMERCIAL INDUSTRIAL FLOW G.P.D.

If applicant other than actual property owner, attach Letter of Authorization from Property Owner.

Name N/A Tel. To be provided at time of inspection

Mailing Address

The Bonded Contractor/Drain Layer authorized to perform this work is:

Fernandes Construction 80 Main St. Acushnet MA (508) 328-0383

Name Address Tel.

Type of Pipe Required: 6" SDR Sewer

* PERMIT EXPIRES ONE YEAR AFTER DATE OF ISSUE

- Requires separate connections for sewage and storm drain where applicable. Storm water cannot be discharged to a sanitary sewer.
- All work must be inspected and approved by a D.P.I. inspector before backfilling.
- If this connection is to be part of a private service shared jointly with other building owners, attach copy of Recorded Joint Maintenance Agreement.
- Permits can be issued to Industrial and/or Commercial Applicants only upon receipt and approval by the Commissioner of Public Infrastructure of required plans and supplemental information.
- In addition, a City-issued Industrial User Discharge Permit and/or a Sewer Extension/Connection Permit issued by the Commonwealth of Massachusetts D.E.P. shall be required by the City for Industrial Discharge into the sewer system.

Industrial User Discharge Permit No. Construction/Warehouse Date Not needed.

Comm. Mass. Sewer Conn./Ext. Permit No. Date

A Filing and Inspection Fee of \$150, plus an Entrance Fee of \$680, where applicable, must accompany this application.

Bank# Bank of America Check# 1731 Date 8/24/07 Receipt# 7409

Other requirements: 170' x \$4/L.F. = \$680. Extension + \$150. Permit \$830.00

MUST call for inspection - 74 hr notice required (508) 979-1526

Connection made to Sewer Part of jointly-shared private line YES NO
Storm Drain

Applicant agrees to abide by the above terms, as well as all pertinent ordinances of the City of New Bedford, and such other special rules as the Commissioner of Public Infrastructure and/or City Engineer may deem necessary

Quarte M. Andrade, Jr. City Engineer
Signature of Property Owner or Representative

INSPECTOR'S REPORT

INSPECTED BY: Bob Bichel
DATE: 11/30/07

COMMENTS:

DROP MH SCENERO
ON FLOOR DRAIN CONNECTION

APPROVED DISAPPROVED

SIGNATURE

Sewer Insp. 11-30-07
Friday @ 9:00

SKETCH PLAN



PILLAR LLC

Alan Alves
Manager

P.O. BOX 79549
DARTMOUTH, MA 02747

Phone/Fax 508-995-0729
Mobile 508-328-7877
asa@pillarllc.net

