



PERMIT NO.

24003

CITY OF NEW BEDFORD  
SEWER AND/OR STORM DRAIN PERMIT

DATE 9/5/07

This certifies that permission is granted to

Stephen Ricciardi 218 Willard St. Quincy MA 617 828 2543  
Property Owner Address Tel. N.E.C. Wamsutta St/  
Acushnet Ave.To connect a sewer and/or storm drain located at Wamsutta Street (sewer)  
Storm drain in private property

Assessor's Plot 78 Lot 219, to the sewer and/or storm drain in Wamsutta St. Street

To be laid in accordance with the conditions in this application and the City of New Bedford ordinances.

TYPE OF USE: ☒ RESIDENTIAL ☐ COMMERCIAL ☐ INDUSTRIAL FLOW 38000 G.P.D. 350 bedrooms

If applicant other than actual property owner, attach Letter of Authorization from Property Owner.

Name Alan Caldwell Tel. 617-479-2424

Mailing Address 218 Willard Street Quincy, MA 02169

The Bonded Contractor/Drain Layer authorized to perform this work is:

P.A. Landers, Inc. 351 Winter St. Haverhill MA 781 826 8818

Name Address Tel.

Type of Pipe Required: SDR 35 PVC

## PERMIT EXPIRES ONE YEAR AFTER DATE OF ISSUE

- Requires separate connections for sewage and storm drain where applicable. Storm water cannot be discharged to a sanitary sewer.
- All work must be inspected and approved by a D.P.I. inspector before backfilling.
- If this connection is to be part of a private service shared jointly with other building owners, attach copy of Recorded Joint Maintenance Agreement.
- Permits can be issued to Industrial and/or Commercial Applicants only upon receipt and approval by the Commissioner of Public Infrastructure of required plans and supplemental information.
- In addition, a City-issued Industrial User Discharge Permit and/or a Sewer Extension/Connection Permit issued by the Commonwealth of Massachusetts D.E.P. shall be required by the City for Industrial Discharge into the sewer system.

Industrial User Discharge Permit No. Date

Comm. Mass. Sewer Conn./Ext. Permit No. Date

A Filing and Inspection Fee of \$150.00 plus an Entrance Fee of \$ where applicable, must accompany this application.

Bank# Sovereign Bank Check# 1756 Date 8/31/07 Receipt# 7434

Other requirements: 24 hr inspection notice at 508.979.527. Sewer connection to existing service line and install smh and box culvert for drainage. S. Porter has issued order of conditions.

Connection made to Sewer Part of jointly-shared private line YES ☒ NO  
Storm Drain

Applicant agrees to abide by the above terms, as well as all pertinent ordinances of the City of New Bedford, and such other special rules as the Commissioner of Public Infrastructure and/or City Engineer may deem necessary

Duarte M. Andrade  
Acting City Engineer

Signature of Property Owner or Representative

Alan Caldwell - Project Manager

## INSPECTOR'S REPORT

INSPECTED BY:


DATE:

COMMENTS:

APPROVED

D

SIGNATURE

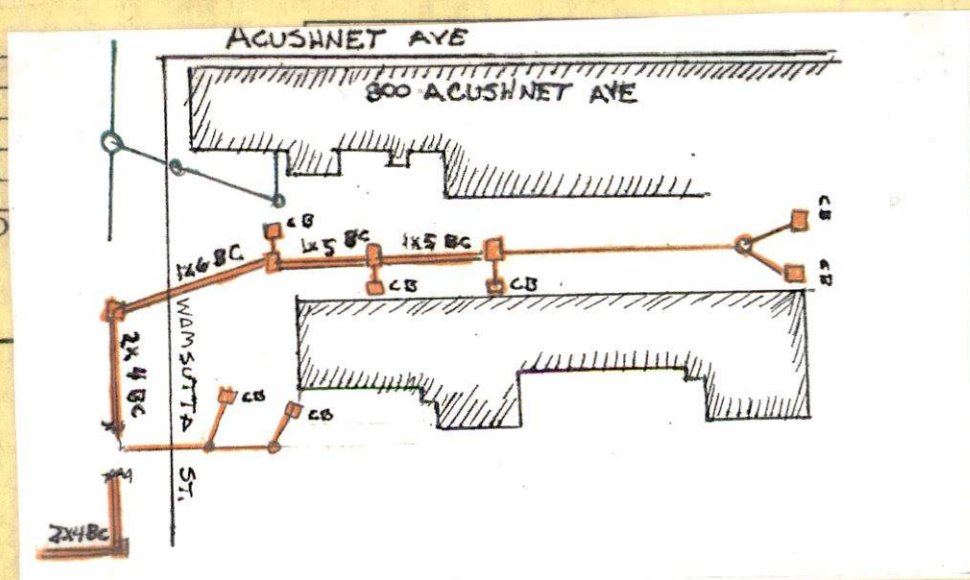





PERMIT NO.  
24003

CITY OF NEW BEDFORD  
SEWER AND/OR STORM DRAIN PERMIT

DATE 9/5/07

This certifies that permission is granted to

Stephen Ricciardi 218 Willard St Quincy MA 617 828 2523  
Property Owner Address Tel. N.E.C. Wamsutta St/  
Acushnet Ave.

To connect a sewer and/or storm drain located at Wamsutta Street (sewer).  
Storm drain in private property

Assessor's Plot 78 Lot 219 to the sewer and/or storm drain in Wamsutta St Street

To be laid in accordance with the conditions in this application and the City of New Bedford ordinances. 350 bedrooms  
TYPE OF USE: ☒ RESIDENTIAL ☐ COMMERCIAL ☐ INDUSTRIAL FLOW 38000 G.P.D.

If applicant other than actual property owner, attach Letter of Authorization from Property Owner.

Name Alan Caldwell Tel. 617-479-2424  
Mailing Address 218 Willard Street Quincy, MA 02169

The Bonded Contractor/Drain Layer authorized to perform this work is:

P.A. Landers, Inc. 351 Winter St Hanover MA 781 826 8818  
Name Address Tel.

Type of Pipe Required: SDR 35 PVC

PERMIT EXPIRES ONE YEAR AFTER DATE OF ISSUE

- Requires separate connections for sewage and storm drain where applicable. Storm water cannot be discharged to a sanitary sewer.
- All work must be inspected and approved by a D.P.I. inspector before backfilling.
- If this connection is to be part of a private service shared jointly with other building owners, attach copy of Recorded Joint Maintenance Agreement.
- Permits can be issued to Industrial and/or Commercial Applicants only upon receipt and approval by the Commissioner of Public Infrastructure of required plans and supplemental information.
- In addition, a City-issued Industrial User Discharge Permit and/or a Sewer Extension/Connection Permit issued by the Commonwealth of Massachusetts D.E.P. shall be required by the City for Industrial Discharge into the sewer system.

Industrial User Discharge Permit No. Date

Comm. Mass. Sewer Conn./Ext. Permit No. Date

A Filing and Inspection Fee of \$1,500.00 plus an Entrance Fee of \$ where applicable, must accompany this application.

Bank# Sovereign Bank Check# 1756 Date 8/31/07 Receipt# 7434

Other requirements: 24 hr inspection notice at 508 979 1527 Sewer connection  
to existing service line and install smh and box culvert for drainage.  
S. Porter has issued order of conditions.

Connection made to Sewer Part of jointly-shared private line YES ☒ NO  
Storm Drain

Applicant agrees to abide by the above terms, as well as all pertinent ordinances of the City of New Bedford, and such other special rules as the Commissioner of Public Infrastructure and/or City Engineer may deem necessary.

Duarte M. Andrade  
Acting City Engineer

Signature of Property Owner or Representative  
Alan Caldwell - Project Manager

INSPECTOR'S REPORT

INSPECTED BY: \_\_\_\_\_  
DATE: \_\_\_\_\_  
COMMENTS: \_\_\_\_\_

APPROVED \_\_\_\_\_ DISAPPROVED \_\_\_\_\_

SIGNATURE

ACORN MANAGEMENT  
ALAN CALDWELL

218 Willard Street  
Quincy, MA 02169  
Tel: 617-479-2424  
Fax: 617-773-3840  
Cell: 781-589-2000

Wamsutta Jobsite  
Tel. & Fax: 508-984-5000

SKETCH PLAN



# CITY OF NEW BEDFORD MASSACHUSETTS

D.P.I. -Engineering Division

1105 Shawmut Ave.

New Bedford, Ma. 02746

Tel: 508-991-6150

Fax: 508-961-3054

Ronald Labelle  
Commissioner

Duarte M. Andrade,  
Acting City Engineer

To Whom It May Concern:

I STEPHEN RICCIARDI, P.O. BOX 690307, QUINCY, MA, 02269  
(Name) (Mailing Address) being

REPRESENTATIVE  
Owner of property located at 800 ACUSHNET AVE, N.B.

Plot 78, Lot 219, hereby agree to allow ALAN CALDWELL  
(Name)

218 WILLARD ST. QUINCY, MA. 02169, to act on my behalf including affixing my  
(Mailing Address)

signature in securing permit for:

<input checked="" type="checkbox"/>	Sewer/Drain Service Permits - \$150
<input checked="" type="checkbox"/>	Water Service Permits
<input checked="" type="checkbox"/>	Driveway Installation Permits
<input checked="" type="checkbox"/>	Sidewalk Installation Permits

I further agree to conform to, and abide by, All City rules and ask regulations applicable to the permit (s) being applied for:

Name Stephen C. Ricciardi  
Signature

218 WILLARD ST., QUINCY, MASS  
Address

8/30/07  
Date

617-828-2563 CP  
Telephone number

617-479-2924 Office



PERMIT NO.  
24003

CITY OF NEW BEDFORD  
SEWER AND/OR STORM DRAIN PERMIT

DATE 9/5/07

This certifies that permission is granted to

Stephen Ricciardi 218 Willard St Quincy MA 617 828 2563  
Property Owner Address Tel. N.E.C. Wamsutta St/  
Acushnet Ave.

To connect a sewer and/or storm drain located at Wamsutta Street (sewer)  
Storm drain in private property

Assessor's Plot 18 Lot 219 to the sewer and/or storm drain in Wamsutta St Street

To be laid in accordance with the conditions in this application and the City of New Bedford ordinances.

TYPE OF USE: ☒ RESIDENTIAL

☐ COMMERCIAL

☐ INDUSTRIAL

350 bedrooms  
FLOW 3800 CG.P.D.

If applicant other than actual property owner, attach Letter of Authorization from Property Owner.

Name Alan Caldwell Tel. 617-479-2424

Mailing Address 218 Willard Street Quincy MA 02169

The Bonded Contractor/Drain Layer authorized to perform this work is:

P.A. Landers, Inc. 351 Winter St Hanover MA 781 826 8818

Name Address Tel.

Type of Pipe Required: SDR 35 PVC

PERMIT EXPIRES ONE YEAR AFTER DATE OF ISSUE

- Requires separate connections for sewage and storm drain where applicable. Storm water cannot be discharged to a sanitary sewer.
  - All work must be inspected and approved by a D.P.I. inspector before backfilling.
  - If this connection is to be part of a private service shared jointly with other building owners, attach copy of Recorded Joint Maintenance Agreement.
  - Permits can be issued to Industrial and/or Commercial Applicants only upon receipt and approval by the Commissioner of Public Infrastructure of required plans and supplemental information.
  - In addition, a City-issued Industrial User Discharge Permit and/or a Sewer Extension/Connection Permit issued by the Commonwealth of Massachusetts D.E.P. shall be required by the City for Industrial Discharge into the sewer system.
- Industrial User Discharge Permit No. Date

Comm. Mass. Sewer Conn./Ext. Permit No. Date

A Filing and Inspection Fee of \$150.00 plus an Entrance Fee of \$ where applicable, must accompany this application.

Bank# Sovereign Bank Check# 1756 Date 8/31/07 Receipt# 7434

Other requirements: 24 hr inspection notice at 508.979.1527 Sewer connection to existing service line and install smh and box culvert for drainage.  
S. Porter has issued order of conditions

Connection made to Sewer Part of jointly-shared private line YES ☒ NO  
Storm Drain

Applicant agrees to abide by the above terms, as well as all pertinent ordinances of the City of New Bedford, and such other special rules as the Commissioner of Public Infrastructure and/or City Engineer may deem necessary.

Duarte M. Andrade Jr.  
Acting City Engineer

Signature of Property Owner or Representative  
Alan Caldwell - Project Manager


INSPECTOR'S REPORT

INSPECTED BY: \_\_\_\_\_  
DATE: \_\_\_\_\_  
COMMENTS: \_\_\_\_\_

APPROVED

DISAPPROVED

SIGNATURE

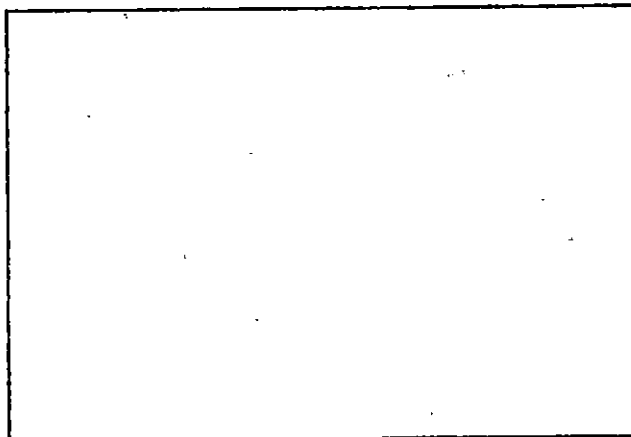

SKETCH PLAN