





Inspector's Copy

PERMIT NO.

24014

CITY OF NEW BEDFORD  
SEWER AND/OR STORM DRAIN PERMIT

DATE 10/23/07

This certifies that permission is granted to

James Miranda 239 Bonin St NB MA 02745 (508) 685-6424 Cell  
Property Owner Address Tel. (508) 995-8670 Home

To connect a sewer and/or storm drain located at 239 Bonin St.

Assessor's Plot 123B Lot 314/317 to the sewer and/or storm drain in Bonin (Stub at R.L.) Street

To be laid in accordance with the conditions in this application and the City of New Bedford ordinances.

TYPE OF USE: RESIDENTIAL COMMERCIAL INDUSTRIAL FLOW 330 G.P.D.

If applicant other than actual property owner, attach Letter of Authorization from Property Owner.

Name N/A Tel. \_\_\_\_\_

Mailing Address \_\_\_\_\_

The Bonded Contractor/Drain Layer authorized to perform this work is:

Forland Enterprises 32 Gammens Rd Acushnet 508.998.8652

Name Address Tel.

Type of Pipe Required: PVC SDR 35

PERMIT EXPIRES ONE YEAR AFTER DATE OF ISSUE

- Requires separate connections for sewage and storm drain where applicable. Storm water cannot be discharged to a sanitary sewer.
  - All work must be inspected and approved by a D.P.I. inspector before backfilling.
  - If this connection is to be part of a private service shared jointly with other building owners, attach copy of Recorded Joint Maintenance Agreement.
  - Permits can be issued to Industrial and/or Commercial Applicants only upon receipt and approval by the Commissioner of Public Infrastructure of required plans and supplemental information.
  - In addition, a City-issued Industrial User Discharge Permit and/or a Sewer Extension/Connection Permit issued by the Commonwealth of Massachusetts D.E.P. shall be required by the City for Industrial Discharge into the sewer system.
- Industrial User Discharge Permit No. N/A Date \_\_\_\_\_

Comm. Mass. Sewer Conn./Ext. Permit No. \_\_\_\_\_ Date \_\_\_\_\_

A Filing and Inspection Fee of \$ 150.00, plus an Entrance Fee of \$ 178.20 where applicable, must accompany this application.  
(22' at \$ 8.10/L.F. = \$178.20) Sewer Stub - Aviation Way

Bank# Sovereign Check# 1123 Date 10/30/07 Receipt# 7549

Other requirements: 24 Hr. Notice for Inspection (508) 991-6227; Notify Health Dept. re:

Septic system abandonment; See attached letter from Conservation Commission re:

Connection made to Sewer Part of jointly-shared private line YES NO Additional Conditions.  
Storm Drain

Applicant agrees to abide by the above terms, as well as all pertinent ordinances of the City of New Bedford, and such other special rules as the Commissioner of Public Infrastructure and/or City Engineer may deem necessary

Quarte M. Andrade-Jose  
City Engineer

James Miranda  
Signature of Property Owner or Representative

INSPECTOR'S REPORT

INSPECTED BY: Bob Bichel

DATE: 11/6/07

COMMENTS: \_\_\_\_\_

APPROVED

DISAPPROVED

Robert A. Bailey  
SIGNATURE


SKETCH PLAN

INSPECTED BY: \_\_\_\_\_  
DATE: \_\_\_\_\_  
COMMENTS: \_\_\_\_\_

APPROVED

DISAPPROVED

SIGNATURE

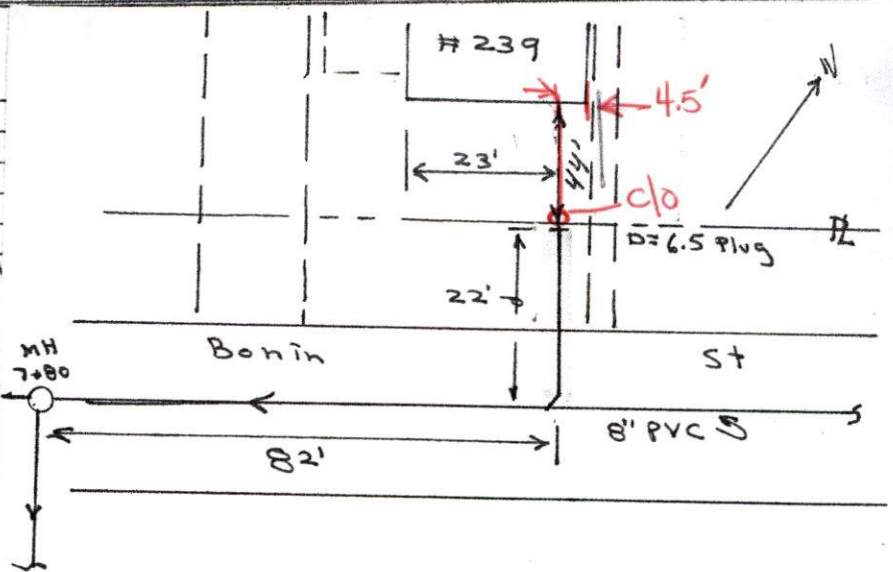



**City of New Bedford**  
Scott W. Lang, Mayor

Environmental Stewardship Department/  
New Bedford Conservation Commission

October 24, 2007

Mr. James Miranda  
239 Bonin Street  
New Bedford, MA 02745

Re: Sewer tie in  
239 Bonin St

Dear Mr. Miranda,

To follow up on our phone conversation today, the Conservation Commission is in receipt of your sewer permit application. Please be aware that your property is within the 100' Buffer Zone to Bordering Vegetated Wetlands. You are hereby granted a Conditional Approval to tie 239 Bonin St. into the City Sewer pipe located on Bonin Street provided that the abandoned system be left in place and filled in with flowable fill or similar material approved material. If dirt or any material does enter the wetland area due to the sewer tie in, it would constitute a violation of the Wetlands Protection Act and the Conservation Commission would require restoration of the wetland. Please contact me if you have questions.

Sincerely,

A handwritten signature in cursive script, appearing to read "S. E. Porter".

Sarah E. Porter  
Conservation Agent

cc: Conservation Commission, DPL-Engineering





PERMIT NO.

24014

CITY OF NEW BEDFORD  
SEWER AND/OR STORM DRAIN PERMITDATE 10/23/07

This certifies that permission is granted to

Property Owner James Miranda Address 239 Bonin St. NB MA 02745 Tel. (508) 685-6424 Cell  
(508) 995-8670 HomeTo connect a sewer and/or storm drain located at 239 Bonin St. Bonin St. (N.S.) 365' W. / Mt. Pleasant St.Assessor's Plot 123B Lot 316 + 317 to the sewer and/or storm drain in Bonin (Stub at R.L.) Street

To be laid in accordance with the conditions in this application and the City of New Bedford ordinances.

TYPE OF USE: RESIDENTIAL COMMERCIAL INDUSTRIAL FLOW 330 G.P.D.

If applicant other than actual property owner, attach Letter of Authorization from Property Owner.

Name N/A Tel. \_\_\_\_\_

Mailing Address \_\_\_\_\_

The Bonded Contractor/Drain Layer authorized to perform this work is:

Farland Enterprises 32 Gammons Rd Acushnet 508.998.8652

Name \_\_\_\_\_ Address \_\_\_\_\_ Tel. \_\_\_\_\_

Type of Pipe Required: PVC 35

## PERMIT EXPIRES ONE YEAR AFTER DATE OF ISSUE

- Requires separate connections for sewage and storm drain where applicable. Storm water cannot be discharged to a sanitary sewer.
- All work must be inspected and approved by a D.P.I. inspector before backfilling.
- If this connection is to be part of a private service shared jointly with other building owners, attach copy of Recorded Joint Maintenance Agreement.
- Permits can be issued to Industrial and/or Commercial Applicants only upon receipt and approval by the Commissioner of Public Infrastructure of required plans and supplemental information.
- In addition, a City-issued Industrial User Discharge Permit and/or a Sewer Extension/Connection Permit issued by the Commonwealth of Massachusetts D.E.P. shall be required by the City for Industrial Discharge into the sewer system.

Industrial User Discharge Permit No. N/A Date \_\_\_\_\_

Comm. Mass. Sewer Conn./Ext. Permit No. \_\_\_\_\_ Date \_\_\_\_\_

A Filing and Inspection Fee of \$ 150., plus an Entrance Fee of \$ 178.20 where applicable, must accompany this application.  
(22' at \$ 8.10/L.F. = \$178.20) Sewer Stub ~ Aviation WayBank# Sovereign Check# 1123 Date 10/30/07 Receipt# 7549Other requirements: 24 Hr. Notice for Inspection (508) 991-6229; Notify Health Dept. re:Septic system abandonment; See attached letter from Conservation Commission re:Connection made to Sewer Part of jointly-shared private line YES NO Additional Conditions.

Applicant agrees to abide by the above terms, as well as all pertinent ordinances of the City of New Bedford, and such other special rules as the Commissioner of Public Infrastructure and/or City Engineer may deem necessary

Quante M. Oliveira-Jose  
City EngineerJames Miranda  
Signature of Property Owner or Representative

## INSPECTOR'S REPORT

INSPECTED BY: \_\_\_\_\_


DATE: \_\_\_\_\_

COMMENTS: \_\_\_\_\_

APPROVED

DISAPPROVED

SIGNATURE

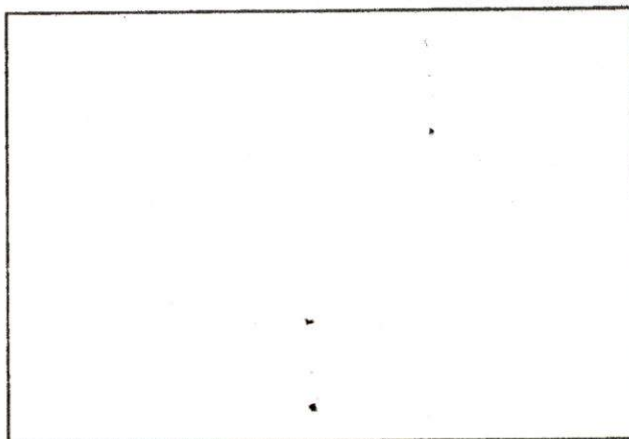

SKETCH PLAN



**City of New Bedford**  
Scott W. Lang, Mayor

Environmental Stewardship Department/  
New Bedford Conservation Commission

October 24, 2007

Mr. James Miranda  
239 Bonin Street  
New Bedford, MA 02745

Re: Sewer tie in  
239 Bonin St

Dear Mr. Miranda,

To follow up on our phone conversation today, the Conservation Commission is in receipt of your sewer permit application. Please be aware that your property is within the 100' Buffer Zone to Bordering Vegetated Wetlands. You are hereby granted a Conditional Approval to tie 239 Bonin St. into the City Sewer pipe located on Bonin Street provided that the abandoned system be left in place and filled in with flowable fill or similar material approved material. If dirt or any material does enter the wetland area due to the sewer tie in, it would constitute a violation of the Wetlands Protection Act and the Conservation Commission would require restoration of the wetland. Please contact me if you have questions.

Sincerely,

A handwritten signature in cursive script, appearing to read "S. E. Porter".

Sarah E. Porter  
Conservation Agent

cc: Conservation Commission, DPL-Engineering



**City of New Bedford**  
Scott W. Lang, Mayor

Environmental Stewardship Department/  
New Bedford Conservation Commission

10/24/07

Date: Ana

Fax To: 508-991-6152

**Fax Number:**

**FROM:** Sarah Porter *SP*

Number of Pages (including cover sheet) 2

I will mail this to  
Mr. Miranda too  
*Thanks JP*

TRANSMISSION VERIFICATION REPORT

TIME : 11/02/2007 09:38  
NAME : DPI WATER WASTEWATER  
FAX : 5089916152  
TEL : 5089916152

DATE, TIME	11/02 09:37
FAX NO./NAME	3143
DURATION	00:00:51
PAGE(S)	01
RESULT	OK
MODE	STANDARD ECM

*Sent Sewer Permit # 24014 to  
Health.*