



PERMIT NO.

24017

CITY OF NEW BEDFORD
SEWER AND/OR STORM DRAIN PERMIT

DATE 10/29/07

This certifies that permission is granted to

Property Owner Seven Hills Foundation Address 81 Hope Ave. Worcester, Ma Tel. 508 755 2340

To connect a sewer and/or storm drain located at relocating the sewer pump and pipe

Assessor's Plot 21 Lot 50, to the sewer and/or storm drain in private property Street

To be laid in accordance with the conditions in this application and the City of New Bedford ordinances.

TYPE OF USE: RESIDENTIAL COMMERCIAL INDUSTRIAL FLOW G.P.D.
Social Service Related

If applicant other than actual property owner, attach Letter of Authorization from Property Owner.

Name Carlos Pacheco Tel. 508 716 38057

Mailing Address 409 New Bedford Rd. Rochester

The Bonded Contractor/Drain Layer authorized to perform this work is:

P.C.C. Corp 409 New Bedford Rd. Rochester, Ma

Name Address Tel.

Type of Pipe Required: same as existing 508 716 38057

PERMIT EXPIRES ONE YEAR AFTER DATE OF ISSUE

- Requires separate connections for sewage and storm drain where applicable. Storm water cannot be discharged to a sanitary sewer.
- All work must be inspected and approved by a D.P.I. inspector before backfilling.
- If this connection is to be part of a private service shared jointly with other building owners, attach copy of Recorded Joint Maintenance Agreement.
- Permits can be issued to Industrial and/or Commercial Applicants only upon receipt and approval by the Commissioner of Public Infrastructure of required plans and supplemental information.
- In addition, a City-issued Industrial User Discharge Permit and/or a Sewer Extension/Connection Permit issued by the Commonwealth of Massachusetts D.E.P. shall be required by the City for Industrial Discharge into the sewer system.

Industrial User Discharge Permit No. Date

Comm. Mass. Sewer Conn./Ext. Permit No. Date

A Filing and Inspection Fee of \$150.00 plus an Entrance Fee of \$ where applicable, must accompany this application.

Bank# Sovereign Check# 364 Date 10/29/07 Receipt# 7550

Other requirements: inspection only - relocating 6" sewer and pump
30 ft ± on private property

Connection made to Sewer Part of jointly-shared private line YES ☒ NO

Storm Drain

Applicant agrees to abide by the above terms, as well as all pertinent ordinances of the City of New Bedford, and such other special rules as the Commissioner of Public Infrastructure and/or City Engineer may deem necessary

Quate M. Andrade
Acting City Engineer

[Signature]
Signature of Property Owner or Representative

INSPECTOR'S REPORT

INSPECTED BY: Bob Bichel

DATE: 11/29/2007


COMMENTS:

☒ APPROVED

☐ DISAPPROVED

SIGNATURE

See attached.

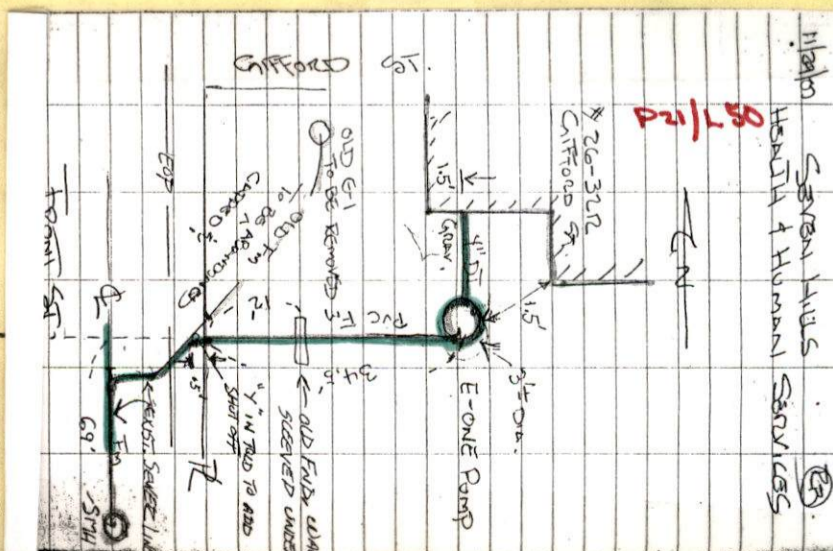



PERMIT NO.
24017

CITY OF NEW BEDFORD
SEWER AND/OR STORM DRAIN PERMIT

DATE 10/29/07

This certifies that permission is granted to

Seven Hills Foundation
Center for Health and Human Services 81 Hope Ave. Worcester, Ma
Property Owner Address 24-32 R Gifford St. Tel. 508 755 2340

To connect a sewer and/or storm drain located at relocating the sewer pump and pipe.

Assessor's Plot 21 Lot 50, to the sewer and/or storm drain in private property Street

To be laid in accordance with the conditions in this application and the City of New Bedford ordinances.

TYPE OF USE: RESIDENTIAL COMMERCIAL INDUSTRIAL FLOW G.P.D.
Social Service Related

If applicant other than actual property owner, attach Letter of Authorization from Property Owner.

Name Carlos Pacheco Tel. 508 763 8057
Mailing Address 409 New Bedford Rd. Rochester

The Bonded Contractor/Drain Layer authorized to perform this work is:

P.C.C. Corp. 409 New Bedford Rd. Rochester, Ma
Name Address Tel.
Type of Pipe Required: same as existing 508 763 8057

PERMIT EXPIRES ONE YEAR AFTER DATE OF ISSUE

- Requires separate connections for sewage and storm drain where applicable. Storm water cannot be discharged to a sanitary sewer.
- All work must be inspected and approved by a D.P.I. inspector before backfilling.
- If this connection is to be part of a private service shared jointly with other building owners, attach copy of Recorded Joint Maintenance Agreement.
- Permits can be issued to Industrial and/or Commercial Applicants only upon receipt and approval by the Commissioner of Public Infrastructure of required plans and supplemental information.
- In addition, a City-issued Industrial User Discharge Permit and/or a Sewer Extension/Connection Permit issued by the Commonwealth of Massachusetts D.E.P. shall be required by the City for Industrial Discharge into the sewer system.

Industrial User Discharge Permit No. Date

Comm. Mass. Sewer Conn./Ext. Permit No. Date

A Filing and Inspection Fee of \$150.00 plus an Entrance Fee of \$ where applicable, must accompany this application.

Bank# Sovereign Check# 364 Date 10/29/07 Receipt# 7550

Other requirements: inspection only - relocating 4" sewer and pump
30 ft ± on private property
Sewer

Connection made to Part of jointly-shared private line YES (NO)
Storm Drain

Applicant agrees to abide by the above terms, as well as all pertinent ordinances of the City of New Bedford, and such other special rules as the Commissioner of Public Infrastructure and/or City Engineer may deem necessary

Quarte M. Andrade
Acting City Engineer mn


Signature of Property Owner or Representative
PCC Corp

INSPECTOR'S REPORT

INSPECTED BY:
DATE:
COMMENTS:

APPROVED DISAPPROVED

SIGNATURE

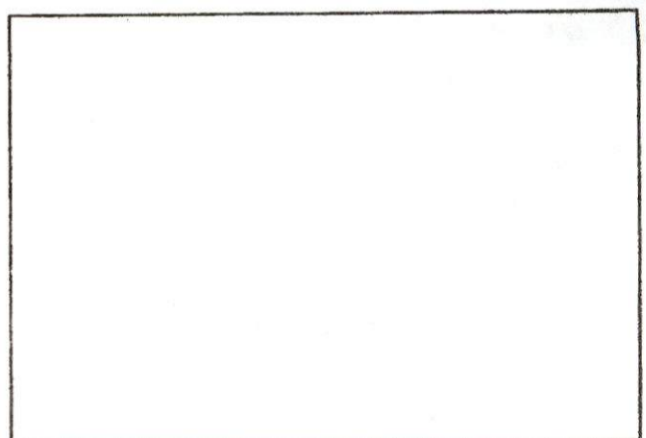

SKETCH PLAN



CITY OF NEW BEDFORD MASSACHUSETTS

D.P.I. -Engineering Division

1105 Shawmut Ave.

New Bedford, Ma. 02746

Tel: 508-991-6150

Fax: 508-961-3054

Ronald Labelle
Commissioner

Duarte M. Andrade,
Acting City Engineer

To Whom It May Concern:

I Seven Hills Foundation 26-32R (same as below), being
(Name) (Mailing Address)

Owner of property located at 26-32R Gifford St New Bedford MA.

Plot 21, Lot 50, hereby agree to allow P.C.C. Corp. (Carlos Pulanicos)
(Name)

409 New Bedford Rd. Rochester MA 02770 to act on my behalf including affixing my
(Mailing Address)

signature in securing permit for:

☒ Sewer/Drain Service Permits
☒ Water Service Permits
☐ Driveway Installation Permits
☐ Sidewalk Installation Permits

I further agree to conform to, and abide by, All City rules and ask regulations applicable to the permit (s) being applied for:

Center for Health
and Human
Services

Name Reinal Marth construction MANAGER
Signature

81 HOPE AVE WORCESTER, MA.
Address

10-22-07
Date

508 755-2340 x 501
Telephone number



CITY OF NEW BEDFORD

1000

No. 204107

LICENSE NO. _____

DATE 10/22/07 20__

FOUNDATION PERMIT

MSBC Sect. 111.8 - Any permit issued shall be deemed abandoned and invalid unless the work authorized by it shall have been commenced within six (6) months after its issuance.

This certifies that R.P. MASIBELLO / RICHARD MONAHAN, owner/contractor
has permission to INSTALL FOUNDATION (AT OWN RISK - SUBJECT TO REQUIRED VARIANCE)
on 26-32R GIFFORD ST

providing that the person accepting this permit shall in every respect conform to the terms of the application therefor on file in this office; to the provisions of the Statute of the Commonwealth and to the By-Laws of the City of New Bedford relating to the Inspection, Erection, Enlarging, Altering, Raising, Moving, Repairing or Tearing Down of a Building.

WIRING INSPECTOR

PLUMBING INSPECTOR

BUILDING INSPECTOR

ROUGH FINISH

YOUR AREA INSPECTOR IS: _____

- Tel. 979-1540 Between 8:00 AM - 9:00 AM

NOTICE: NOTIFY INSPECTOR 48 HOURS
IN ADVANCE OF APPLYING
SHEATING OR LATHING

OCCUPANCY PERMIT REQUIRED BEFORE OCCUPANCY

No Building or Structure shall be used or occupied until the Certificate of Use and Occupancy shall have been issued by the Building Commissioner - MSBC. Sect. 120.1 - N.B. Zoning Ord. Sect. 9-269

THIS CARD MUST BE DISPLAYED IN A CONSPICUOUS PLACE ON THE PREMISES
AND NOT TORN DOWN OR REMOVED UNTIL COMPLETION OF WORK

SUBJECT TO MASSACHUSETTS STATE
BUILDING CODE REQUIREMENTS

BUILDING INSPECTOR



Inspector's Copy

PERMIT NO.

24017

CITY OF NEW BEDFORD
SEWER AND/OR STORM DRAIN PERMIT

DATE 10/29/07

This certifies that permission is granted to

Seven Hills Foundation
Center for Health and Human Services 81 Hope Ave. Worcester, Ma
Property Owner Address 24-32 R Gifford St. Tel. 508 755 2340

To connect a sewer and/or storm drain located at relocating the sewer pump and pipe.

Assessor's Plot 21 Lot 50, to the sewer and/or storm drain in private property Street

To be laid in accordance with the conditions in this application and the City of New Bedford ordinances.

TYPE OF USE: RESIDENTIAL COMMERCIAL INDUSTRIAL FLOW G.P.D.
Social Service Related

If applicant other than actual property owner, attach Letter of Authorization from Property Owner.

Name Carlos Pacheco Tel. 508 763 8057

Mailing Address 409 New Bedford Rd. Rochester

The Bonded Contractor/Drain Layer authorized to perform this work is:

P.C.C. Corp. 409 New Bedford Rd. Rochester, Ma

Name Address Tel.

Type of Pipe Required: same as existing 508 763 8057

PERMIT EXPIRES ONE YEAR AFTER DATE OF ISSUE

- Requires separate connections for sewage and storm drain where applicable. Storm water cannot be discharged to a sanitary sewer.
- All work must be inspected and approved by a D.P.I. inspector before backfilling.
- If this connection is to be part of a private service shared jointly with other building owners, attach copy of Recorded Joint Maintenance Agreement.
- Permits can be issued to Industrial and/or Commercial Applicants only upon receipt and approval by the Commissioner of Public Infrastructure of required plans and supplemental information.
- In addition, a City-issued Industrial User Discharge Permit and/or a Sewer Extension/Connection Permit issued by the Commonwealth of Massachusetts D.E.P. shall be required by the City for Industrial Discharge into the sewer system.

Industrial User Discharge Permit No. Date

Comm. Mass. Sewer Conn./Ext. Permit No. Date

A Filing and Inspection Fee of \$150.00 plus an Entrance Fee of \$ where applicable, must accompany this application.

Bank# Sovereign Check# 364 Date 10/29/07 Receipt# 7550

Other requirements: inspection only - relocating 4" sewer and pump

30 ft ± on private property

Connection made to Sewer Part of jointly-shared private line YES NO

Storm Drain

Applicant agrees to abide by the above terms, as well as all pertinent ordinances of the City of New Bedford, and such other special rules as the Commissioner of Public Infrastructure and/or City Engineer may deem necessary

Quante M. Andrade Acting City Engineer
Signature of Property Owner or Representative

INSPECTOR'S REPORT

INSPECTED BY: Bob Bichel

DATE: 11/29/07

COMMENTS:

APPROVED

DISAPPROVED

SIGNATURE

8:30 Thursday


11/29/07

pump station insp.

Rec'd 11/30/07.

SKETCH PLAN

Cloudy 45°
 11/29/07
 SEVEN HILLS
 HEALTH & HUMAN SERVICES
 (EF)

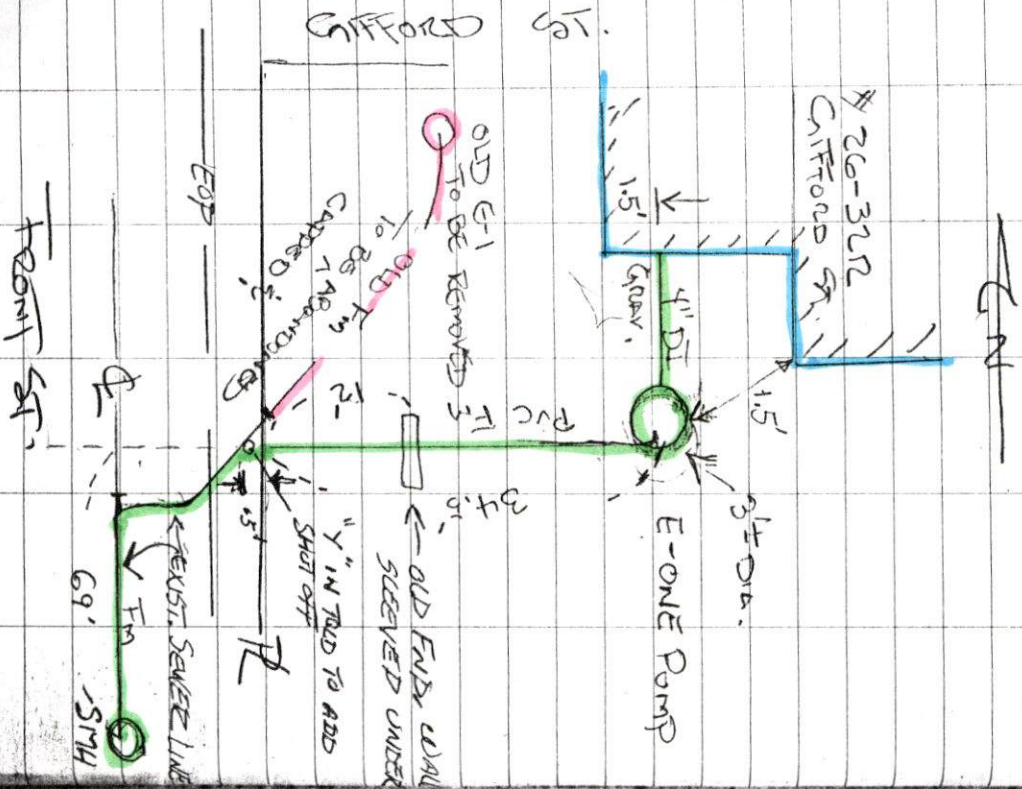

SEWER RELOCATION
 MAP 21 LOT 50
 SEWER PERMIT # 24017
 CONTRACTOR: PCC CORP.
 PROJECTED MA.
 508-763-8051

Rec'd 11/30/07